

FIELD MAP SHEET

AUG 19 1981

WATER RESOURCES DEPT
SALEM, OREGON

T. 39 S
40 S R. 17 E Sec. _____ Subdiv. _____ N.F.


Mapped by _____ Reviewed by _____ Scale 2 inches = 1 Mile

● RESERVIOR
— DRAINAGE
— ROAD

Application No. R-62534

Permit No. R 9132

19

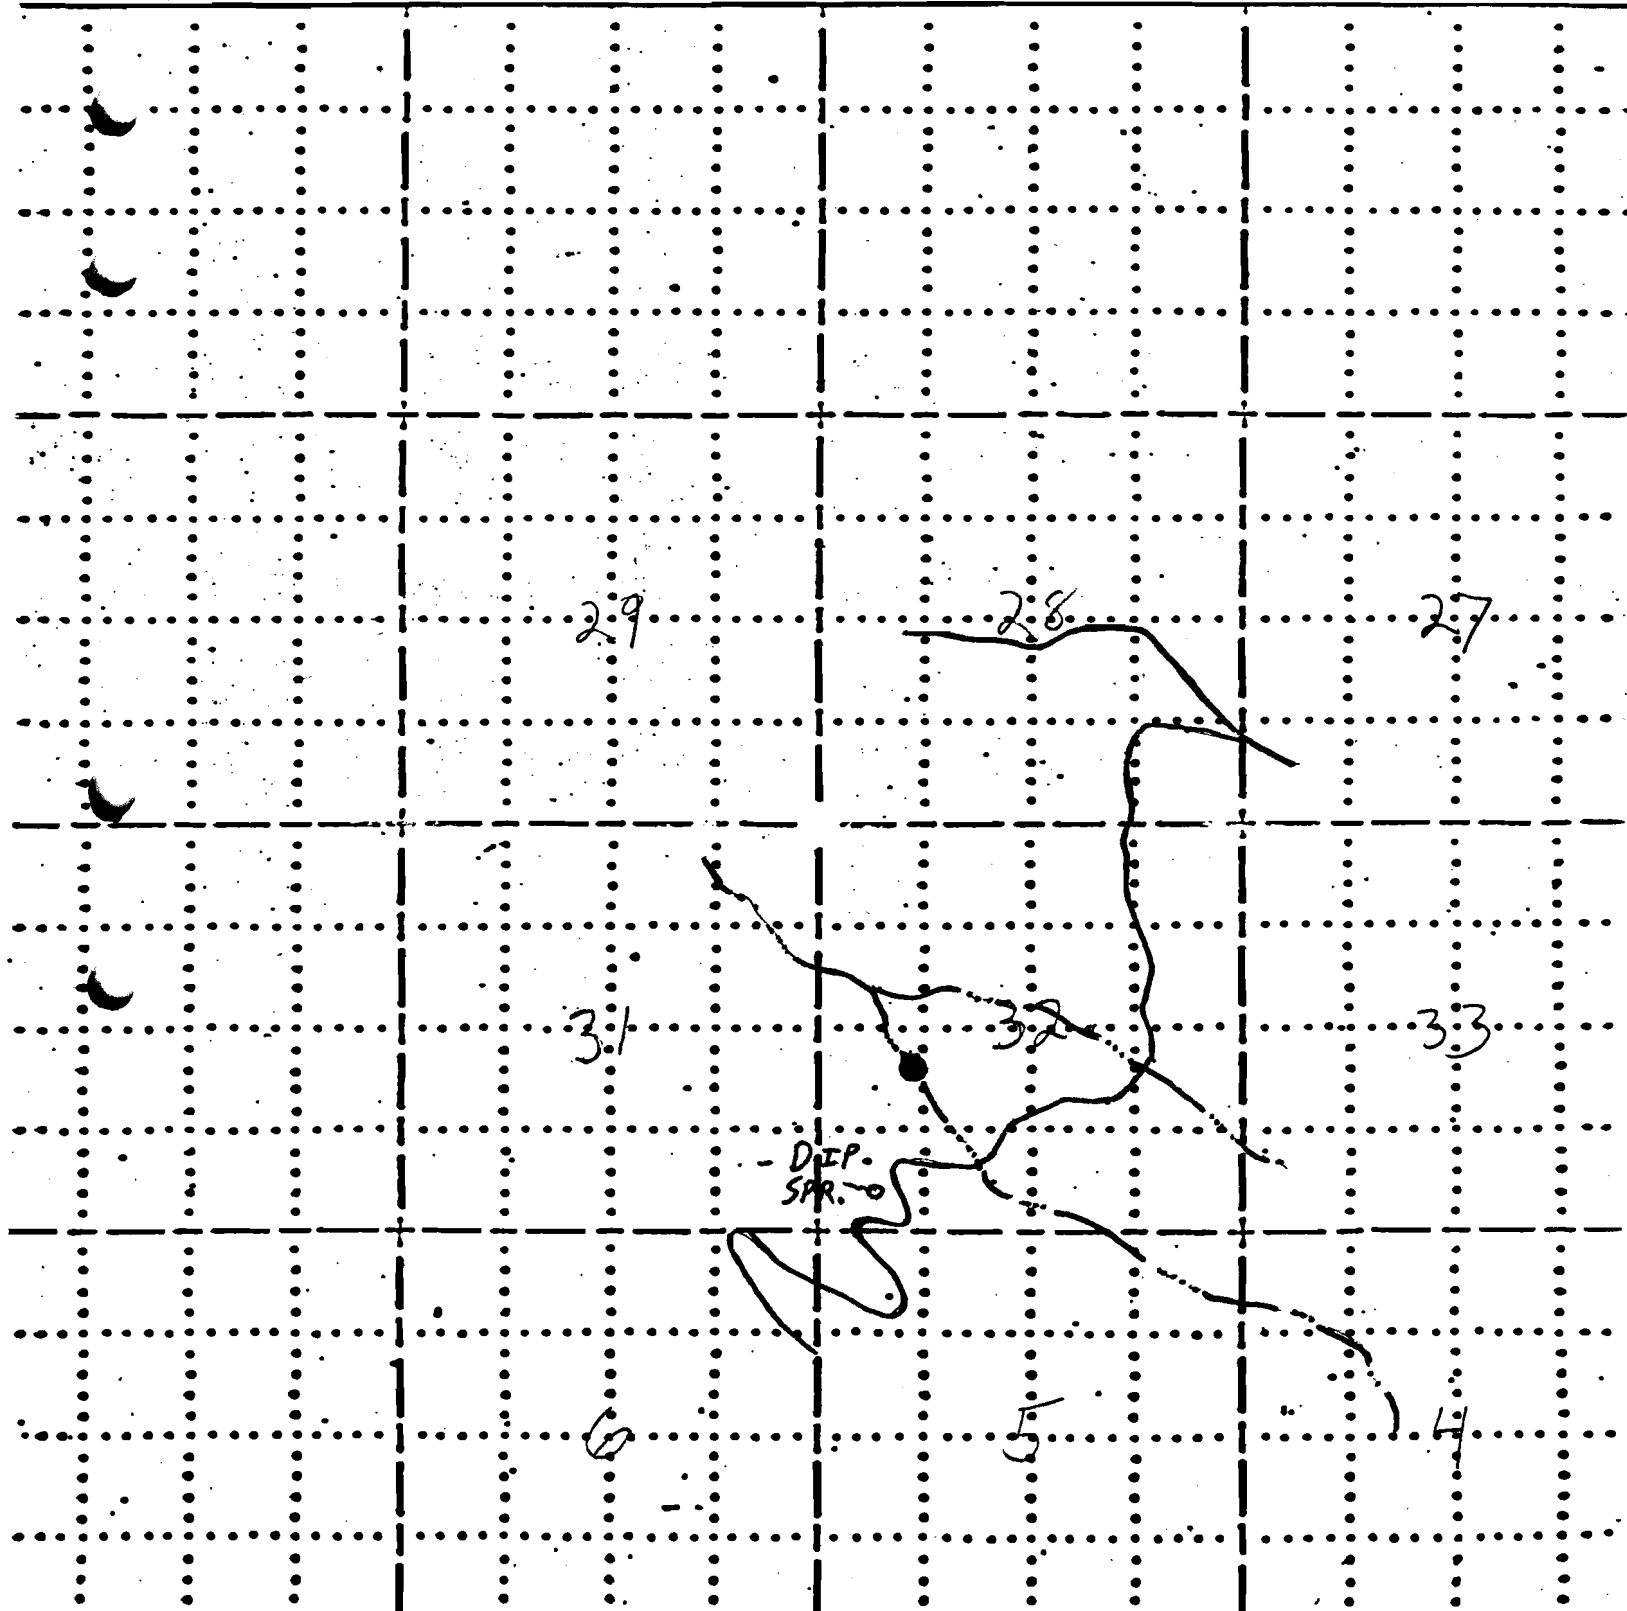

RECEIVED

AUG 19 1961

WATER RESOURCES DEPT
SALEM, OREGON

39 17 32

Application No. R-62534
Permit No. R-9132

