

RECEIVED

59220

AUG 19 1981

WATER RESOURCES DEPT
SALEM, OREGON


FIELD MAP SHEET

T. 39.5 R. 16. F Sec. Subdiv. N.F.

Mapped by Reviewed by Scale 2 inches = 1 Mile

Application No. R-62535

Permit No. R 9133

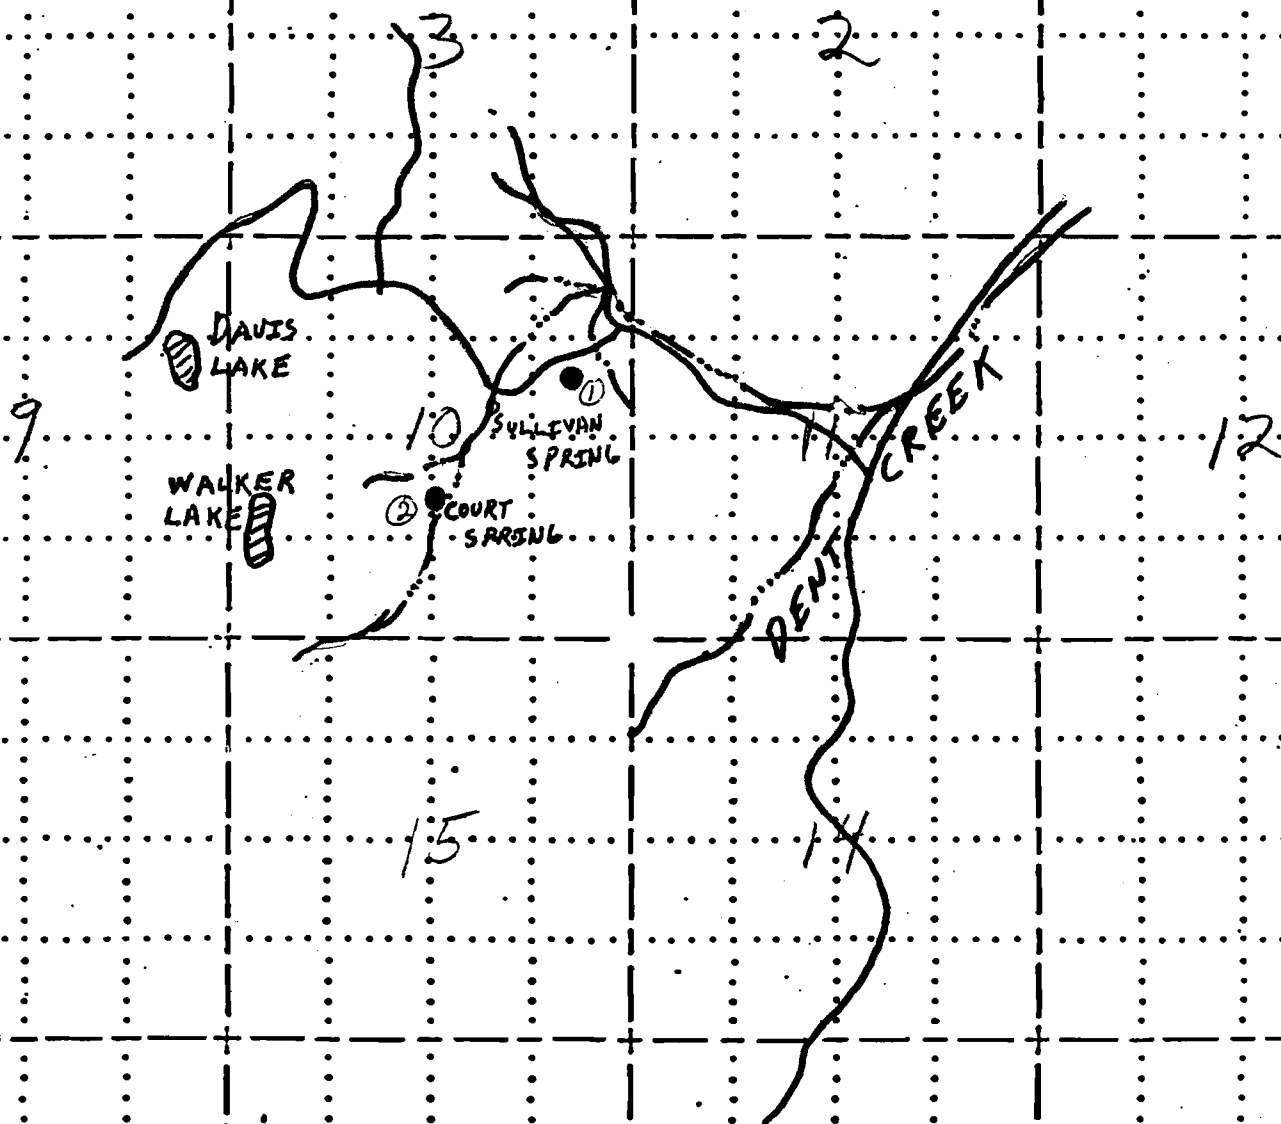

RECEIVED

AUG 19 1981

WATER RESOURCES DEPT
SALEM, OREGON

Application No. R-62535
Permit No. 2 R 9133

Secret

Valley

Red Rock Spring

Holmes Meadow

Mountain

