

AUG 19 1981

WATER RESOURCES DEPT
SALEM, OREGON

FIELD MAP SHEET

T. 39S R. 16E Sec. _____ Subdiv. _____ N.F.


Mapped by _____ Reviewed by _____ Scale 2 inches = 1 Mile

- RESERVOIR
- DRAINAGE
- ROAD

Application No. R-62536

Permit No. R 9134

, 19

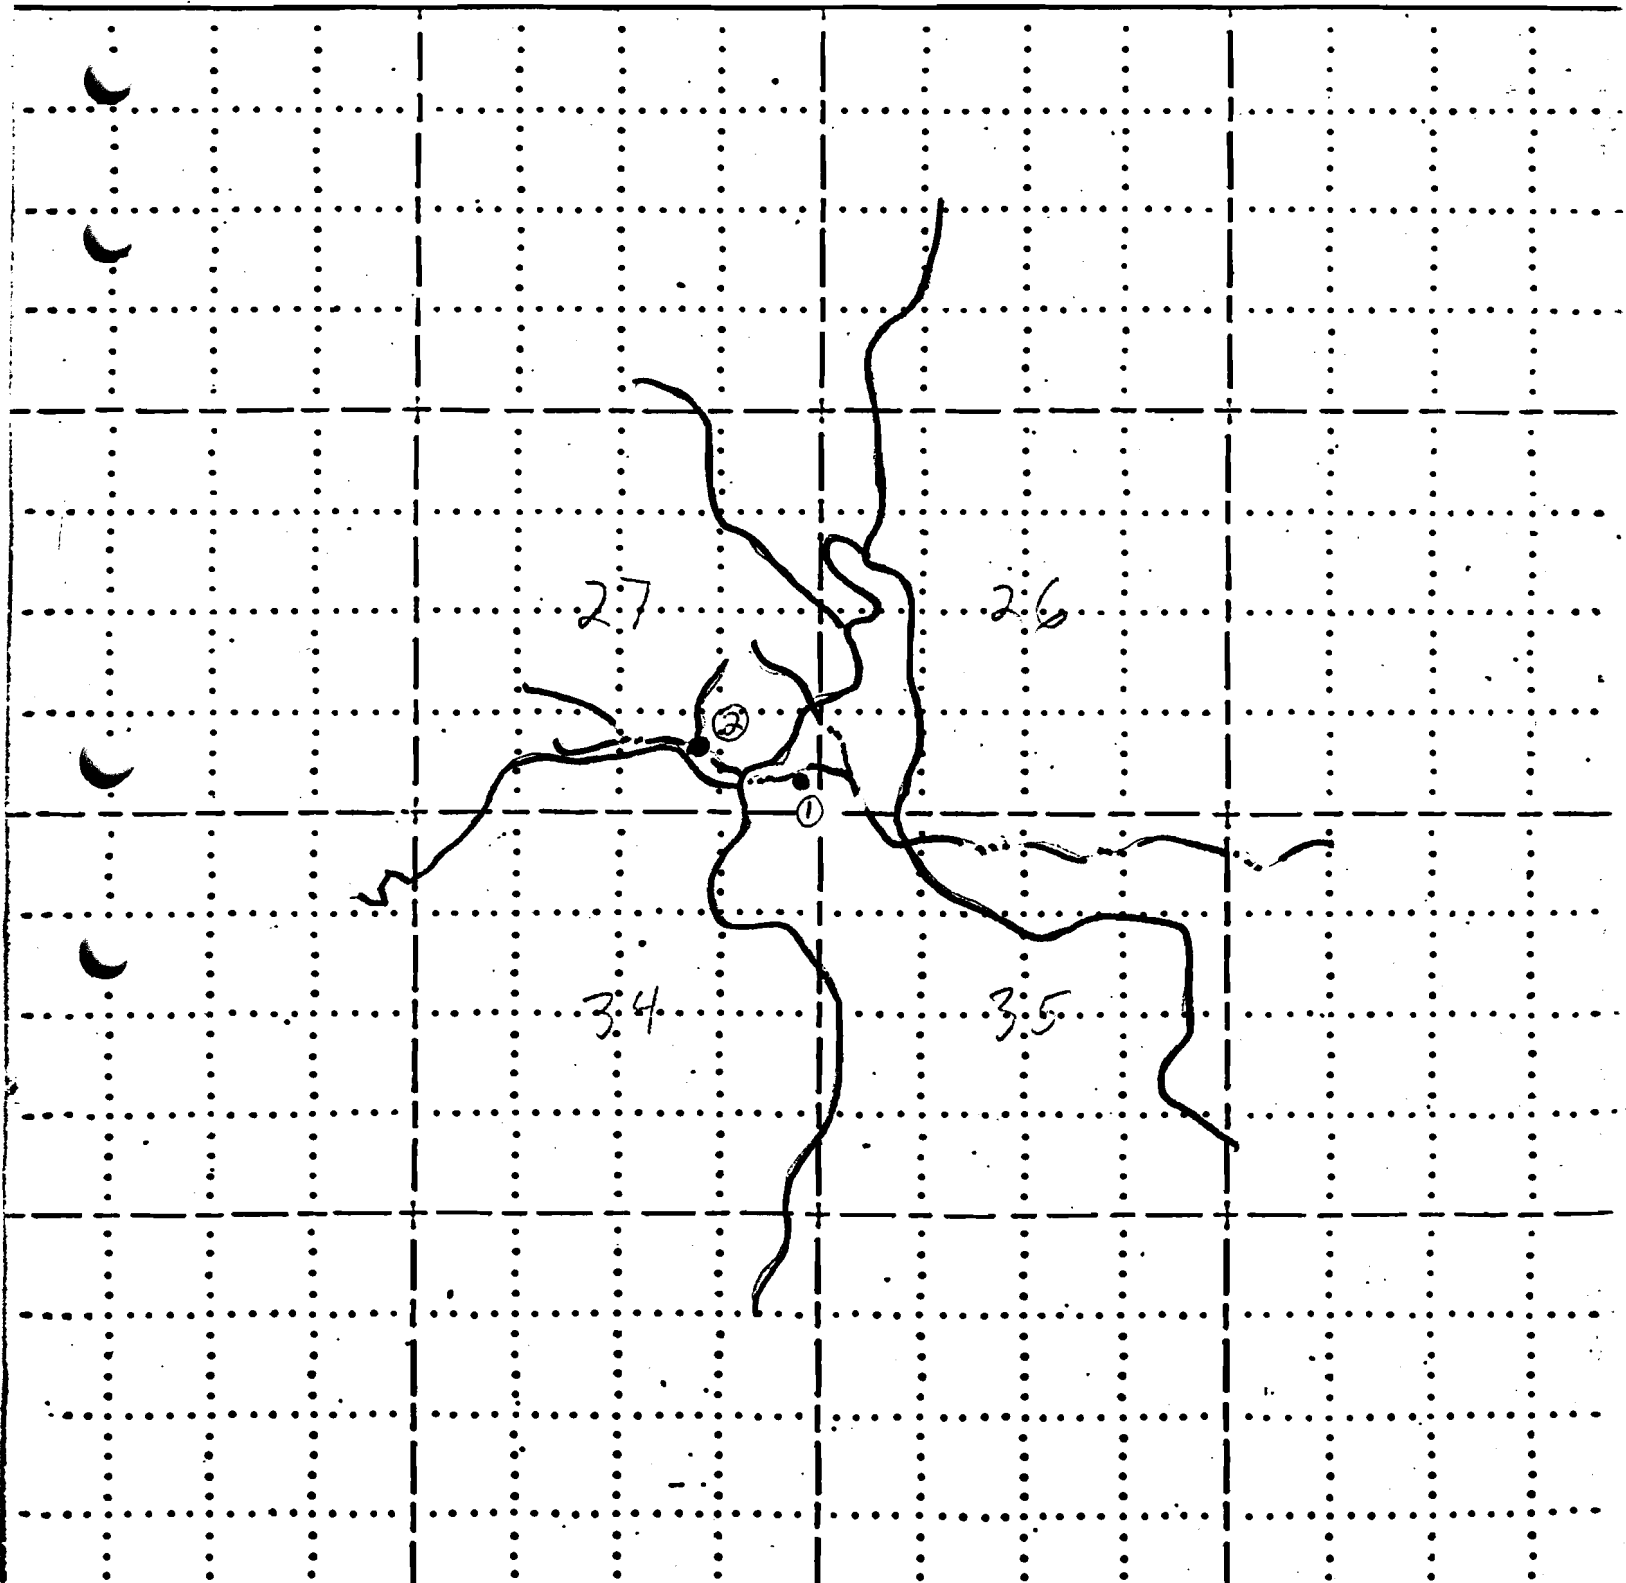

RECEIVED

APG 1-9 1981

WATER RESOURCES DEPT
SALEM, OREGON

39 16 27

Application No. *R-2536*
Permit No. *R-9134*

