

FIELD MAP SHEET

T. 39S R. 17E Sec. \_\_\_\_\_ Subdiv. \_\_\_\_\_ N.F.


Mapped by \_\_\_\_\_ Reviewed by \_\_\_\_\_ Scale 2 inches = 1 Mile

● RESERVOIR  
— DRAINAGE

Application No. R-62537

Permit No. R 9135


Drains  
River

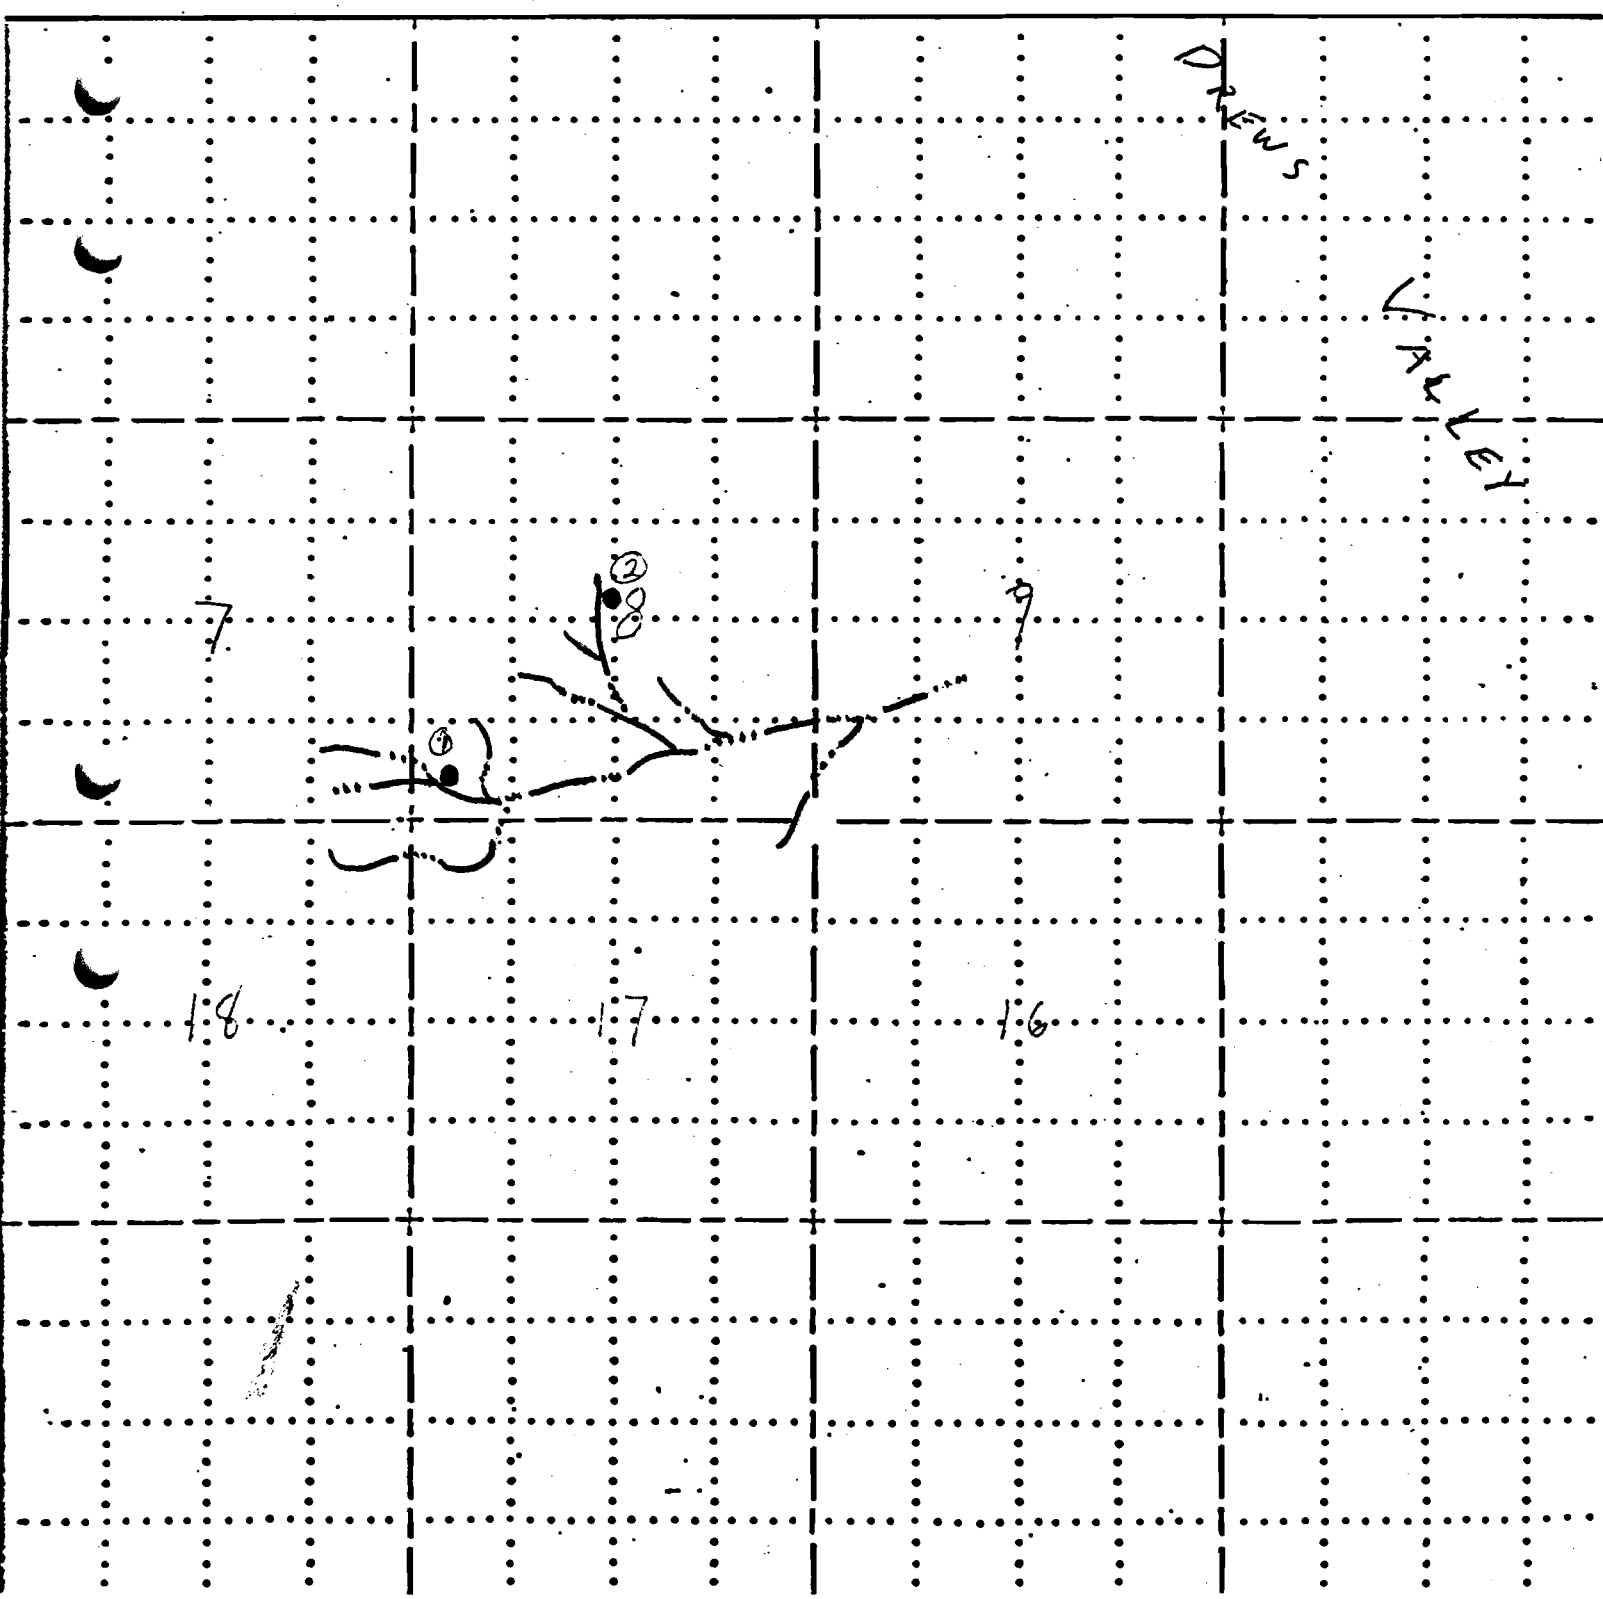

RECEIVED




AUG 19 1981

WATER RESOURCES DEPT  
SALEM, OREGON

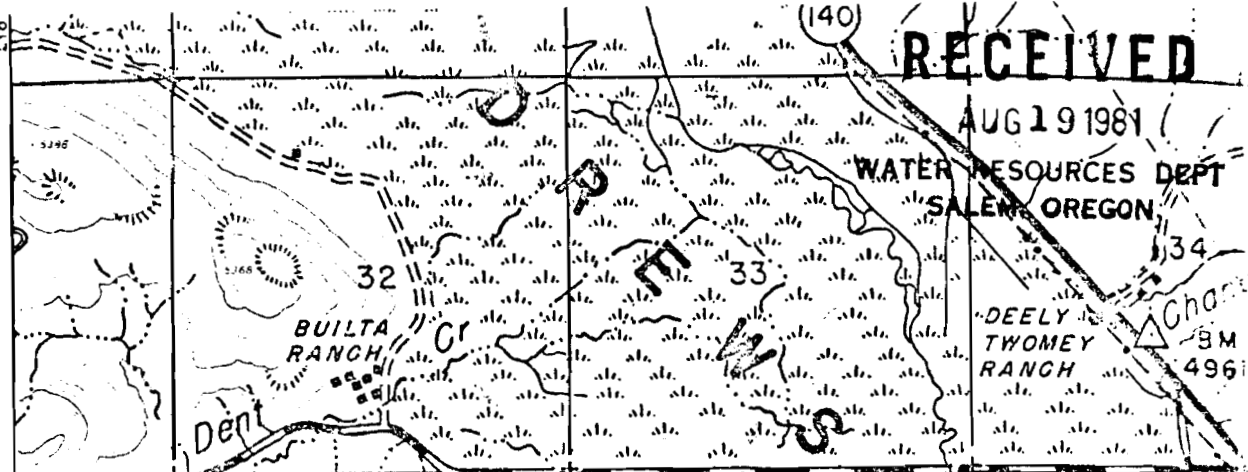


T. 38 1/2 S.

Application No. R-62537  
Permit No. R 9135

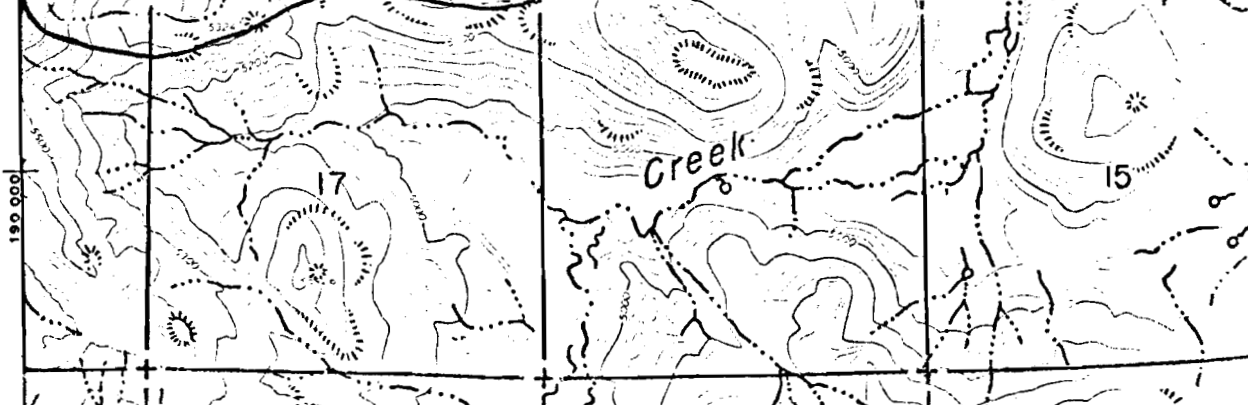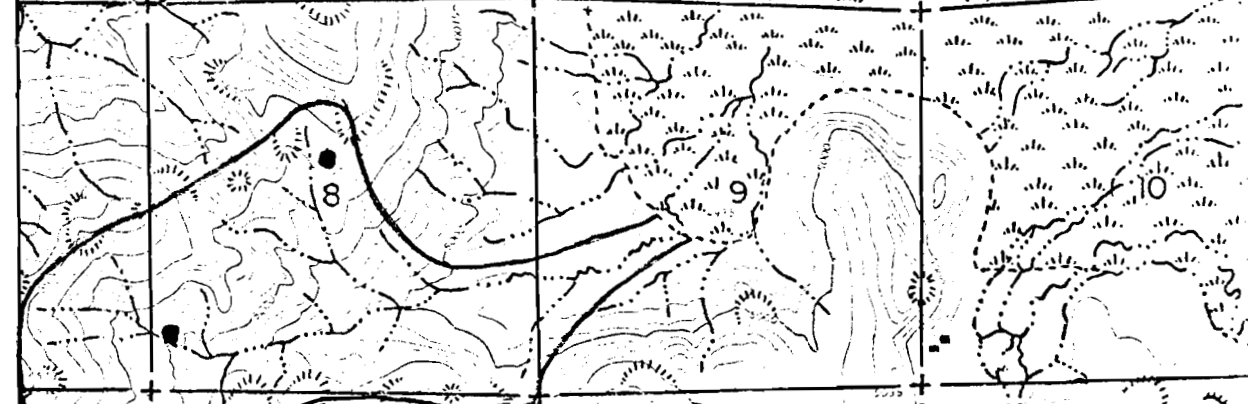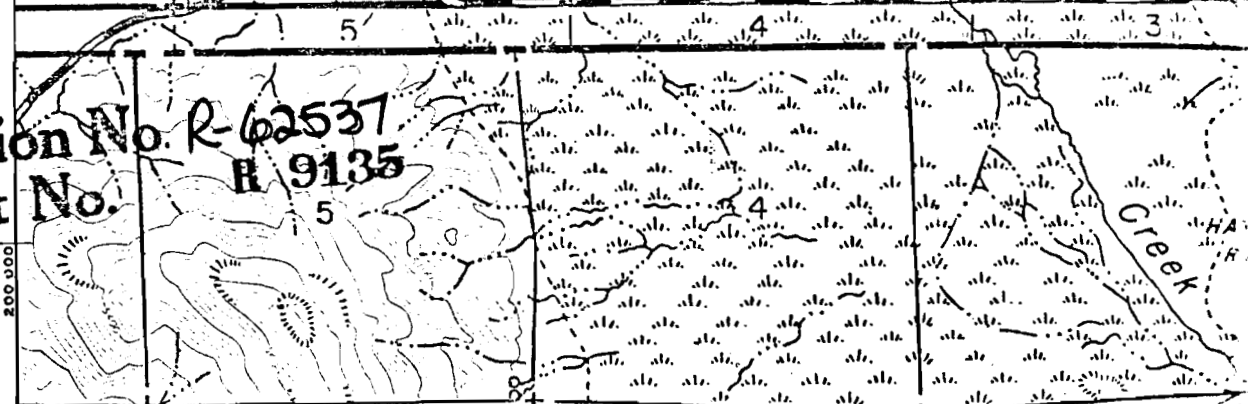

T. 39 S.

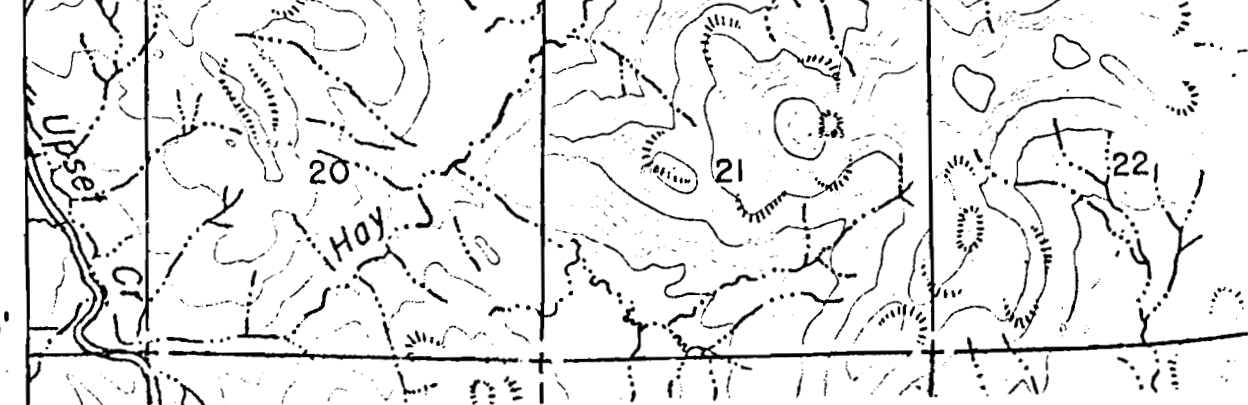

10'