

AUG 19 1981


FIELD MAP SHEET WATER RESOURCES DEPT
SALEM, OREGON

T. 37 S R. 18 E Sec. _____ Subdiv. _____ N.F. _____

Mapped by _____ Reviewed by _____ Scale 2 inches = 1 Mile

- RESERVOIR
- DRAINAGE
- ROAD

Application No. R-62540, 19
Permit No. R 9137

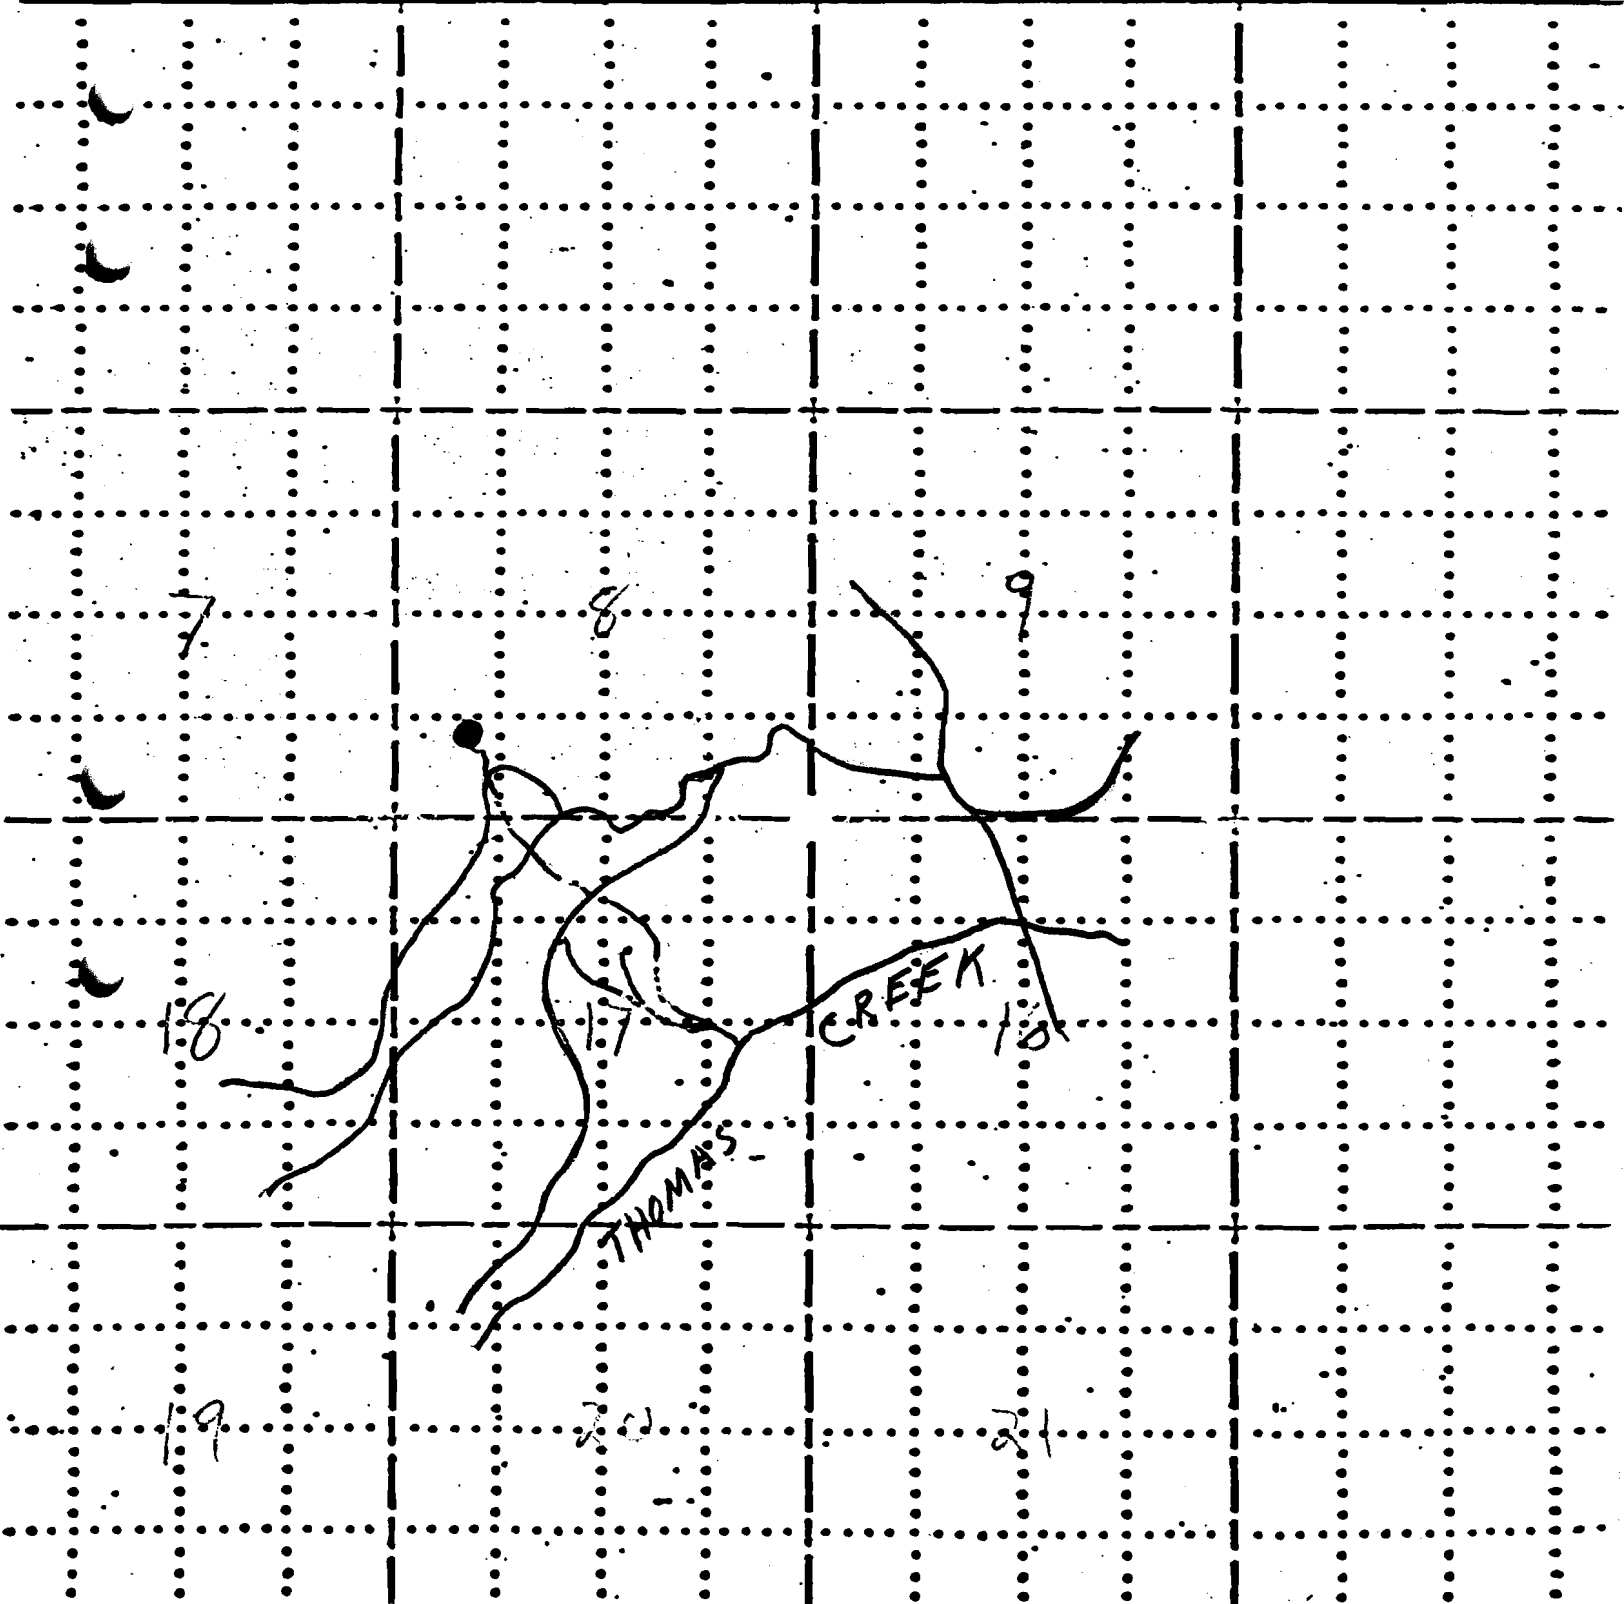

RECEIVED

AUG 19 1981

WATER RESOURCES DEPT
SALEM, OREGON

Shoestring
Spr
Creek

Dicks
Pond

Snag
Spr

THOMAS
CREEK W.C.

Application No. R-62540
Permit No. R-9137

