

RECEIVED 59224

AUG 19 1981

WATER RESOURCES DEPT
SALEM, OREGON

FIELD MAP SHEET

T. 37S R. 17E/18E Sec. Subdiv. N.F.


Mapped by Reviewed by Scale 2 inches = 1 Mile

- RESERVOIR
- DRAINAGE
- ROAD

Application No. R-62541

Permit No. R 9138

19

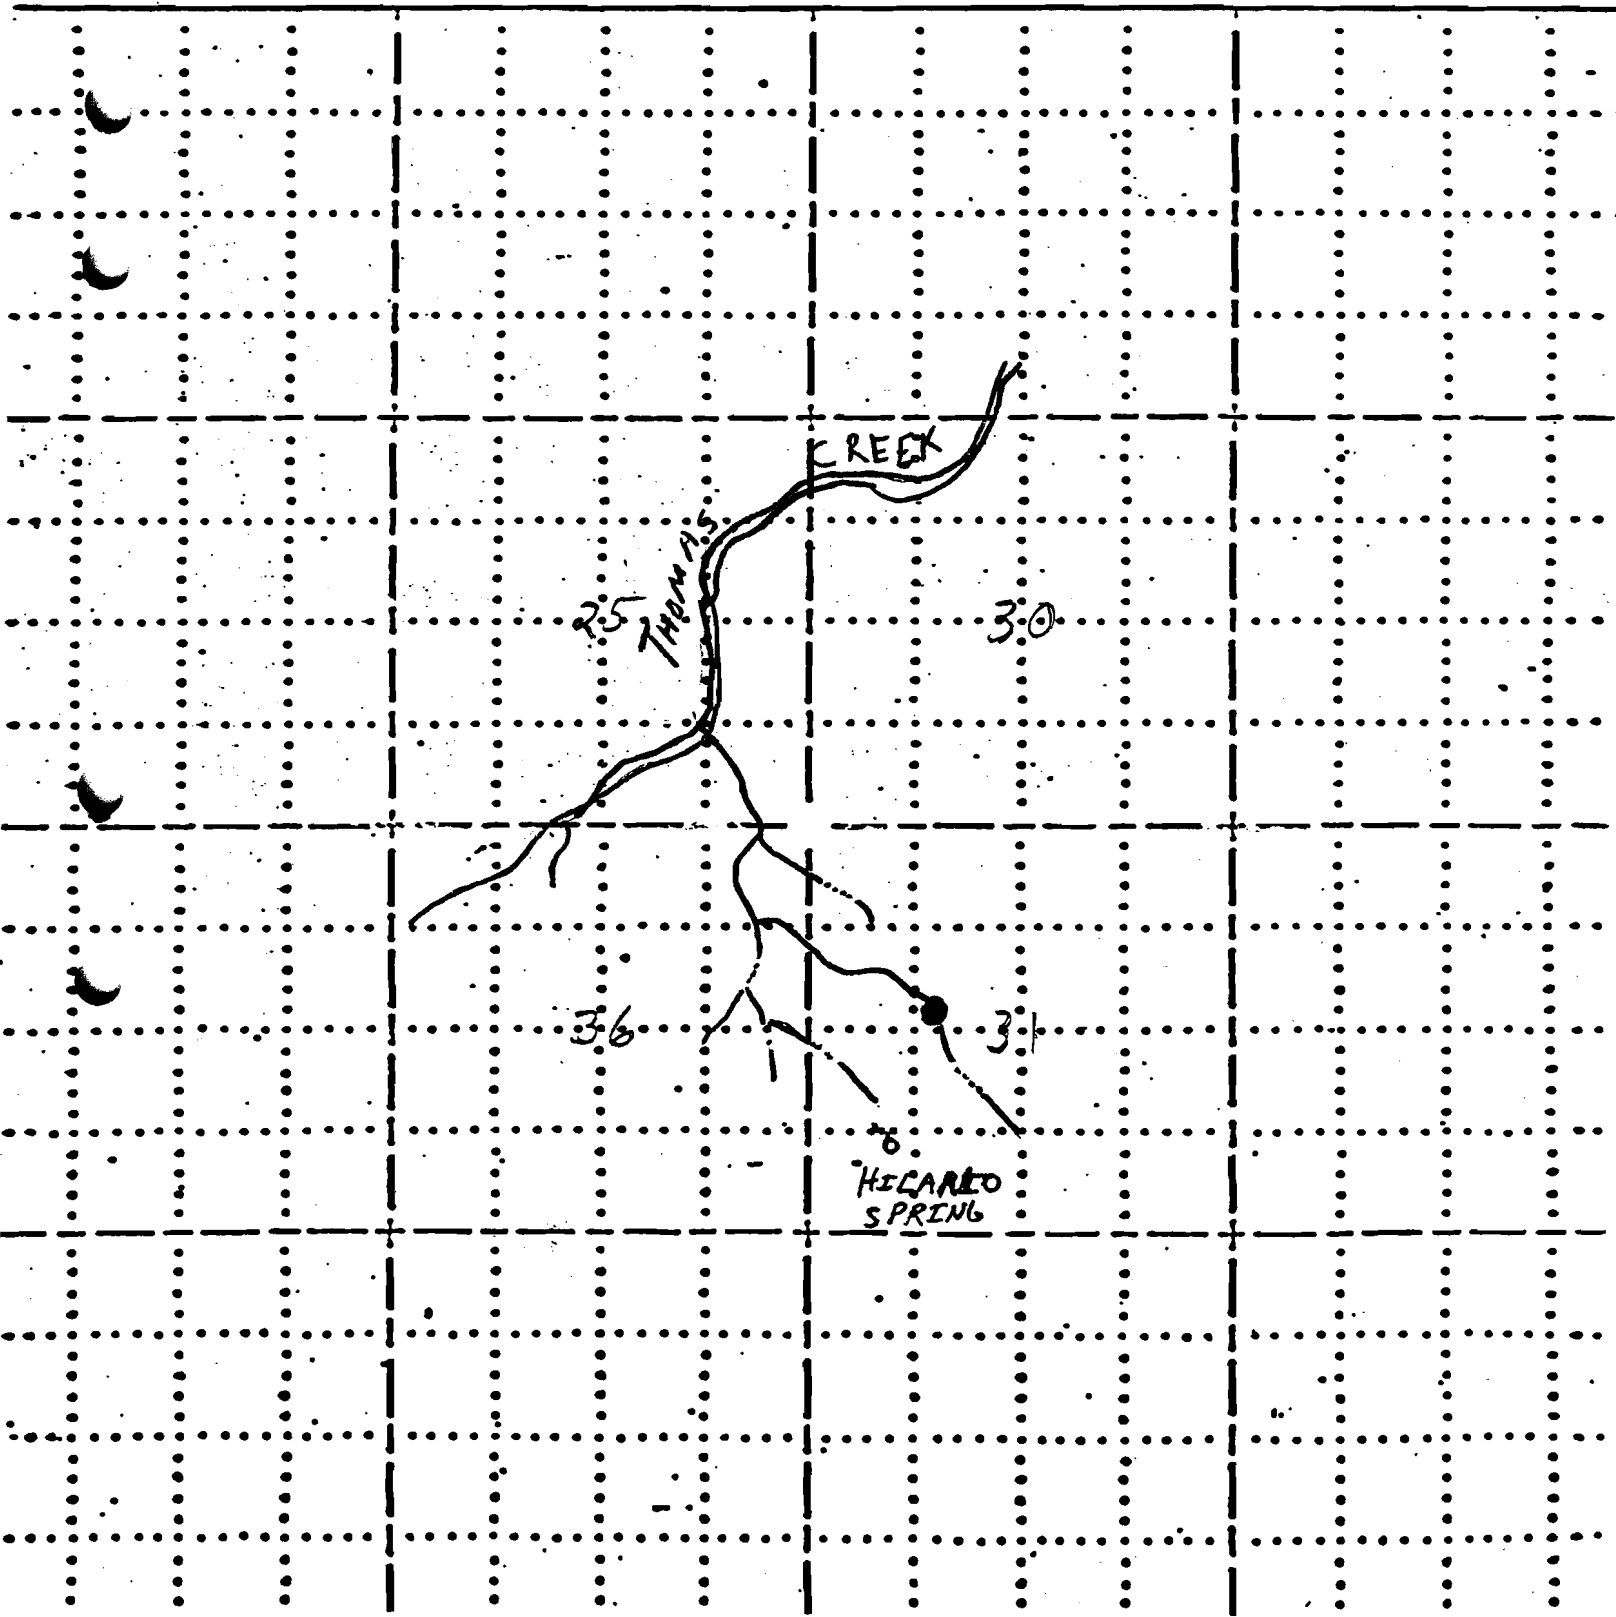

37 18 31
RECEIVED

AUG 19 1981

WATER RESOURCES DEPT
SALEM, OREGON

Application No. R-62541
Permit No. R 9138

