

AUG 19 1981


FIELD MAP SHEET WATER RESOURCES DEPT
SALEM, OREGON

T. 37S R. 17W Sec. _____ Subdiv. _____ N.F.

Mapped by _____ Reviewed by _____ Scale 2 inches = 1 Mile

● RESERVOIR
— DRAINAGE
— ROAD

Application No. R-62543, 19
Permit No. R 9140

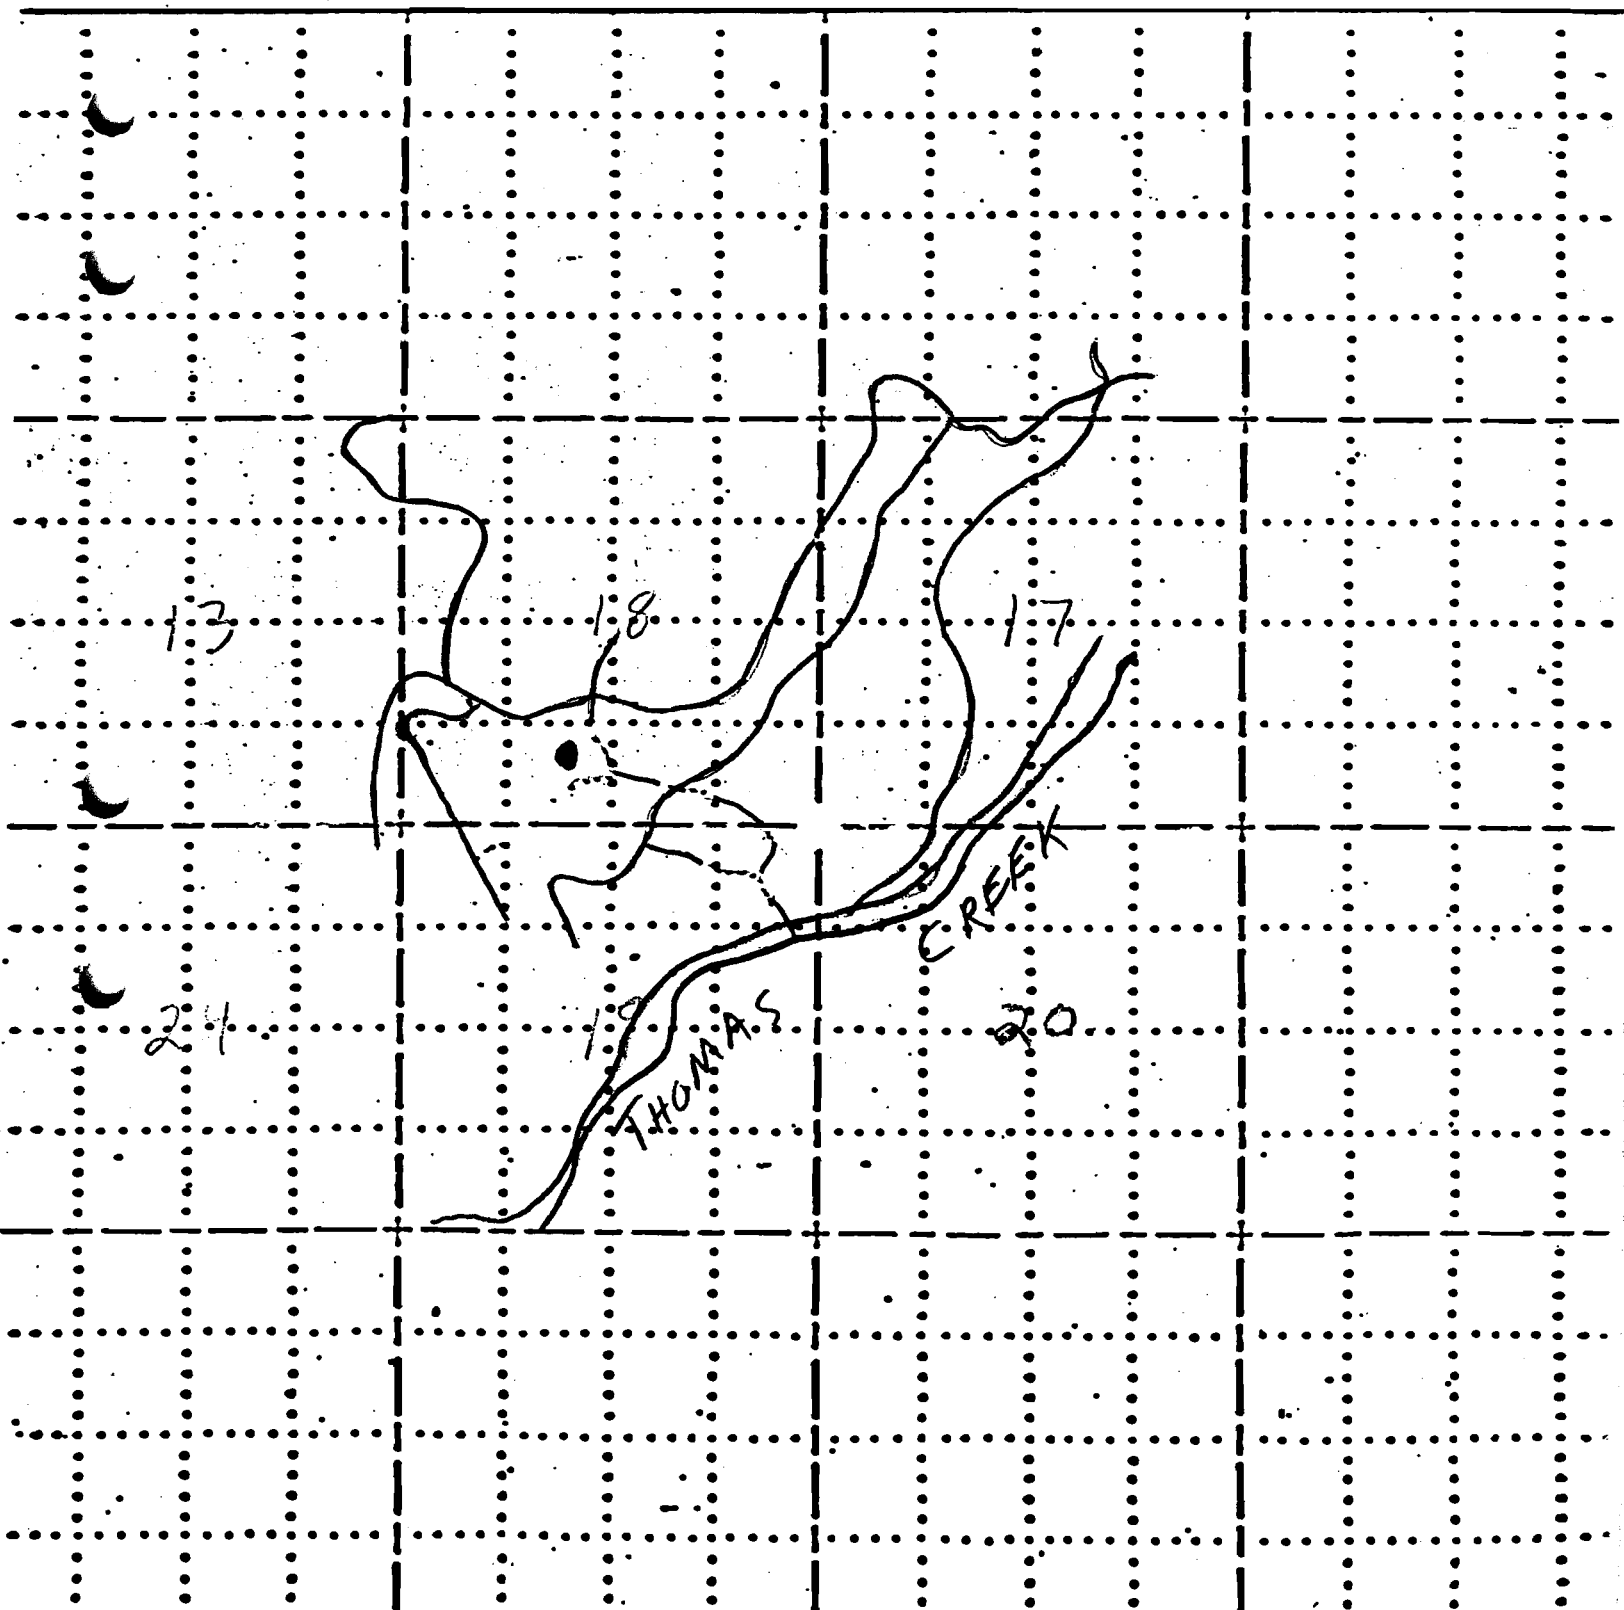

RECEIVED 1/6 18

AUG 19 1981

WATER RESOURCES DEPT
SALEM, OREGON

Application No. R-62543
Permit No. R 9140

