

AUG 19 1961

WATER RESOURCES DEPT
SALEM, OREGON

FIELD MAP SHEET

T. 37S R. 18W Sec. _____ Subdiv. _____ N.F. _____


Mapped by _____ Reviewed by _____ Scale 2 inches = 1 Mile

● RESERVOIR
— DRAINAGE
— ROAD

Application No. R-62545

Permit No. R 9141

19

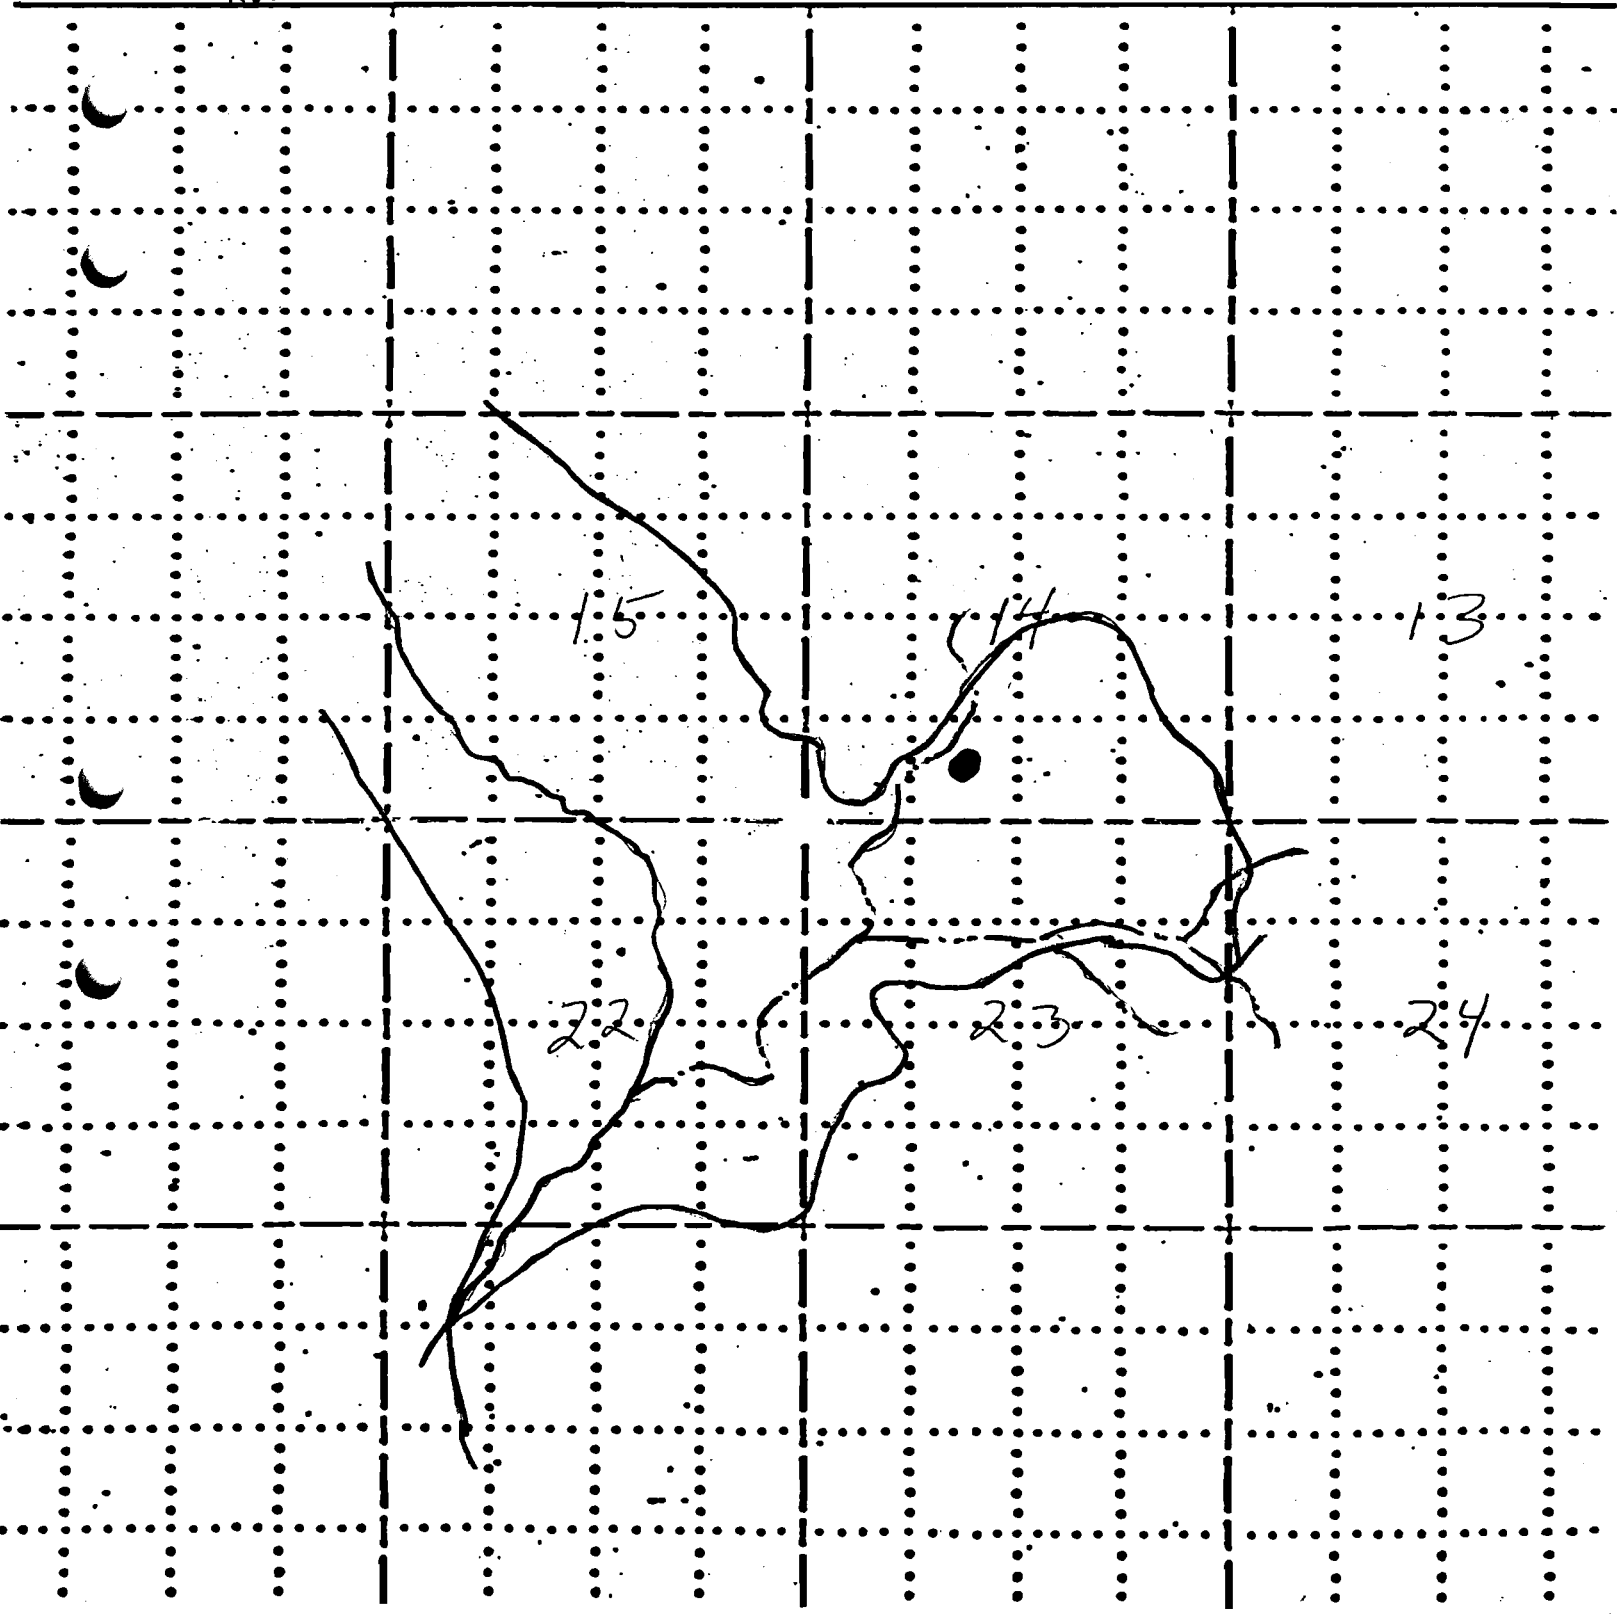

Shoestring
Spr

Creek

RECEIVED

AUG 19 1981

WATER RESOURCES DEPT
SALEM, OREGON

Application No. R-62545
Permit No. R 9141

Shoestring
Butte

VABM
7256

37 18 14

Cox
Flot

THOMAS

LUCKY LASS
MINE

WHITE
KING
MINE