

RECEIVED 59228

AUG 19 1981

WATER RESOURCES DEPT
SALEM, OREGON

FIELD MAP SHEET


T. 36S 37S R. 20E Sec. _____ Subdiv. _____ N.F.


Mapped by _____ Reviewed by _____ Scale 2 inches = 1 Mile

Application No. R-62547

Permit No. R 9143

— ROAD
— DRAINAGE
● RESERVOIR

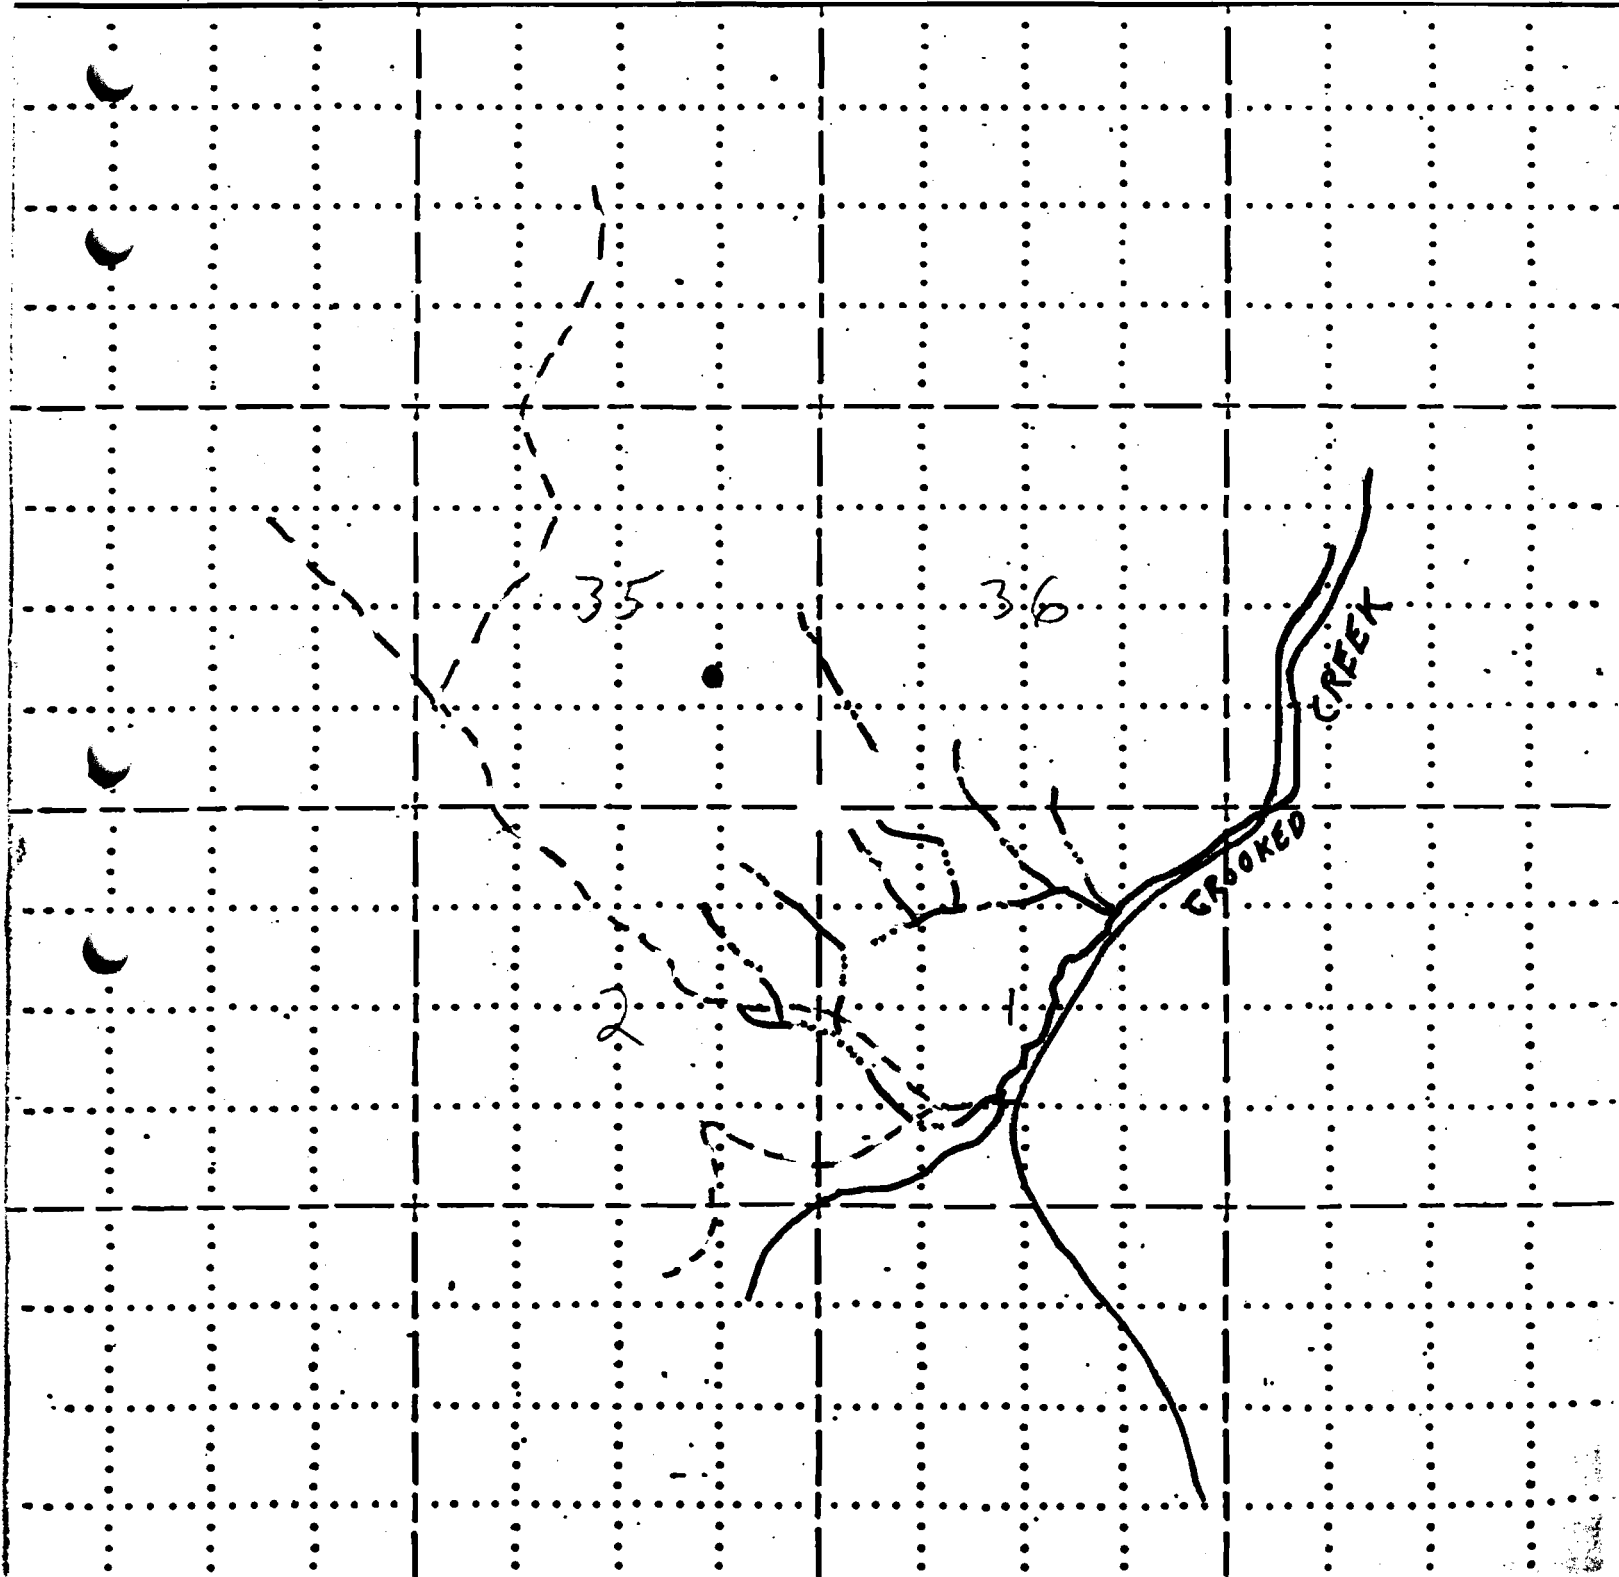

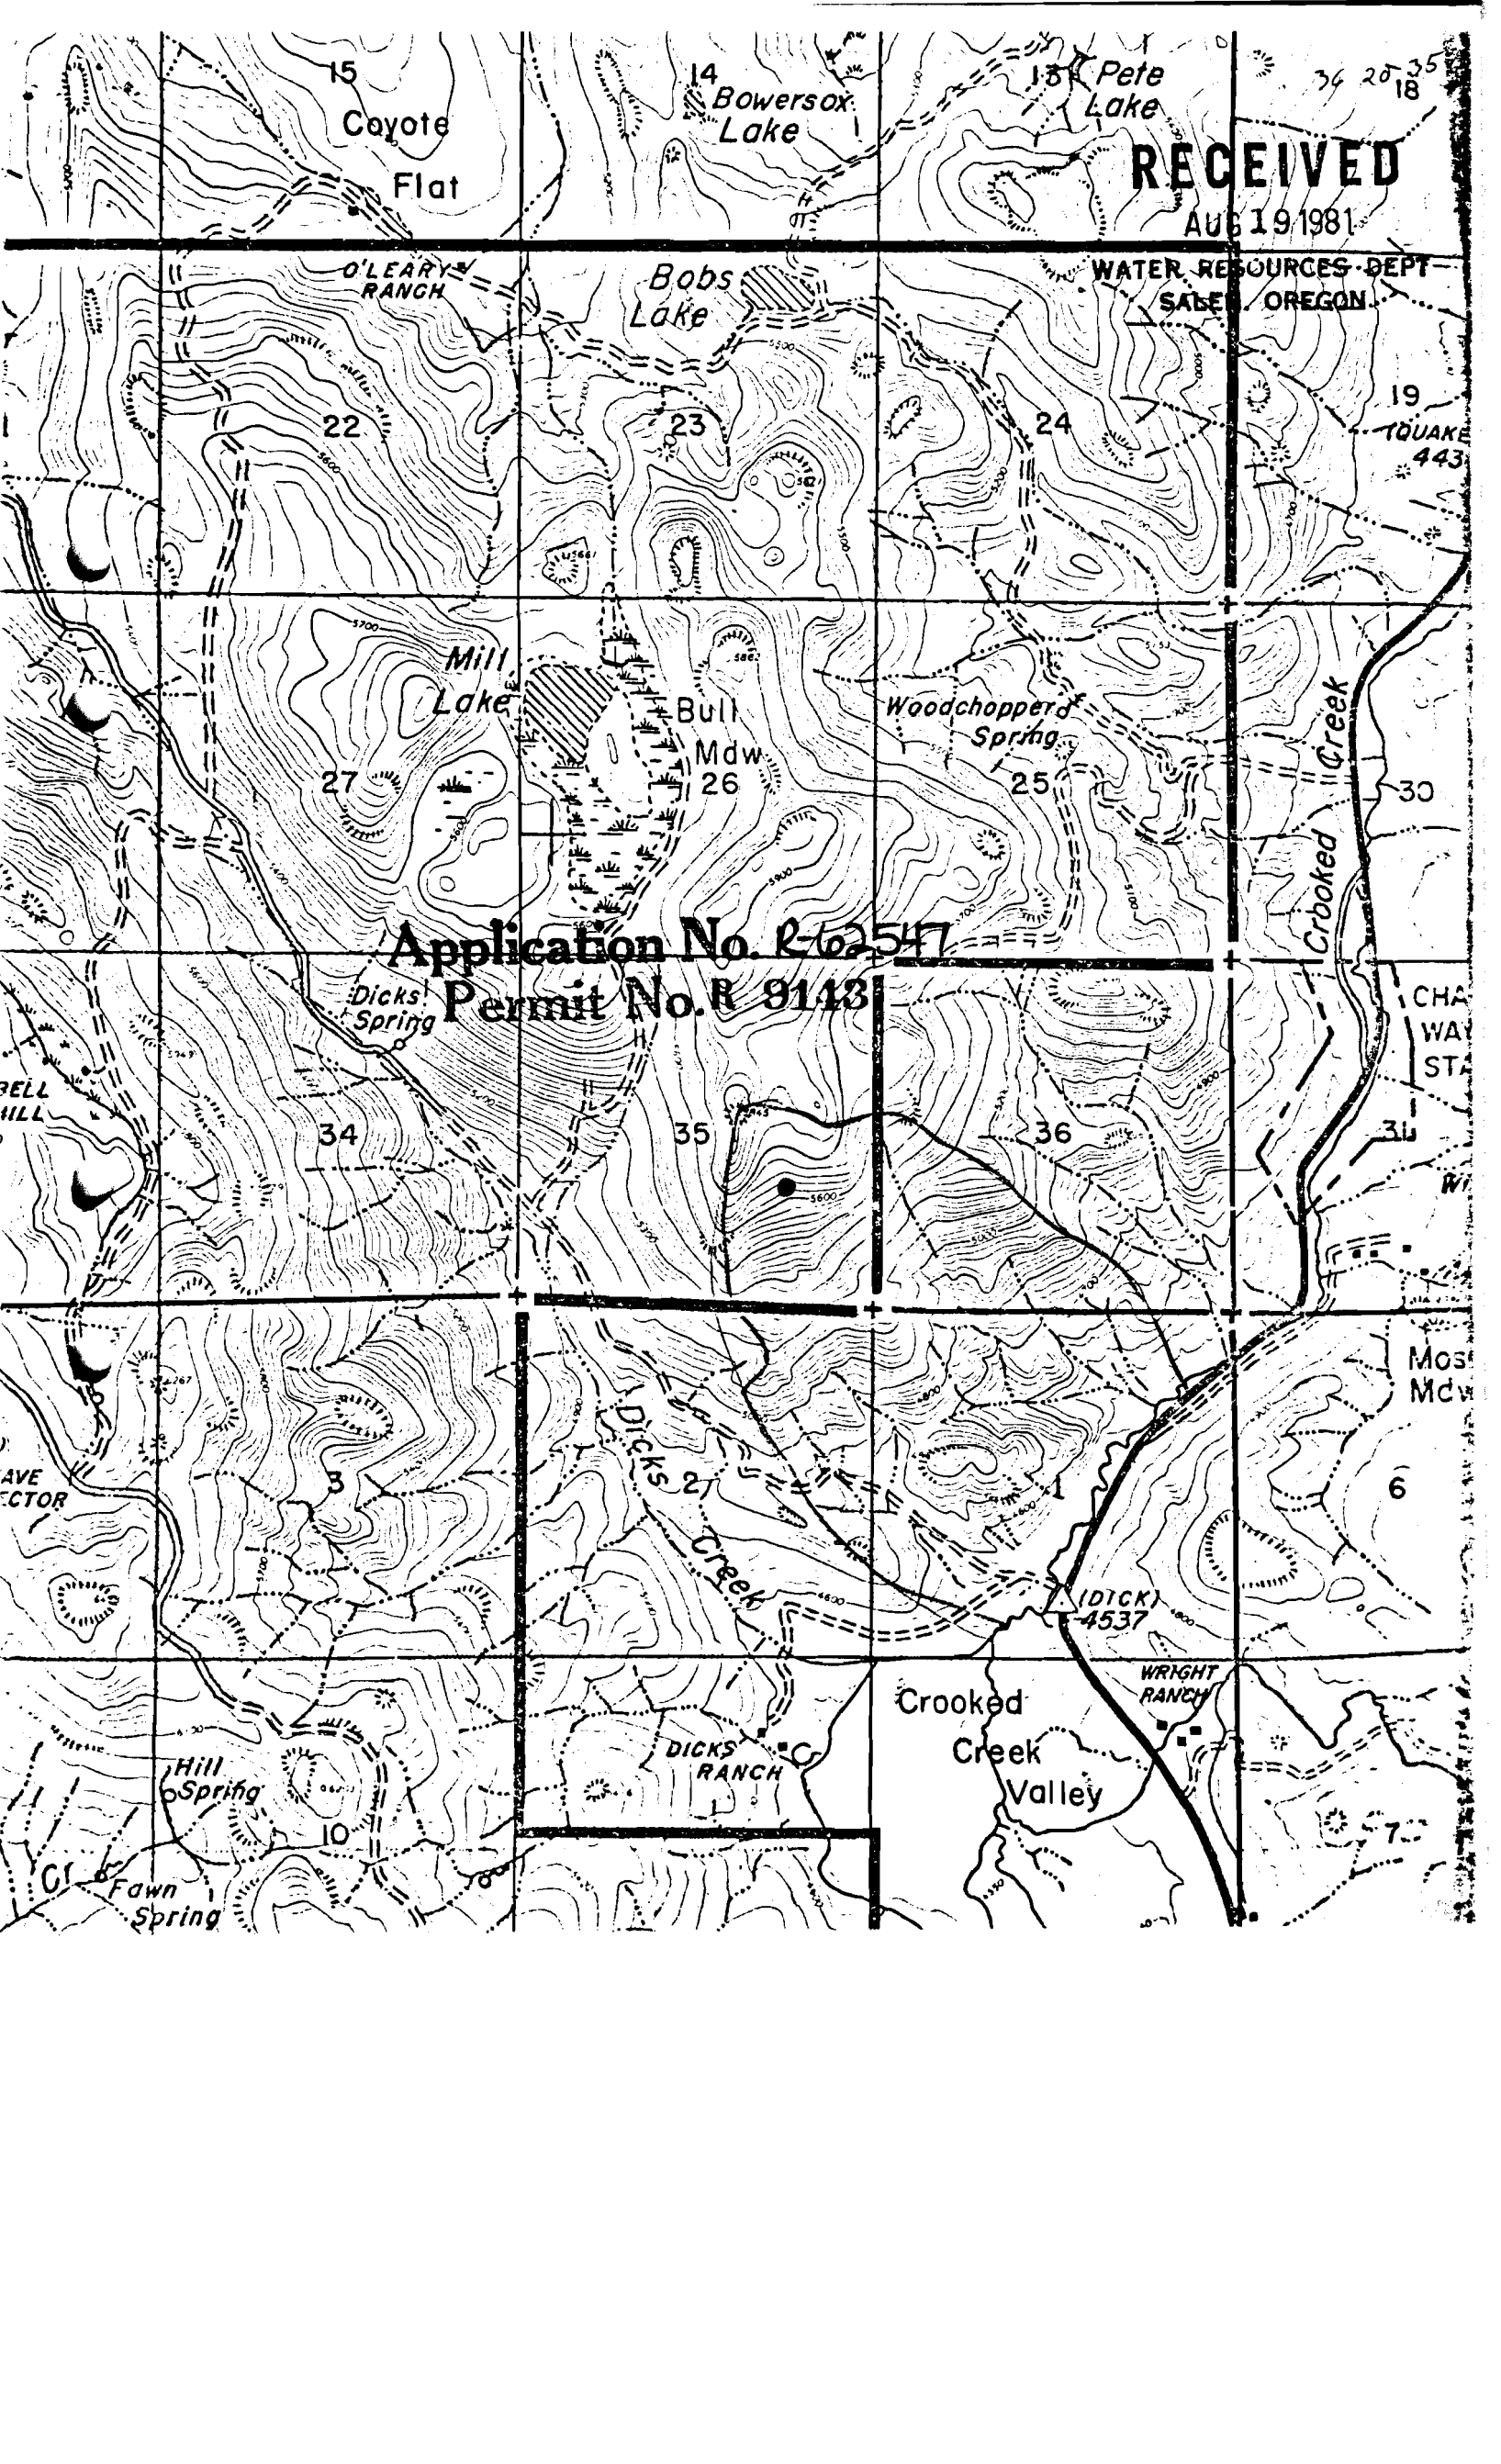

15
Coyote
Flat

14
Bowersox
Lake

13
Pete
Lake

RECEIVED

AUG 19 1981

O'LEARY
RANCH

Bobs
Lake

WATER RESOURCES DEPT
SALE OREGON

22

23

24

19

TOUAK
443

Mill
Lake

Bull
Mdw
26

Woodchopper
Spring

27

25

30

Application No. R-62547

Permit No. R-9143

Dicks
Spring

34

35

36

31

CHA
WA
STA

Most
Mdw

6

(DICK)
4537

WRIGHT
RANCH

Crooked
Creek
Valley

DICKS
RANCH

Hill
Spring

10

Fawn
Spring