

R-9702
59232

FIELD MAP SHEET

Application No. R-62788
Permit No. R 9702

T. 33S R. 14E Sec. _____ Subdiv. _____ FREMONT N.F.

Mapped by T. OLENIK Reviewed by _____ Scale 2 inches = 1 Mile


RECEIVED

SEP 17 1981

8/18, 1981

WATER RESOURCES DEPT

SALEM, OREGON

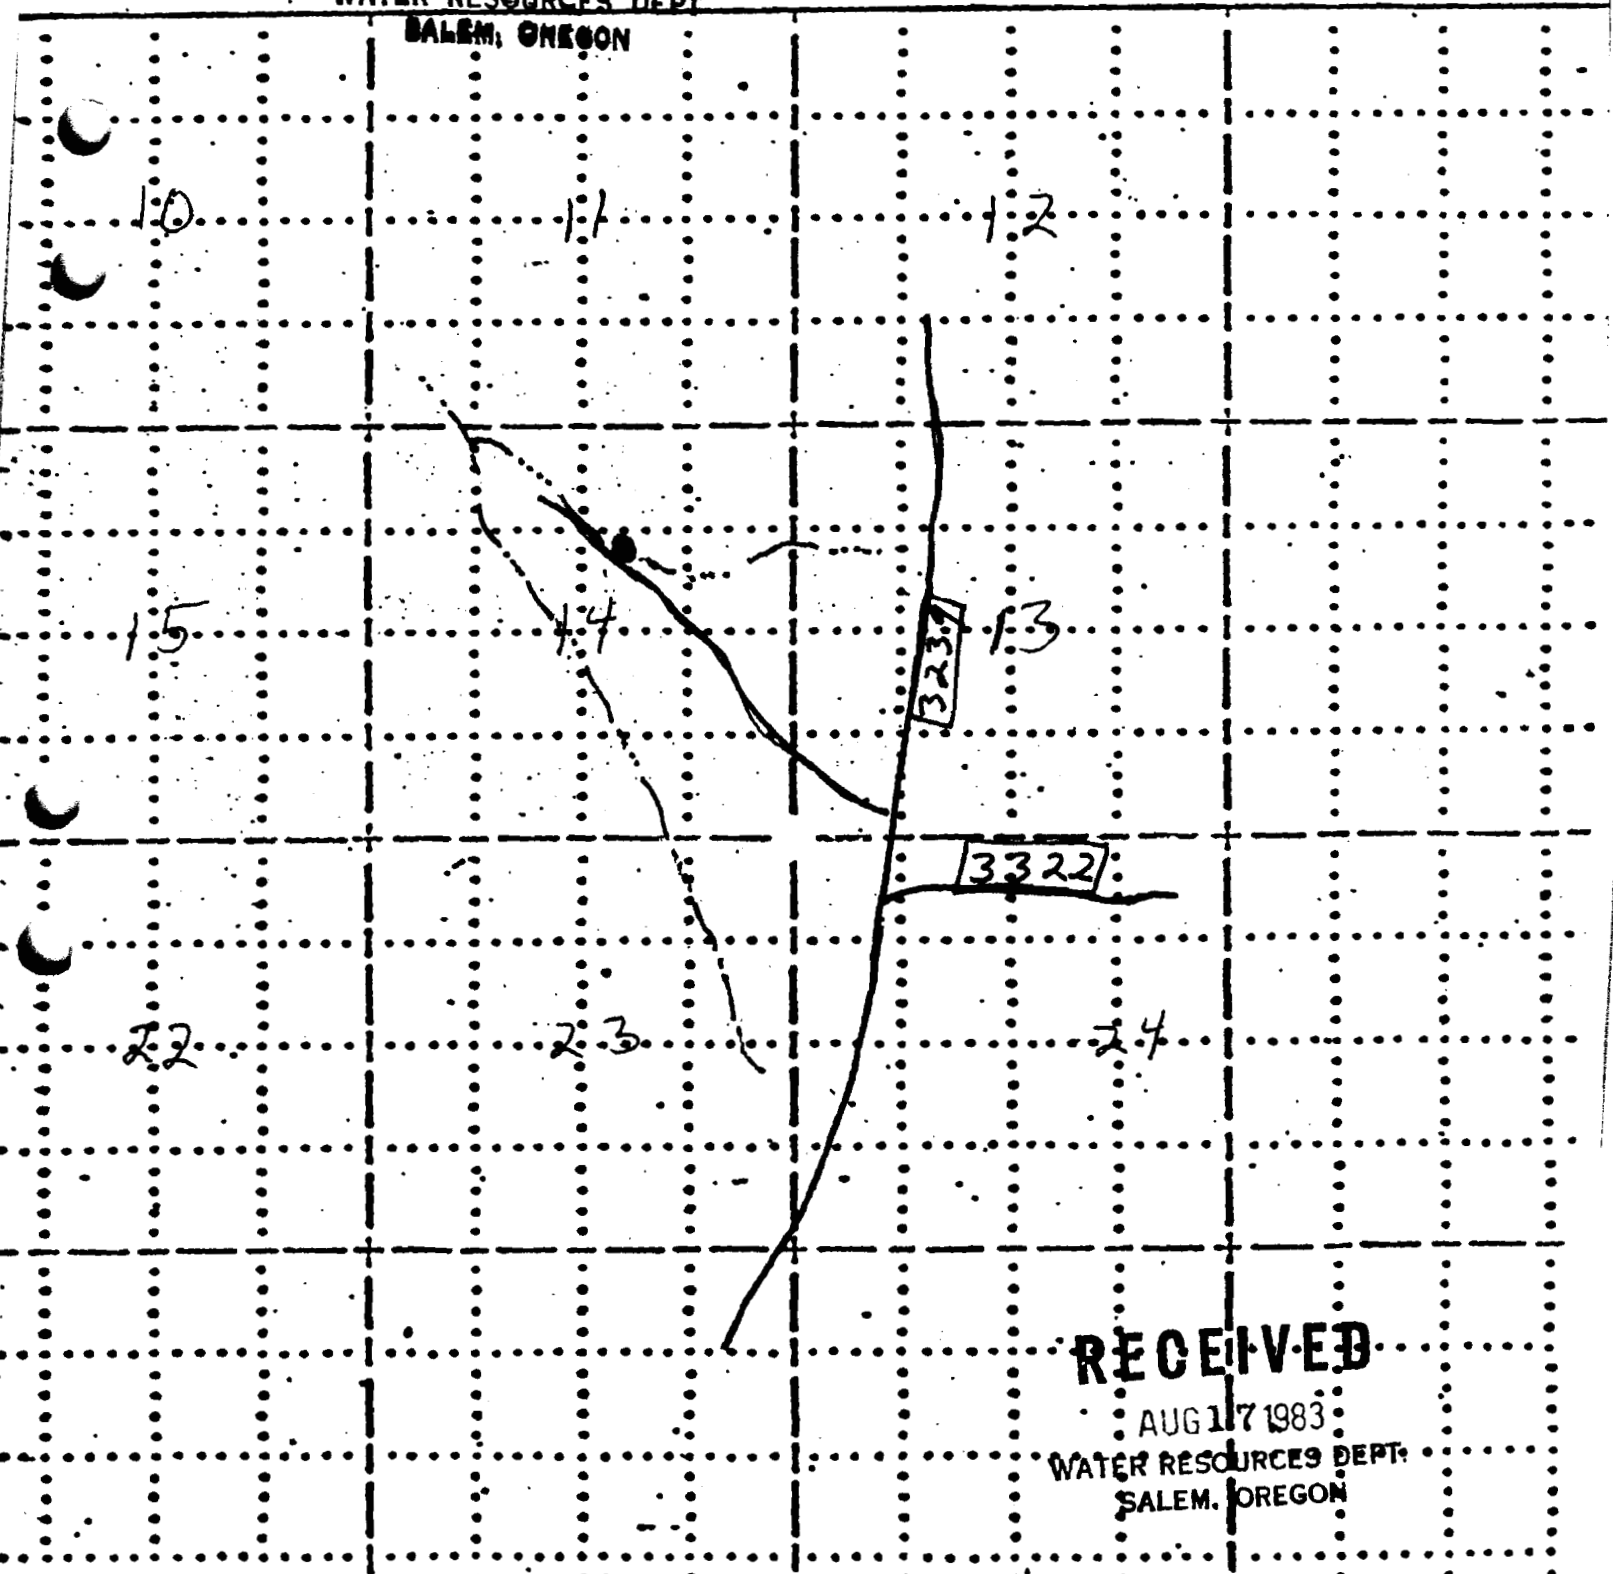

RECEIVED


AUG 17 1983

WATER RESOURCES DEPT.
SALEM, OREGON

RECEIVED

SEP 17 1981

WATER RESOURCES DEPT
SALEM, OREGON

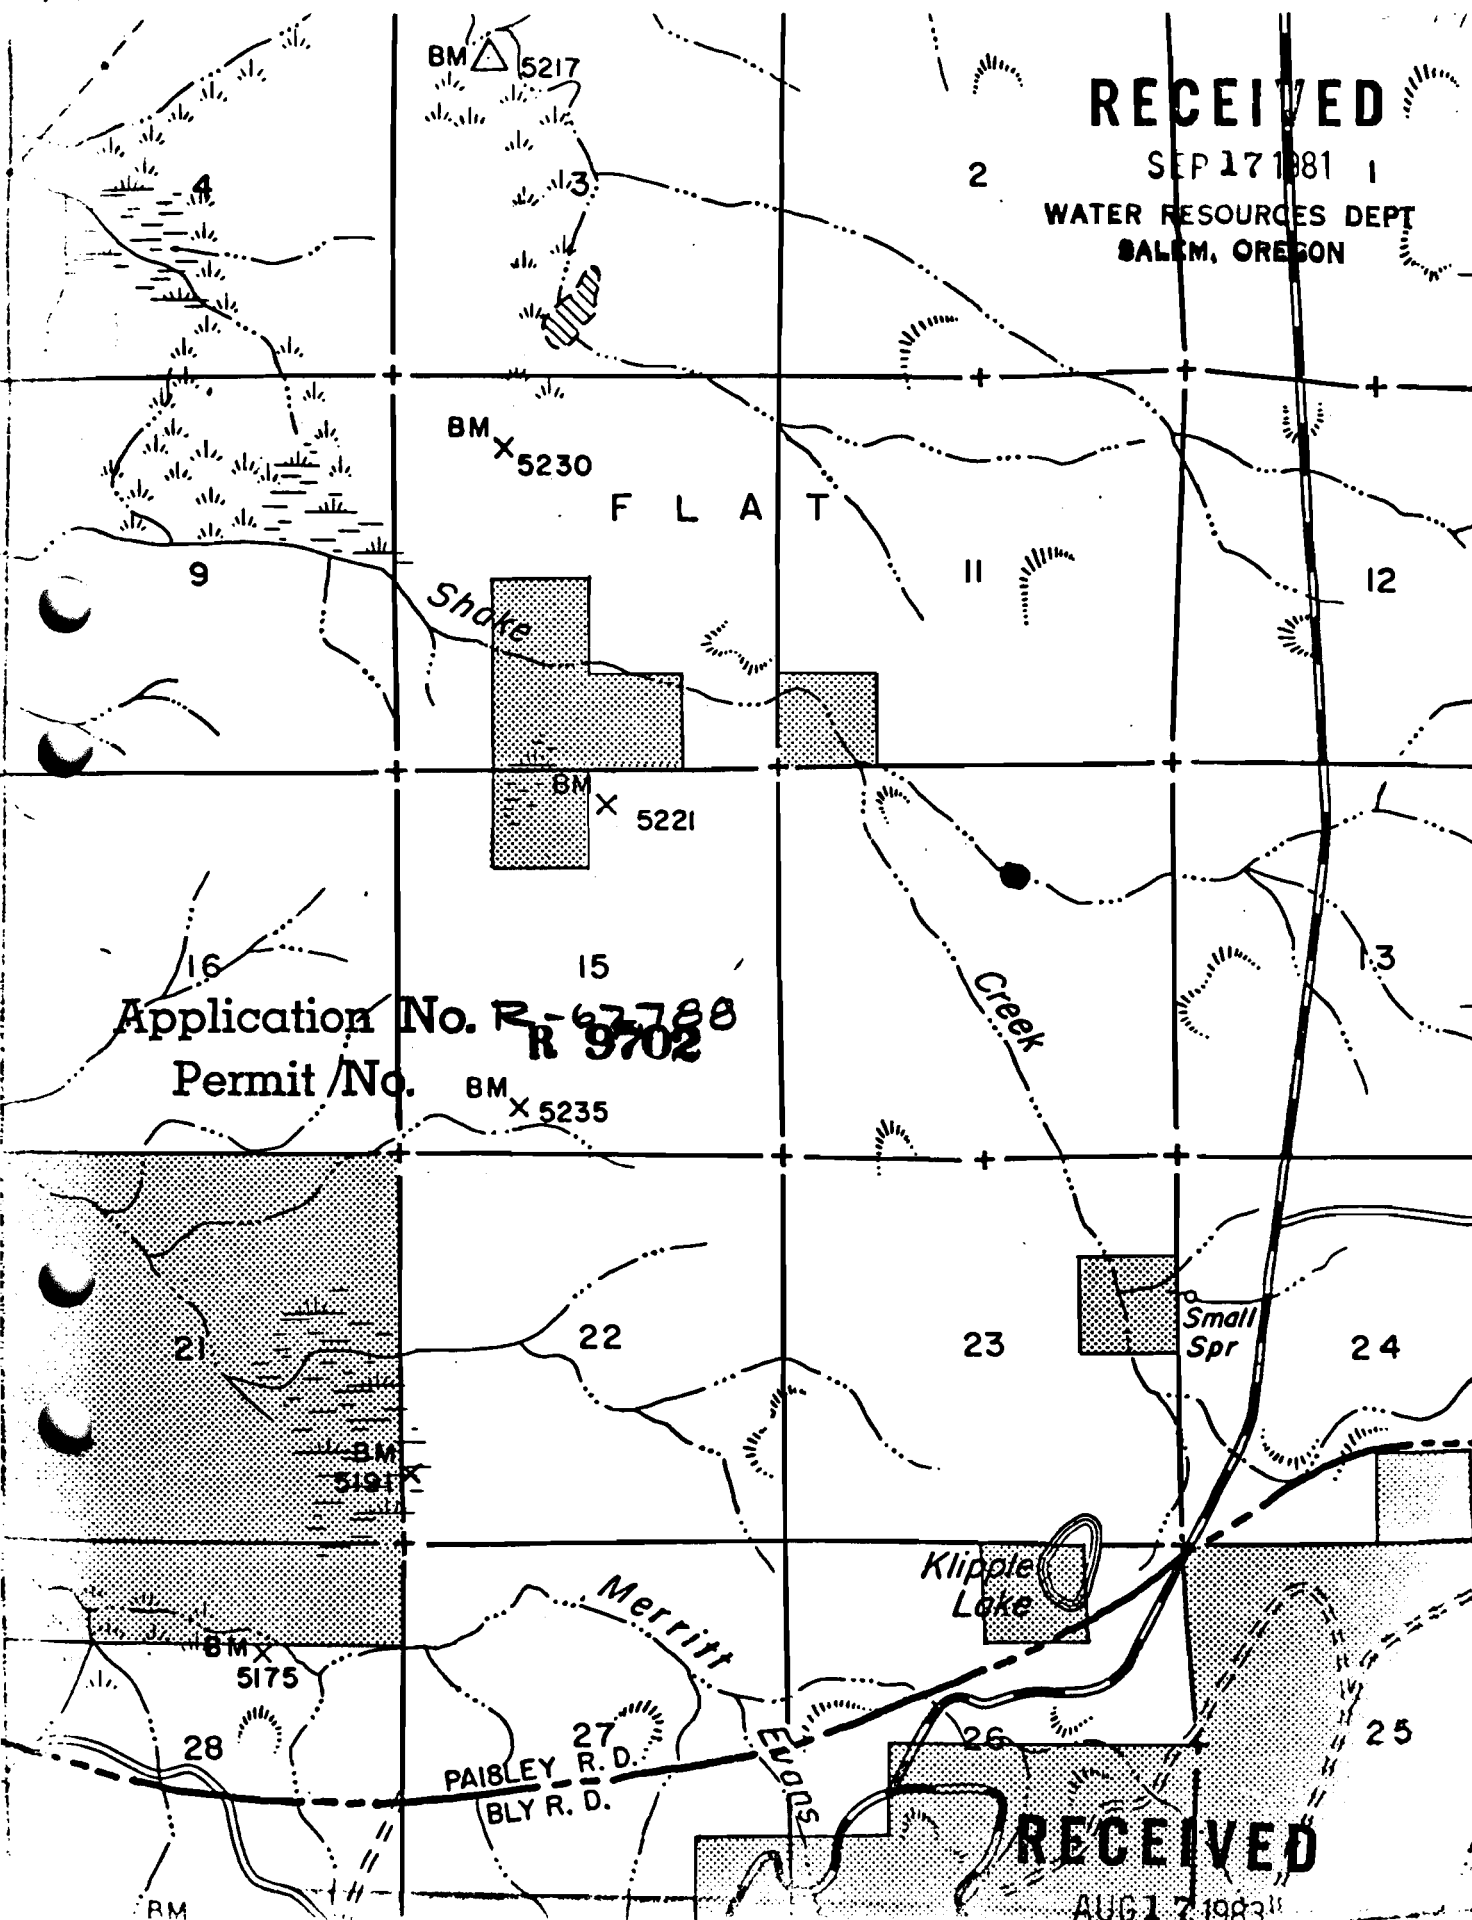

Application No. R-62788
Permit No. R 9702

T.33

RECEIVED

AUG 17 1983

WATER RESOURCES DEPT.
SALEM, OREGON