

FIELD MAP SHEET

Application No. ⁵⁹²³⁵ ~~R-62791~~

Permit No. R 9705

T. 34S R. 16E Sec. 14 Subdiv. FREMONT N.F.


Mapped by T. OLENICHAK Reviewed by _____ Scale 2 inches = 1 Mile

RECEIVED

8/18, 1981

SEP 17 1981


WATER RESOURCES DEPT
SALEM, OREGON

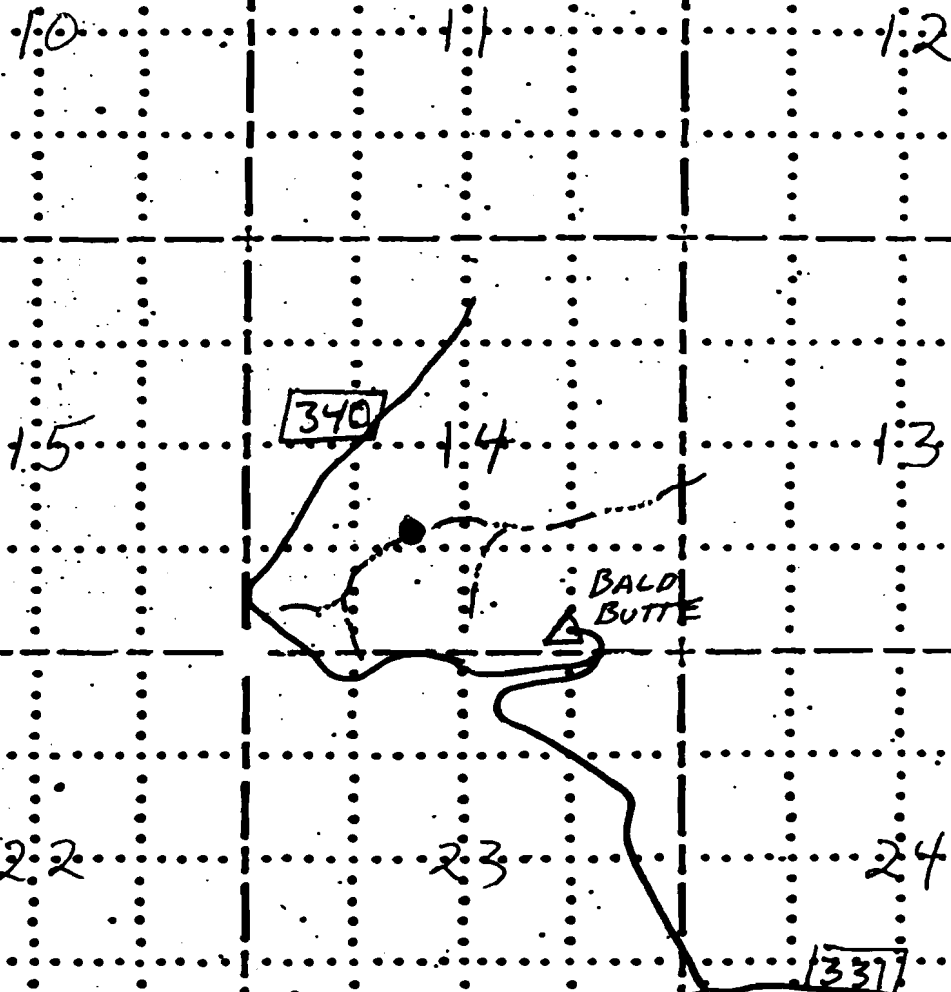

RECEIVED

AUG 17 1981

WATER RESOURCES DEPT.
SALEM, OREGON

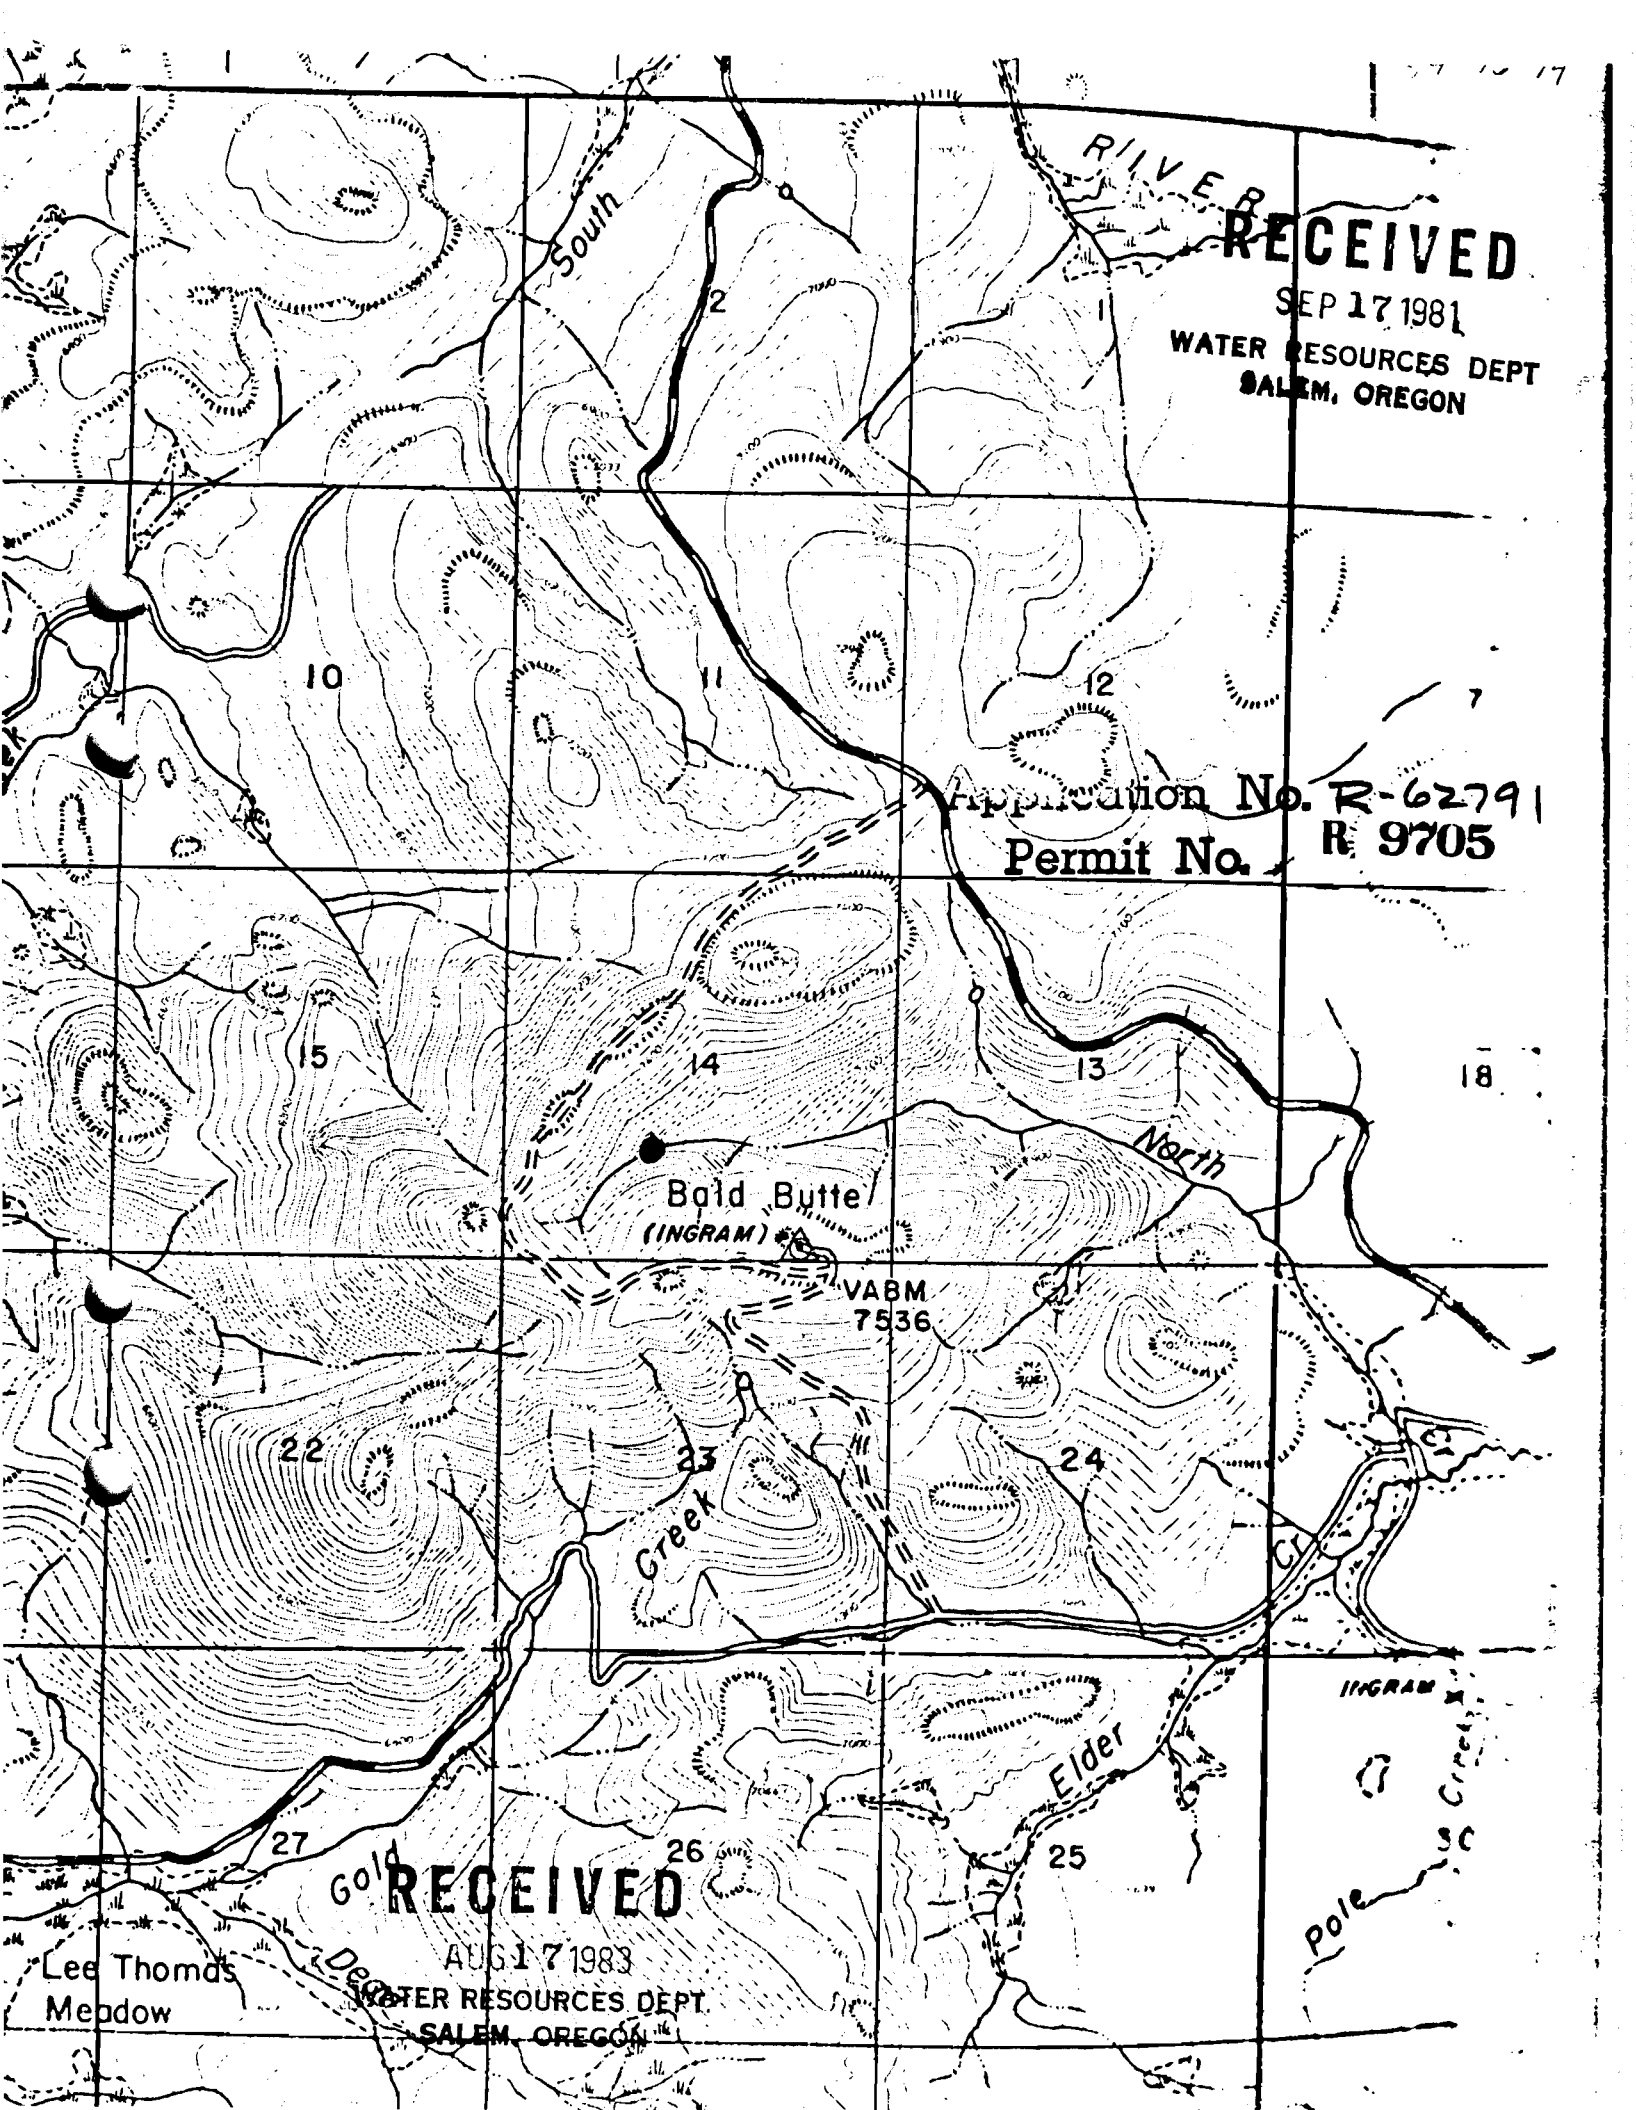

RECEIVED

SEP 17 1981

WATER RESOURCES DEPT
SALEM, OREGON

Application No. R-62791
Permit No. R 9705

Bold Butte
(INGRAM)

VABM
7536

Creek

Elder

INGRAM
Creek
Pole

RECEIVED

AUG 17 1983

WATER RESOURCES DEPT.
SALEM, OREGON

Lee Thomas
Meadow