

Revised July 1941

FOREST SERVICE

R-9706

59236

FIELD MAP SHEET

Application No. R-62792

Permit No. R 9706

T. 34S R. 15E/16E Sec. Subdiv. FREMONT N.F.

Mapped by T. OLENICHAK Reviewed by Scale 2 inches = 1 Mile


- RESERVOIR
- DRAINAGE
- ROAD

RECEIVED

8/18, 1981


SEP 17 1981

WATER RESOURCES DEPT
SALEM, OREGON

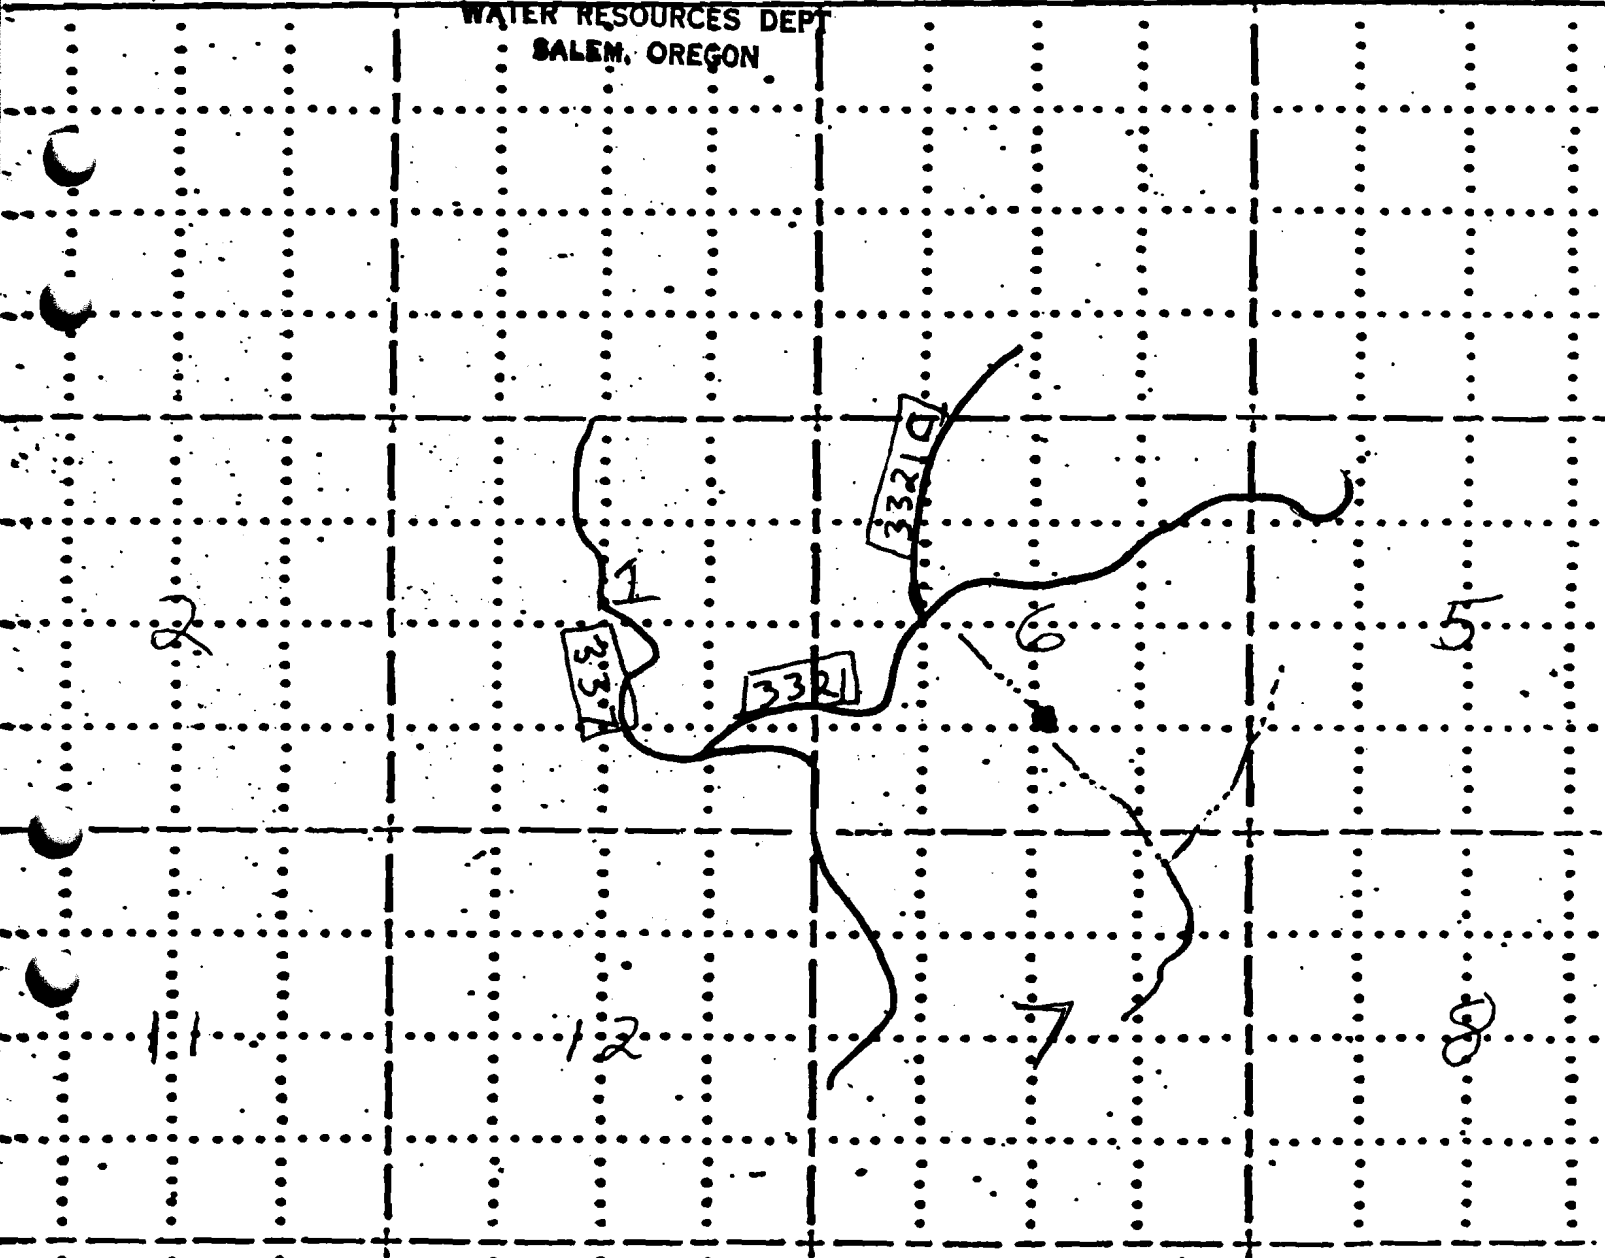

RECEIVED

AUG 17 1983
WATER RESOURCES DEPT
SALEM, OREGON

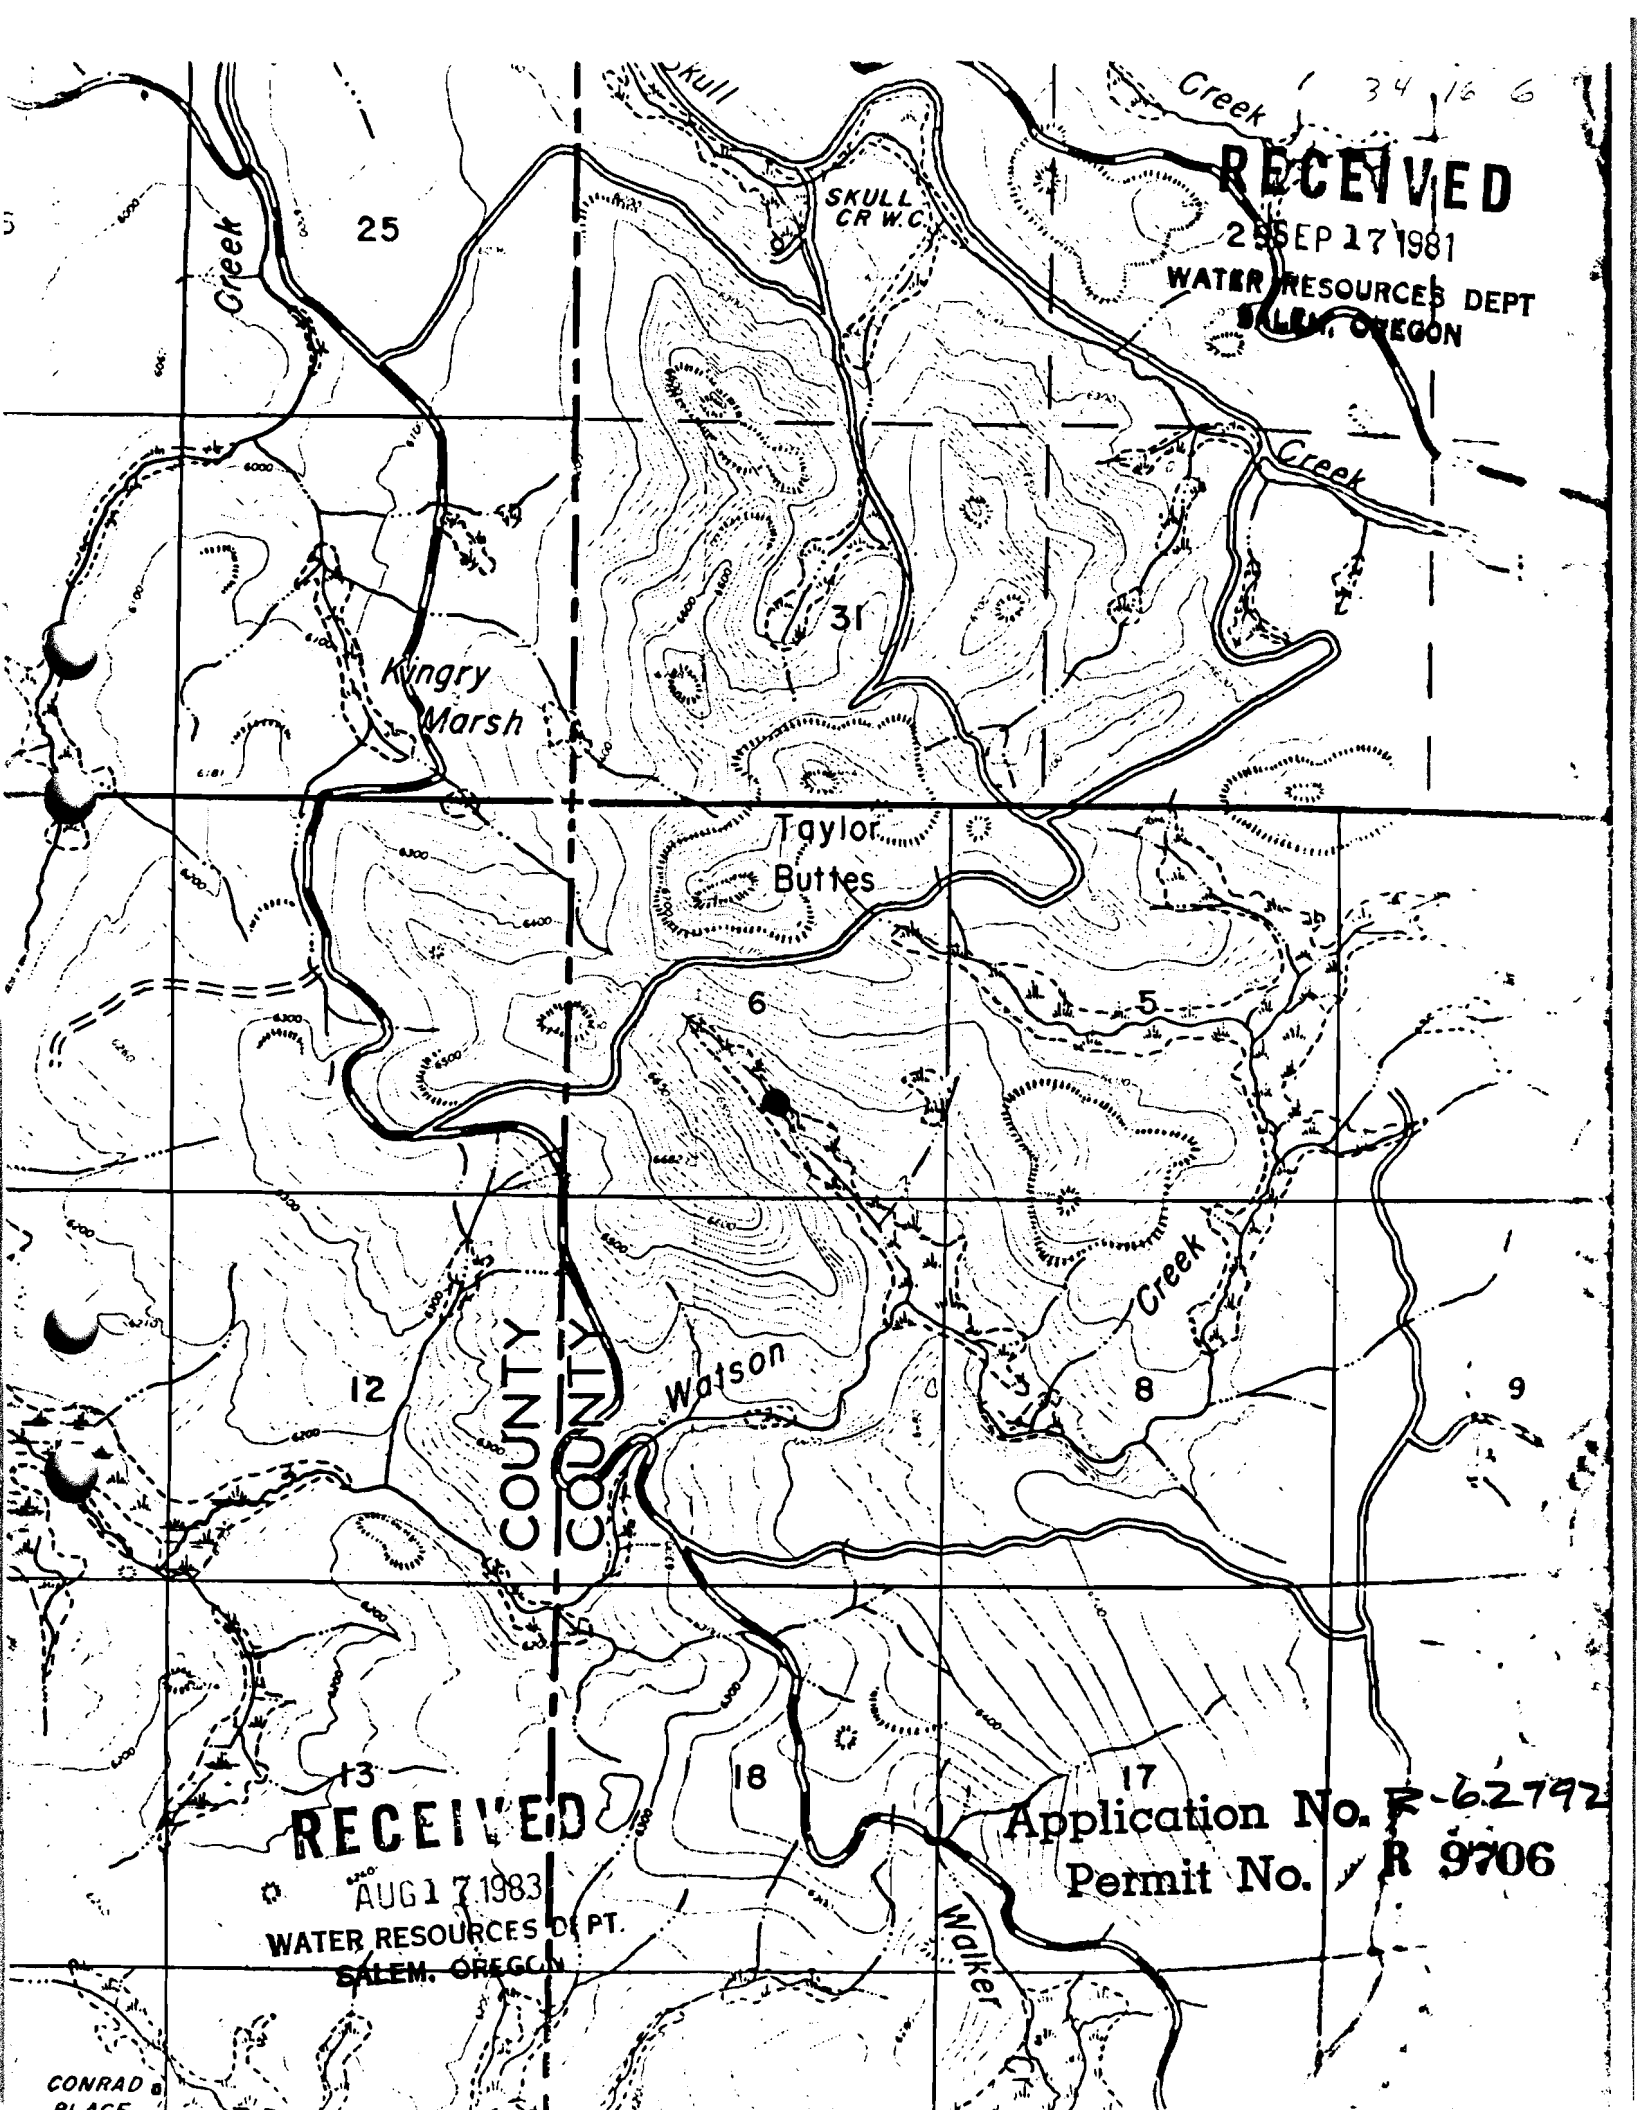

34 16 6
RECEIVED

29 SEP 17 1981

WATER RESOURCES DEPT
SALEM, OREGON

RECEIVED

AUG 17 1983
WATER RESOURCES DEPT.
SALEM, OREGON

Application No. R-62792

Permit No. R 9706

CONRAD
BLACE