

Application No. **R-62793**  
**FIELD MAP SHEET**  
Permit No. **R 9707**

T. 36S R. 18E Sec. \_\_\_\_\_ Subdiv. \_\_\_\_\_ FREMONT N.F.

Mapped by T. OLENTCHAK Reviewed by \_\_\_\_\_ Scale 2 inches = 1 Mile


- RESERVOIR
- DRAINAGE
- ROAD

**RECEIVED.**

8/18, 19 81

SEP 17 1981

WATER RESOURCES DEPT  
SALEM, OREGON

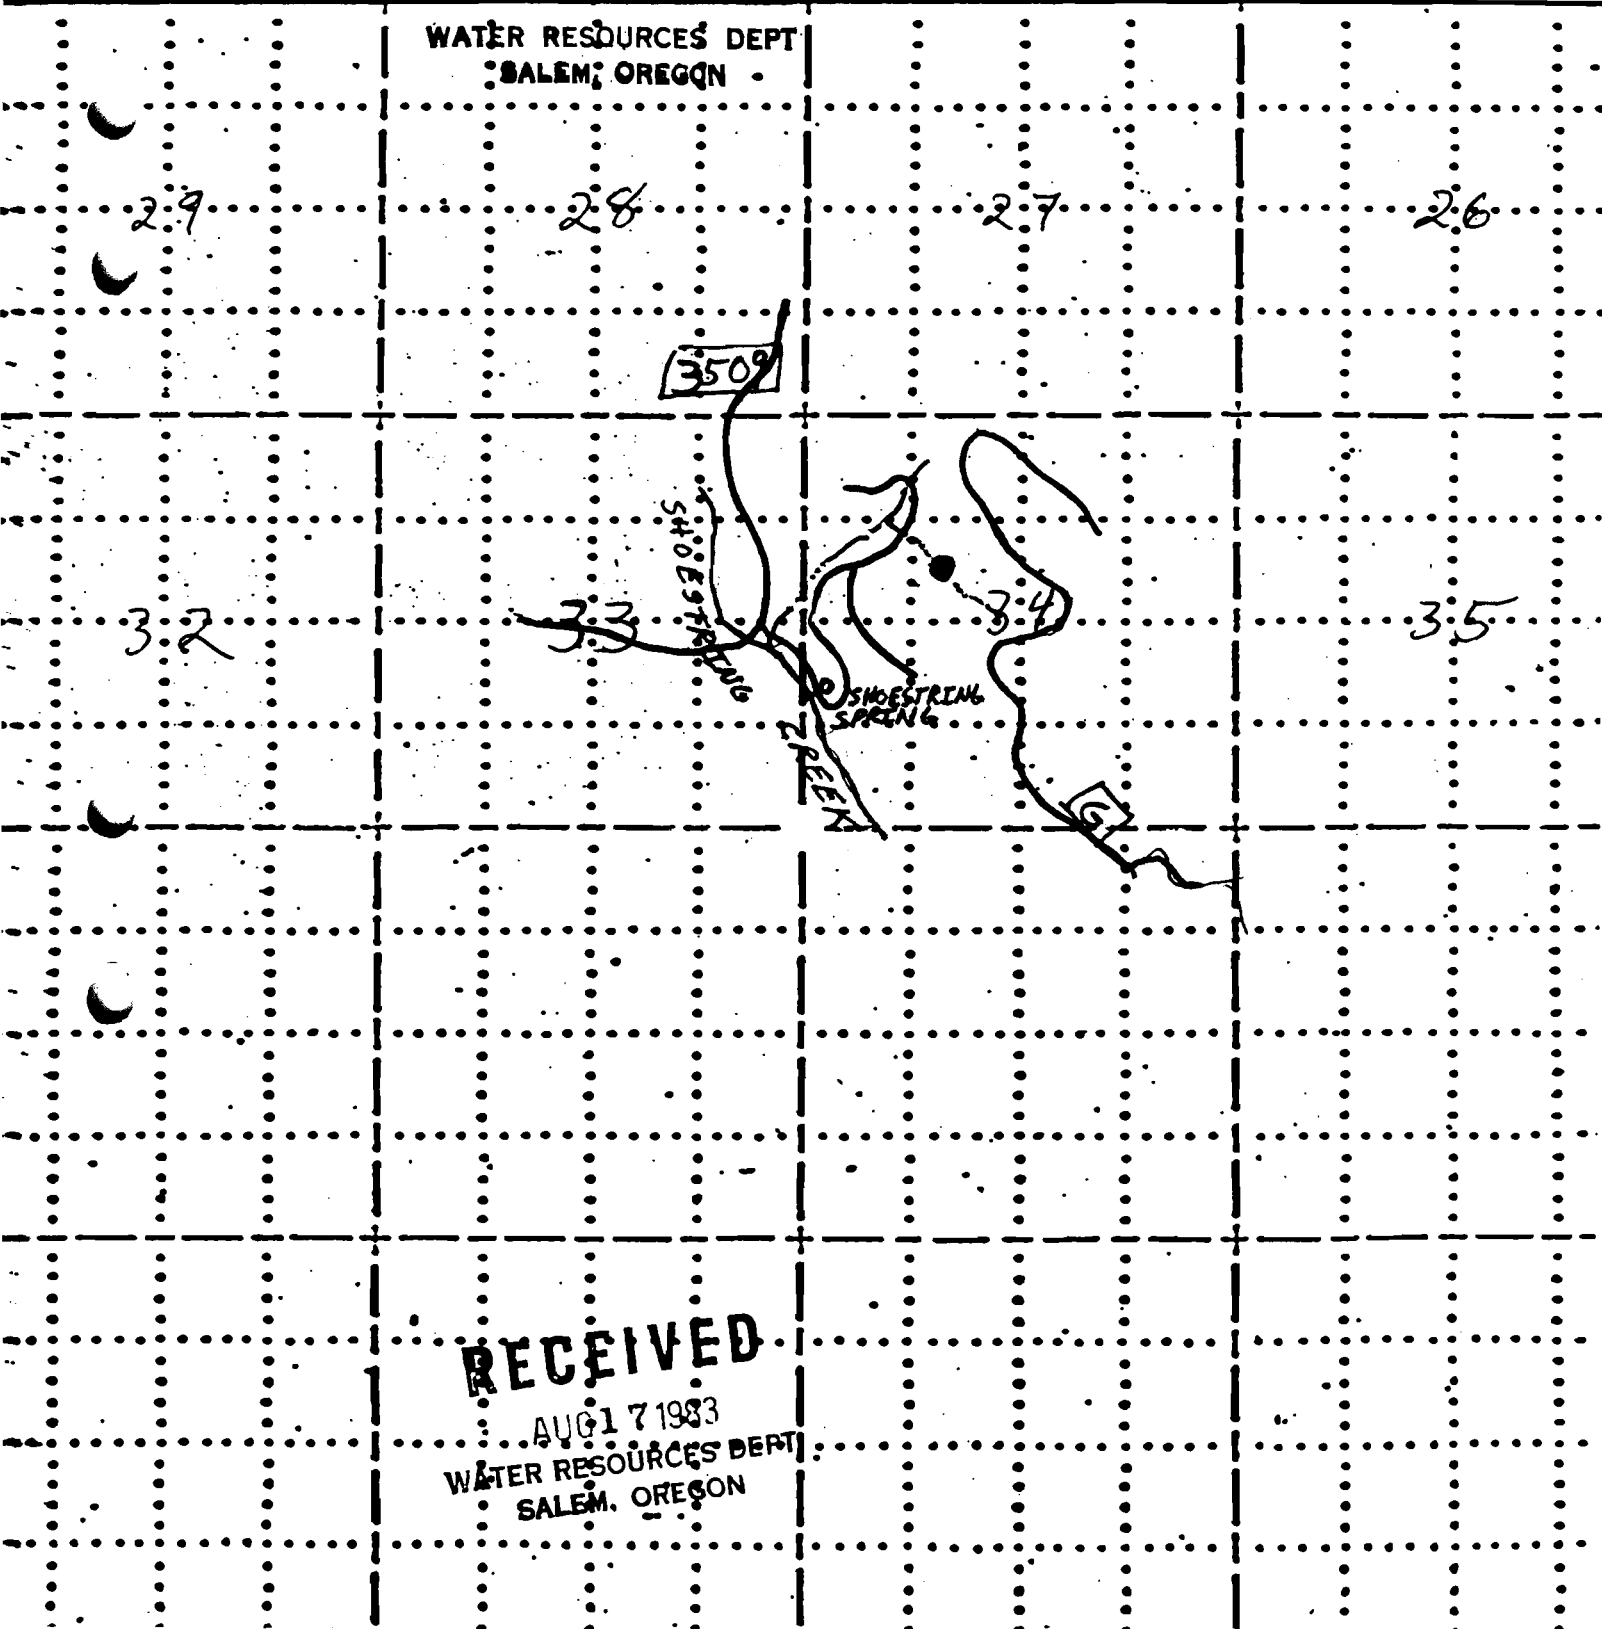

**RECEIVED.**

AUG 17 1983  
WATER RESOURCES DEPT  
SALEM, OREGON

**RECEIVED**

SEP 17 1984

WATER RESOURCES DEPT  
SALEM, OREGON

Application No. R-62493

Permit No. R 9707

Dicks Pond

Shoestring  
Spr  
Creek

THOMAS  
CREEK W.C.

**RECEIVED**

AUG 17 1983

WATER RESOURCES DEPT  
SALEM, OREGON

LAKEVIEW