


Application No. R-62794
FIELD MAP SHEET Permit No. R 9708

T. 36S R. 19E Sec. _____ Subdiv. _____ FREMONT N.F.

Mapped by T. OLENICZAK Reviewed by _____ Scale 2 inches = 1 Mile

● RESERVOIR
--- DRAINAGE
— ROAD
RECEIVED
SEP 17 1981
8/18, 1981
WATER RESOURCES DEPT
SALEM, OREGON

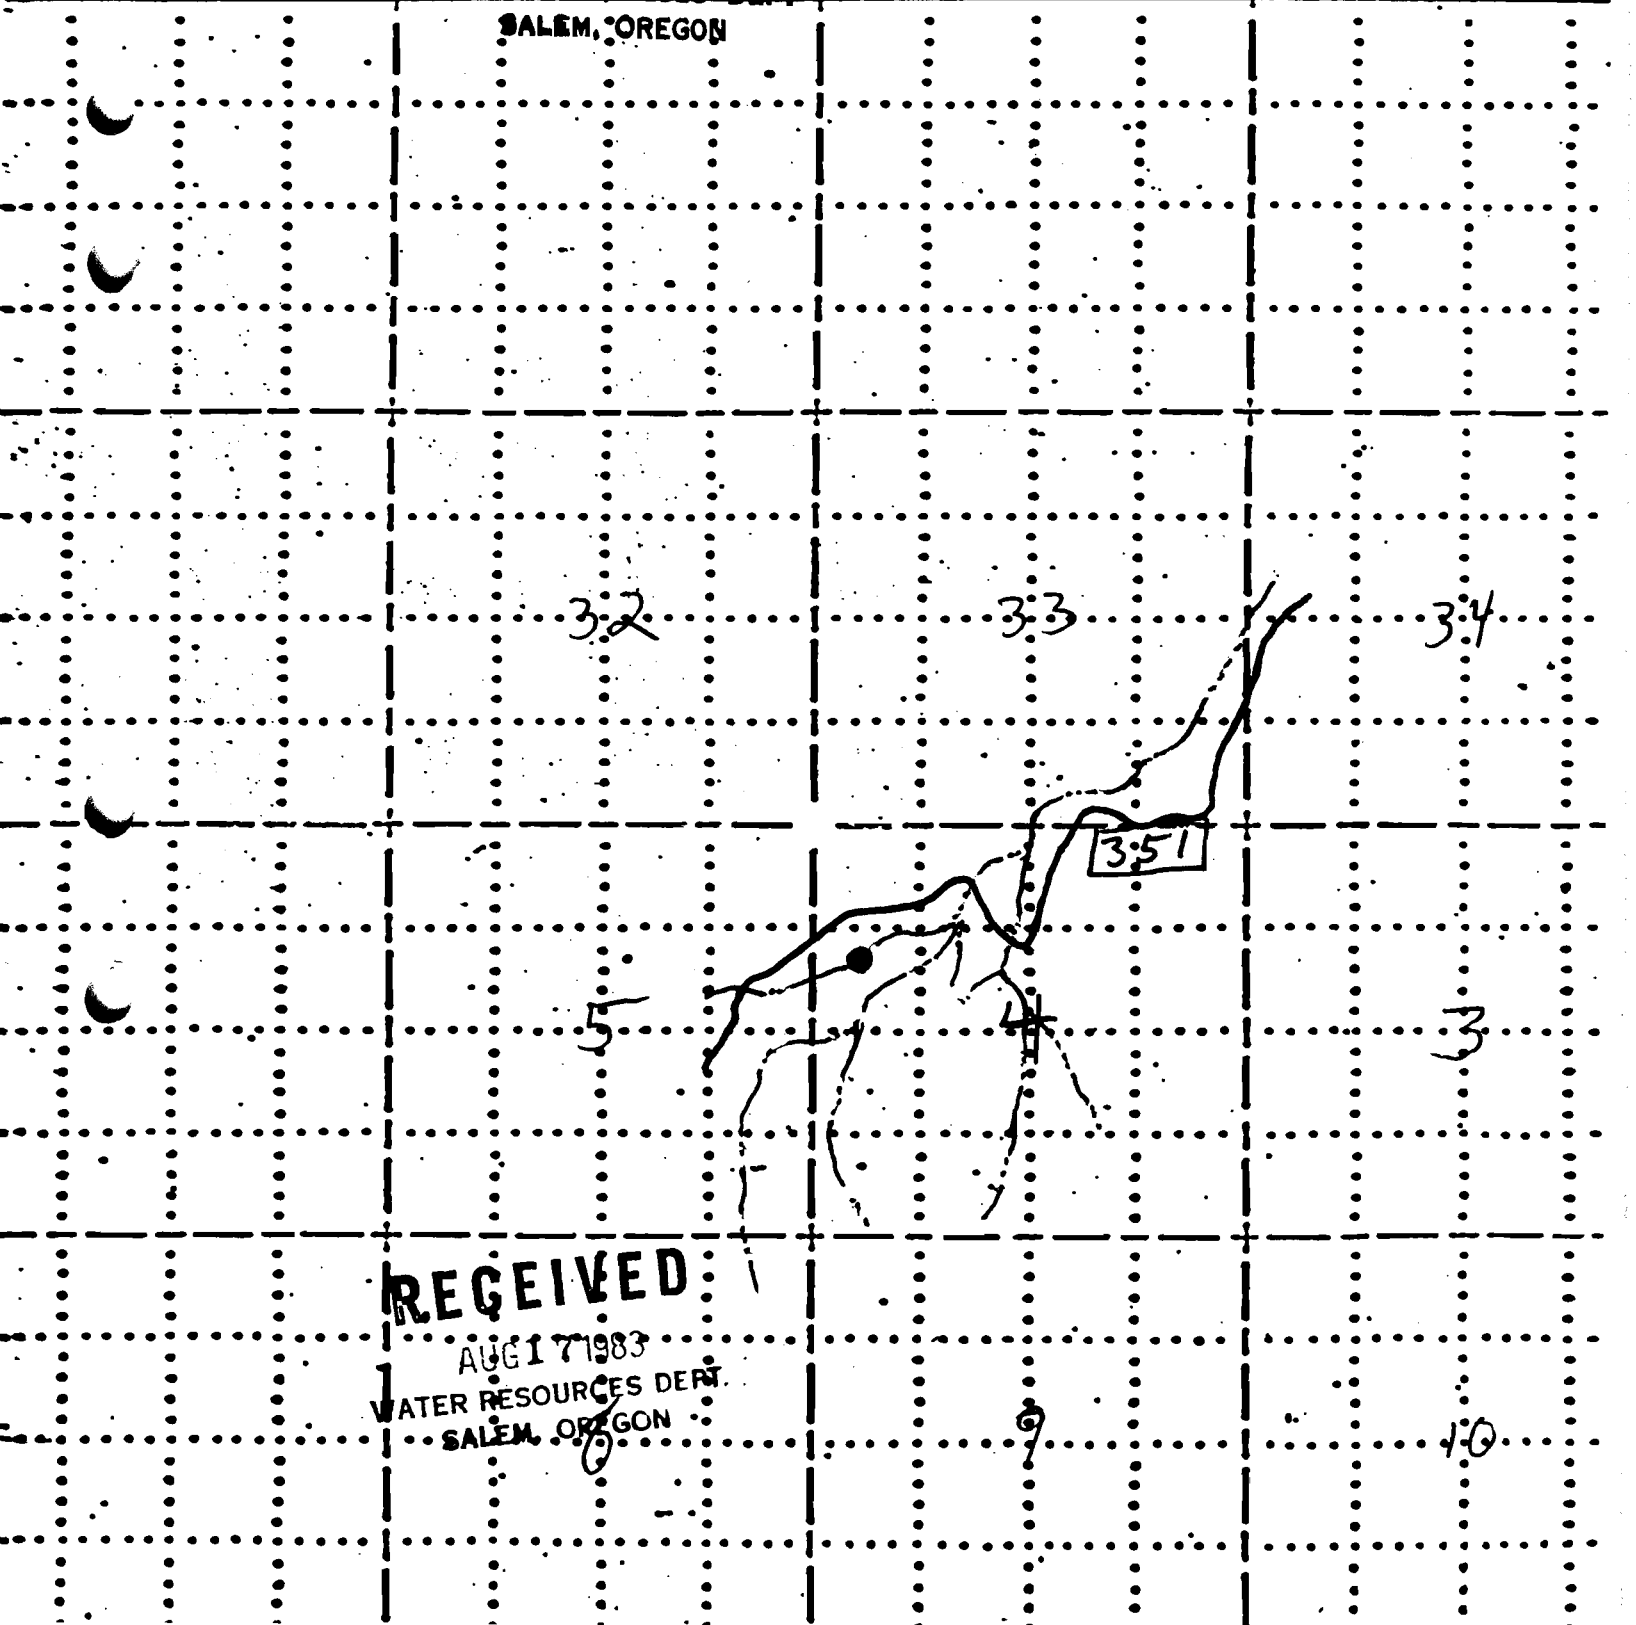

RECEIVED
AUG 17 1983
WATER RESOURCES DEPT.
SALEM, OREGON

Application NO. K-64177

Permit No. R 9708

U.S. DEPARTMENT OF AGRICULTURE RECEIVED


FOREST SERVICE

SEP 17 1981

FREMONT NATIONAL FOREST WATER RESOURCES DEPT
SALEM, OREGON

R.19 E.

120° 30'
42° 30'
T.35 S.

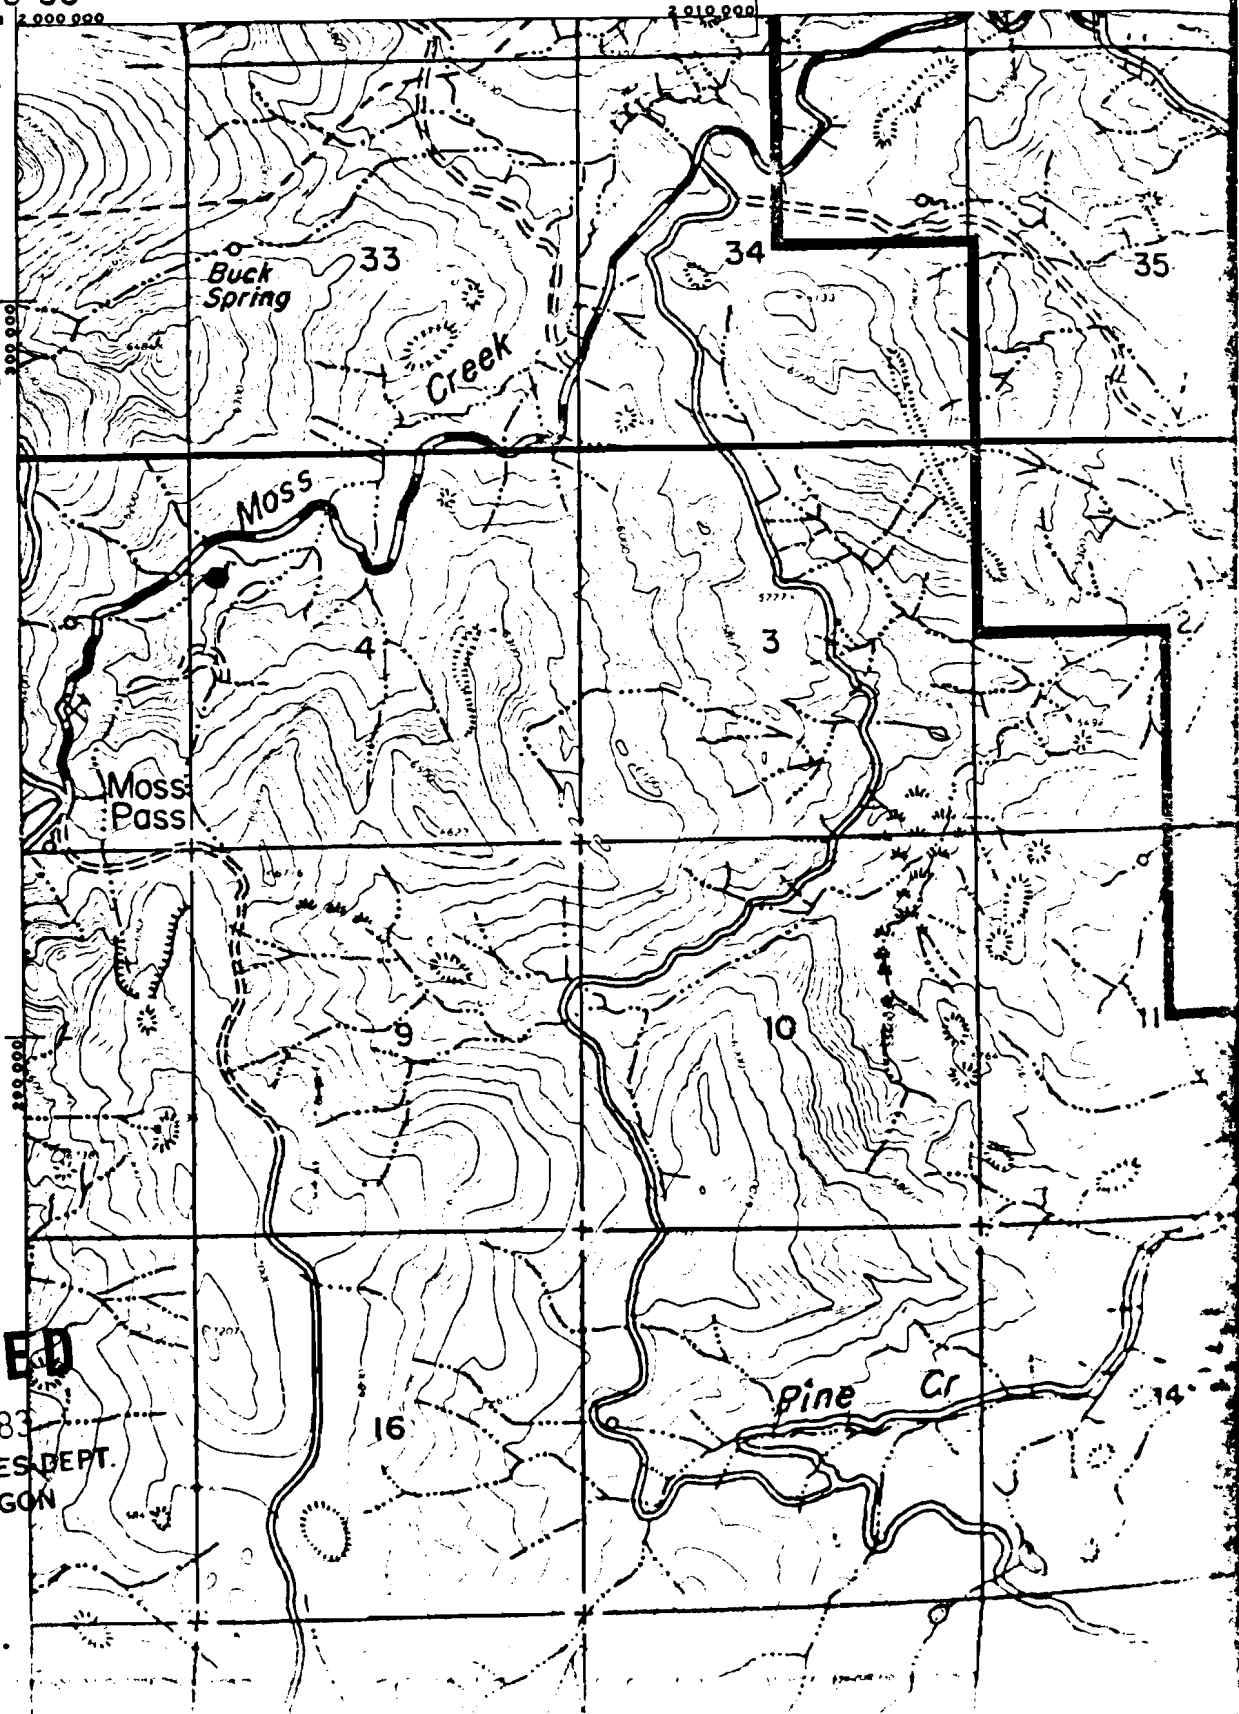

RECEIVED

AUG 17 1981
WATER RESOURCES DEPT.
SALEM, OREGON

T.36 S.