

FIELD MAP SHEET

Application No. R-62795

Permit No. R 9709

T. 36S R. 18E Sec. Subdiv. FREMONT N.F.

Mapped by T. OLENICHAK Reviewed by Scale 2 inches = 1 Mile

● RESERVOIR

— DRAINAGE

— ROAD

RECEIVED

SEP 17 1981

8/18, 1981

WATER RESOURCES DEPT
SALEM, OREGON

29

28


32

33

RECEIVED

AUG 17 1983

WATER RESOURCES DEPT
SALEM, OREGON

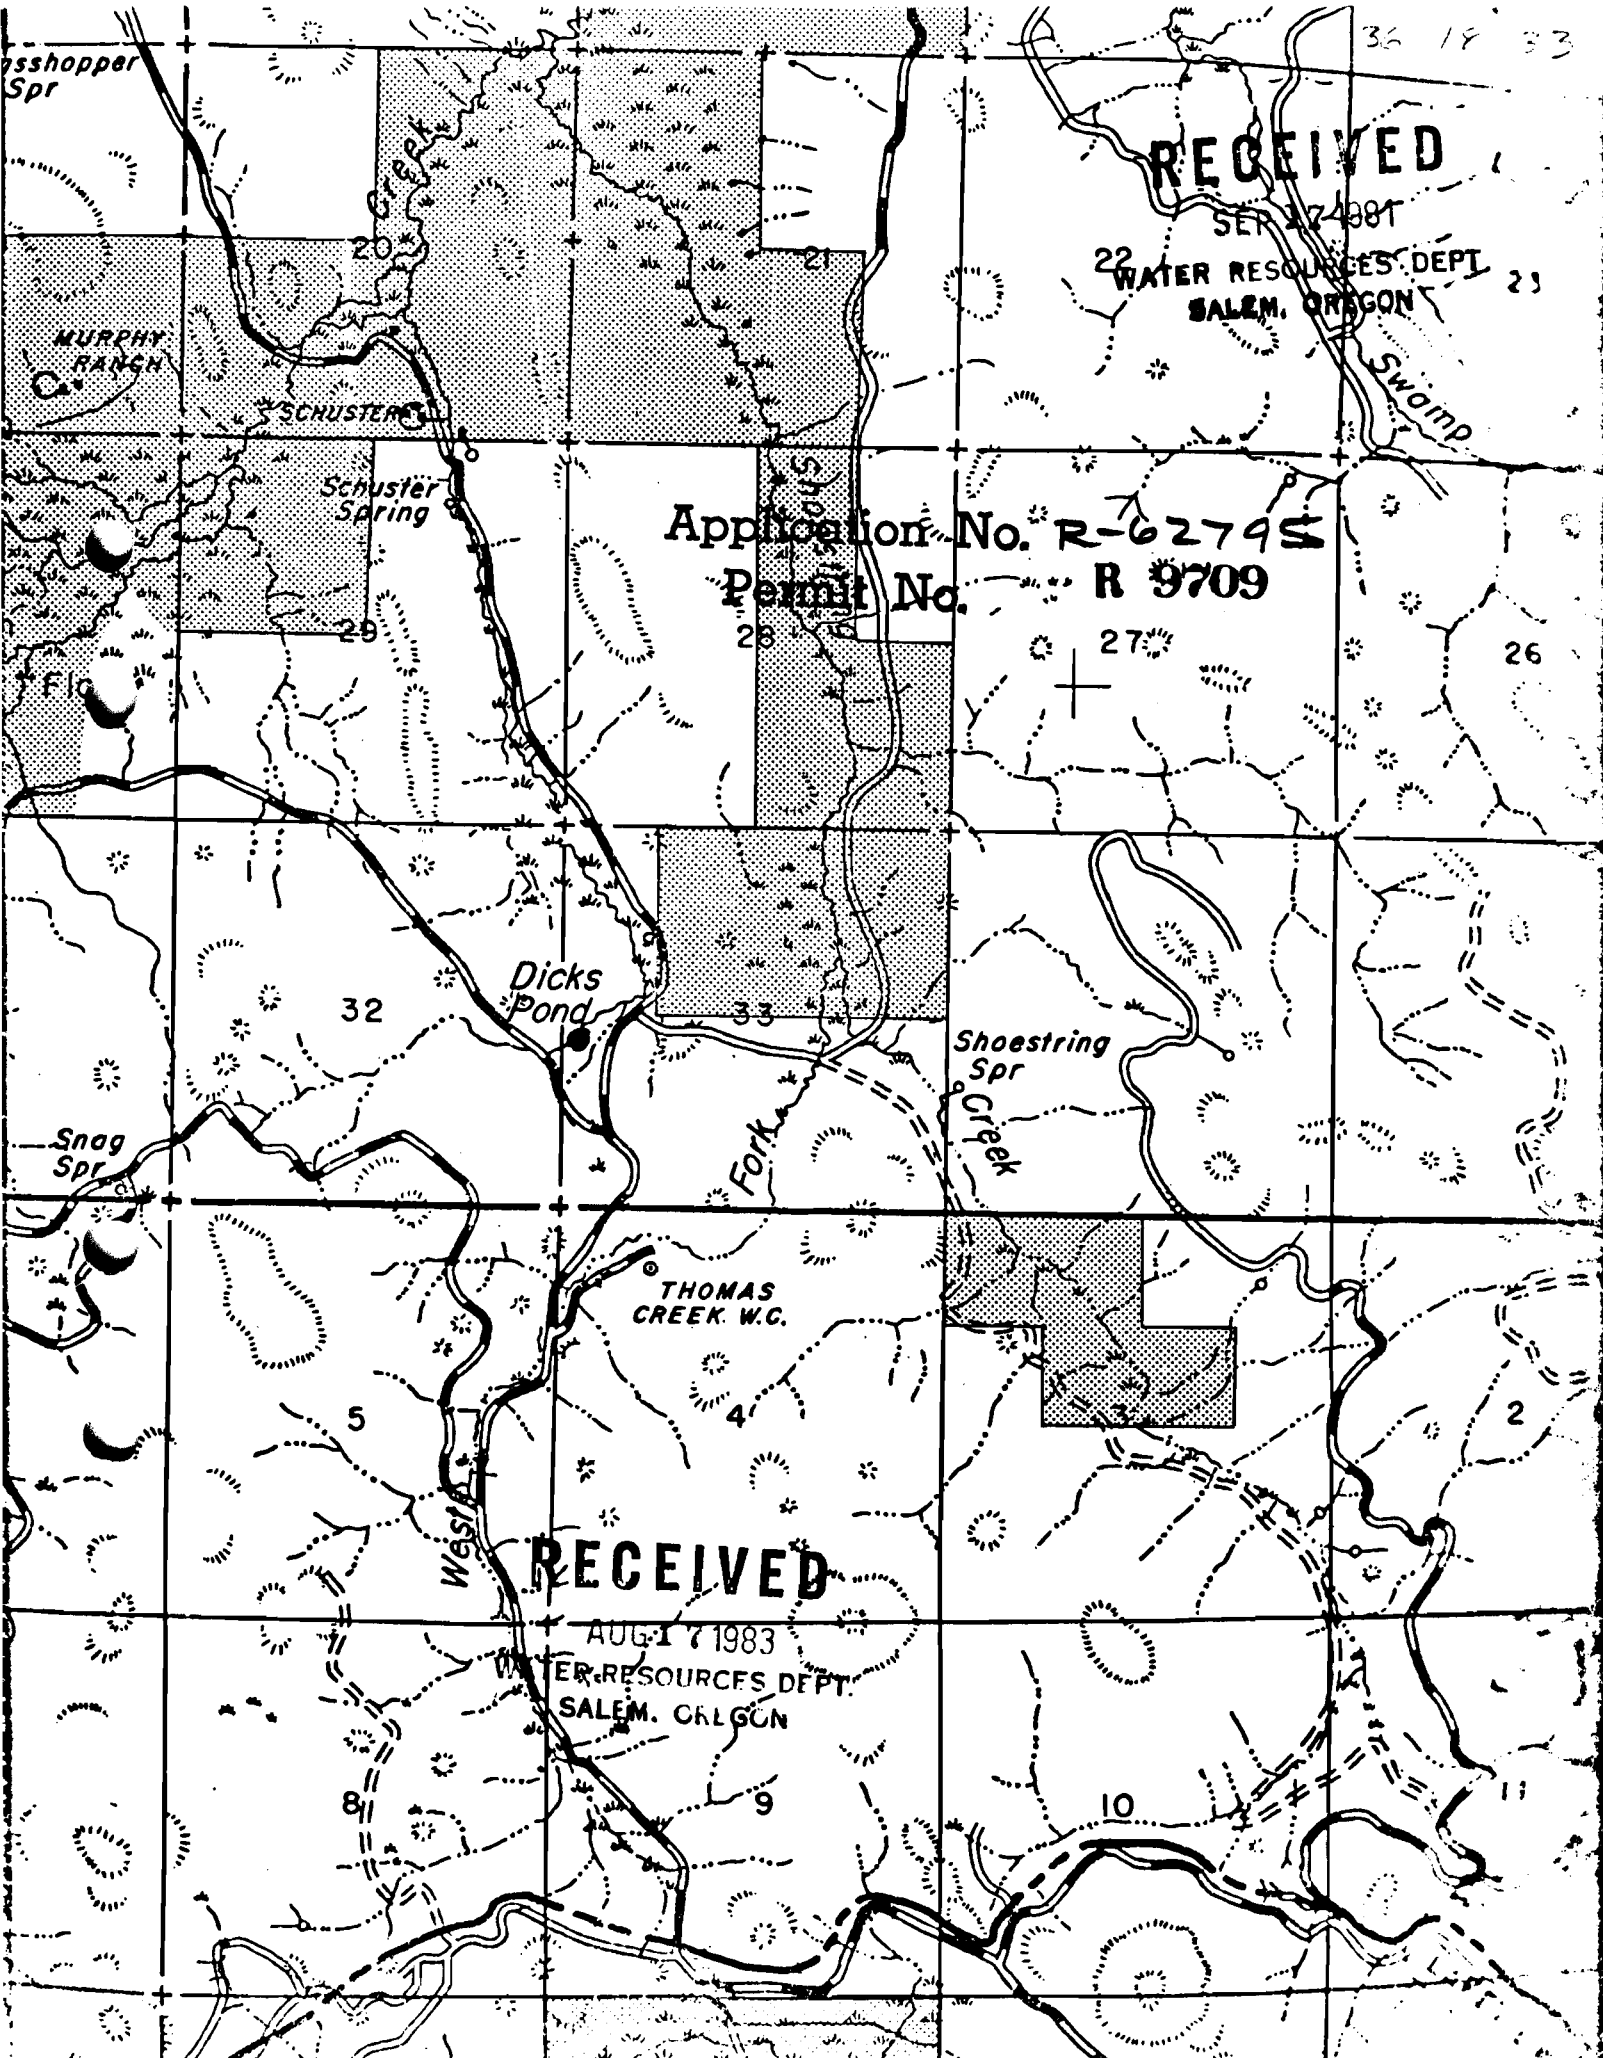

36 18 33

RECEIVED

SEP 17 1981

22 WATER RESOURCES DEPT
SALEM, OREGON

23

Swamp

Application No. R-62795
Permit No. R 9709

29

28

27

26

32

33

Dicks Pond

Shoestring Spr

Fork

THOMAS CREEK W.C.

RECEIVED

AUG 17 1983

WATER RESOURCES DEPT
SALEM, OREGON

8

9

10

11