

Application No. R-62796
FIELD MAP SHEET
Permit No R 9710

T. 36S R. 18E Sec. _____ Subdiv. _____ FREMONT N.F.

Mapped by T. OLENICHAK Reviewed by _____ Scale 2 inches = 1 Mile


- RESERVOIR
- DRAINAGE
- ROAD

RECEIVED

SEP 17 1981

8/18, 19 81


WATER RESOURCES DEPT
SALEM, OREGON

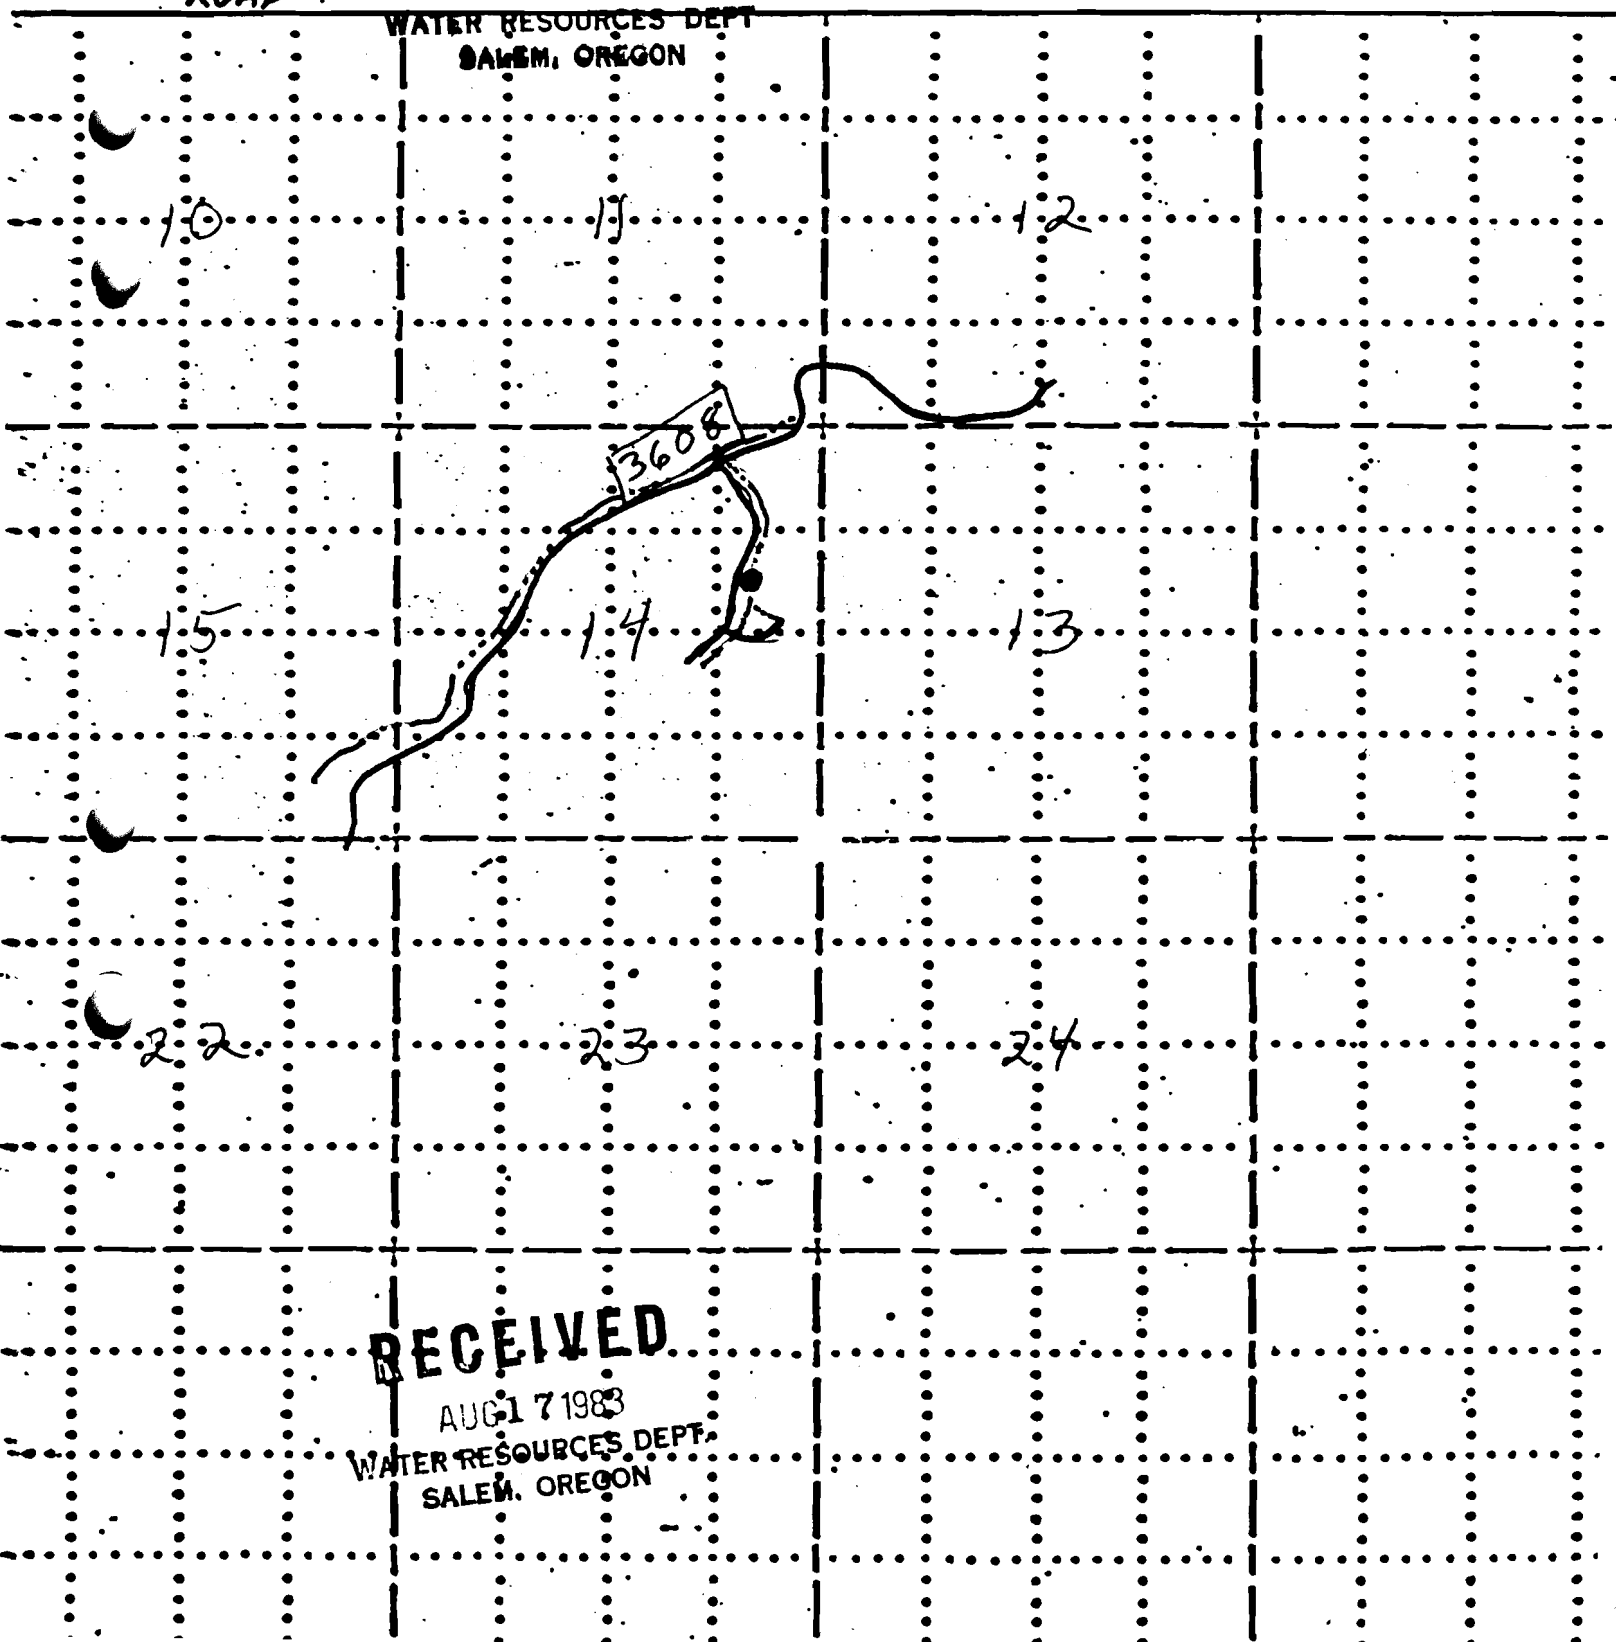

RECEIVED

AUG 17 1983

WATER RESOURCES DEPT.
SALEM, OREGON

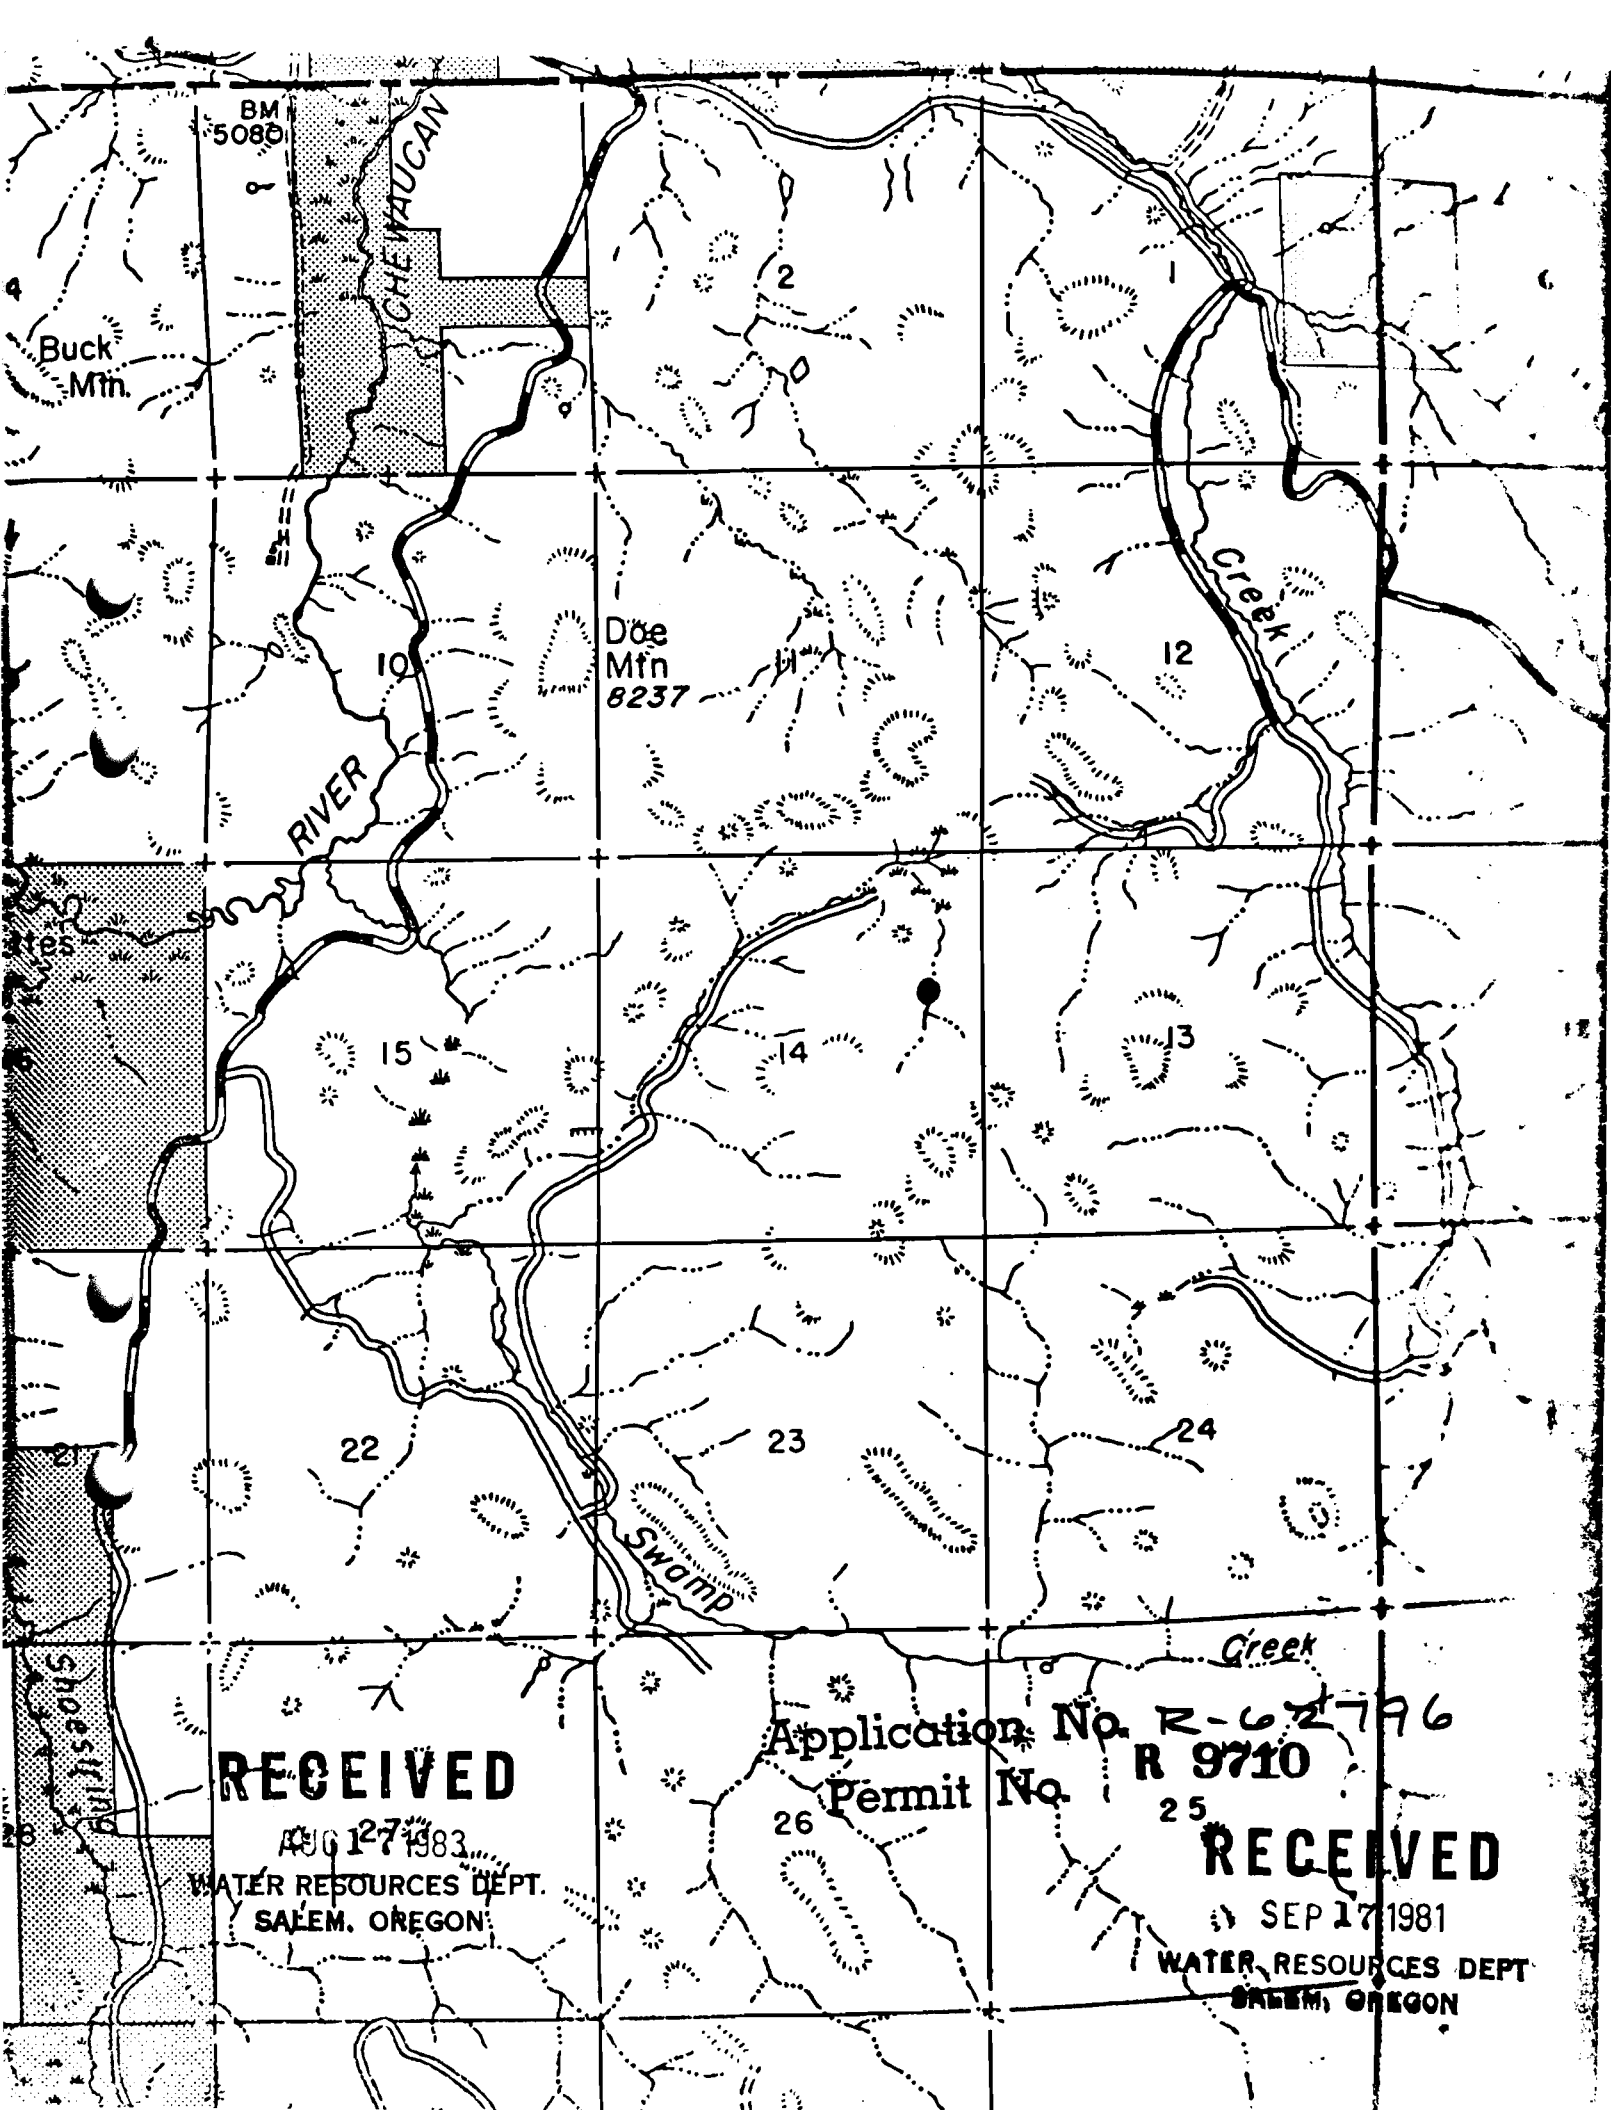

RECEIVED

AUG 127 1983

WATER RESOURCES DEPT.
SALEM, OREGON

Application No. R-62796
Permit No. R 9710

RECEIVED

SEP 17 1981

WATER RESOURCES DEPT.
SALEM, OREGON