

Application No. **R-62797**
FIELD MAP SHEET

Permit No. **R 9711**

T. 36S R. 17E Sec. _____ Subdiv. _____ FREMONT N.F.


Mapped by T. OLENICHAK Reviewed by _____ Scale 2 inches = 1 Mile

RECEIVED

8/18, 1981

SEP 17 1981


WATER RESOURCES DEPT
 SALEM, OREGON

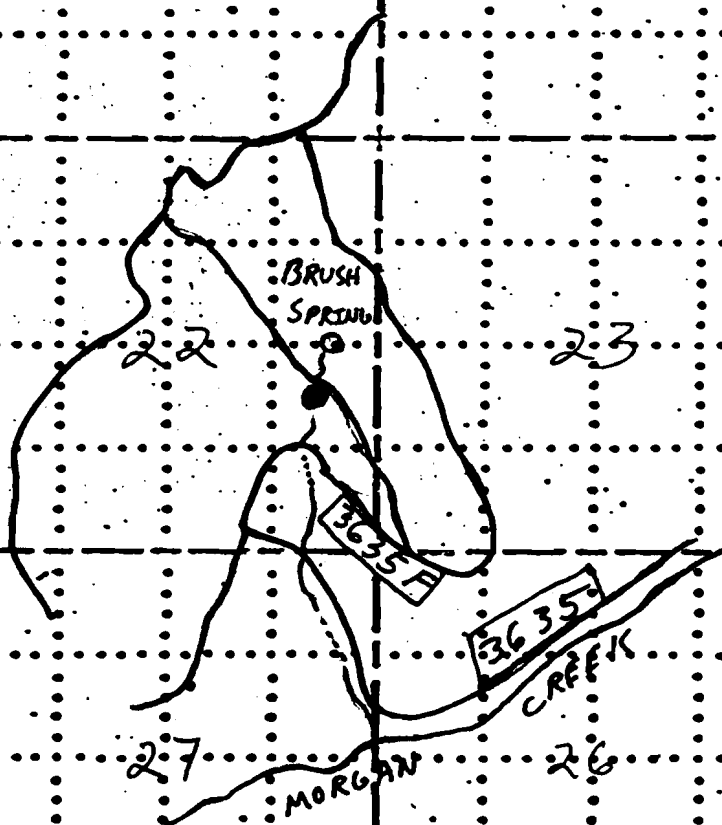

RECEIVED

AUG 17 1983

WATER RESOURCES DEPT.
 SALEM, OREGON

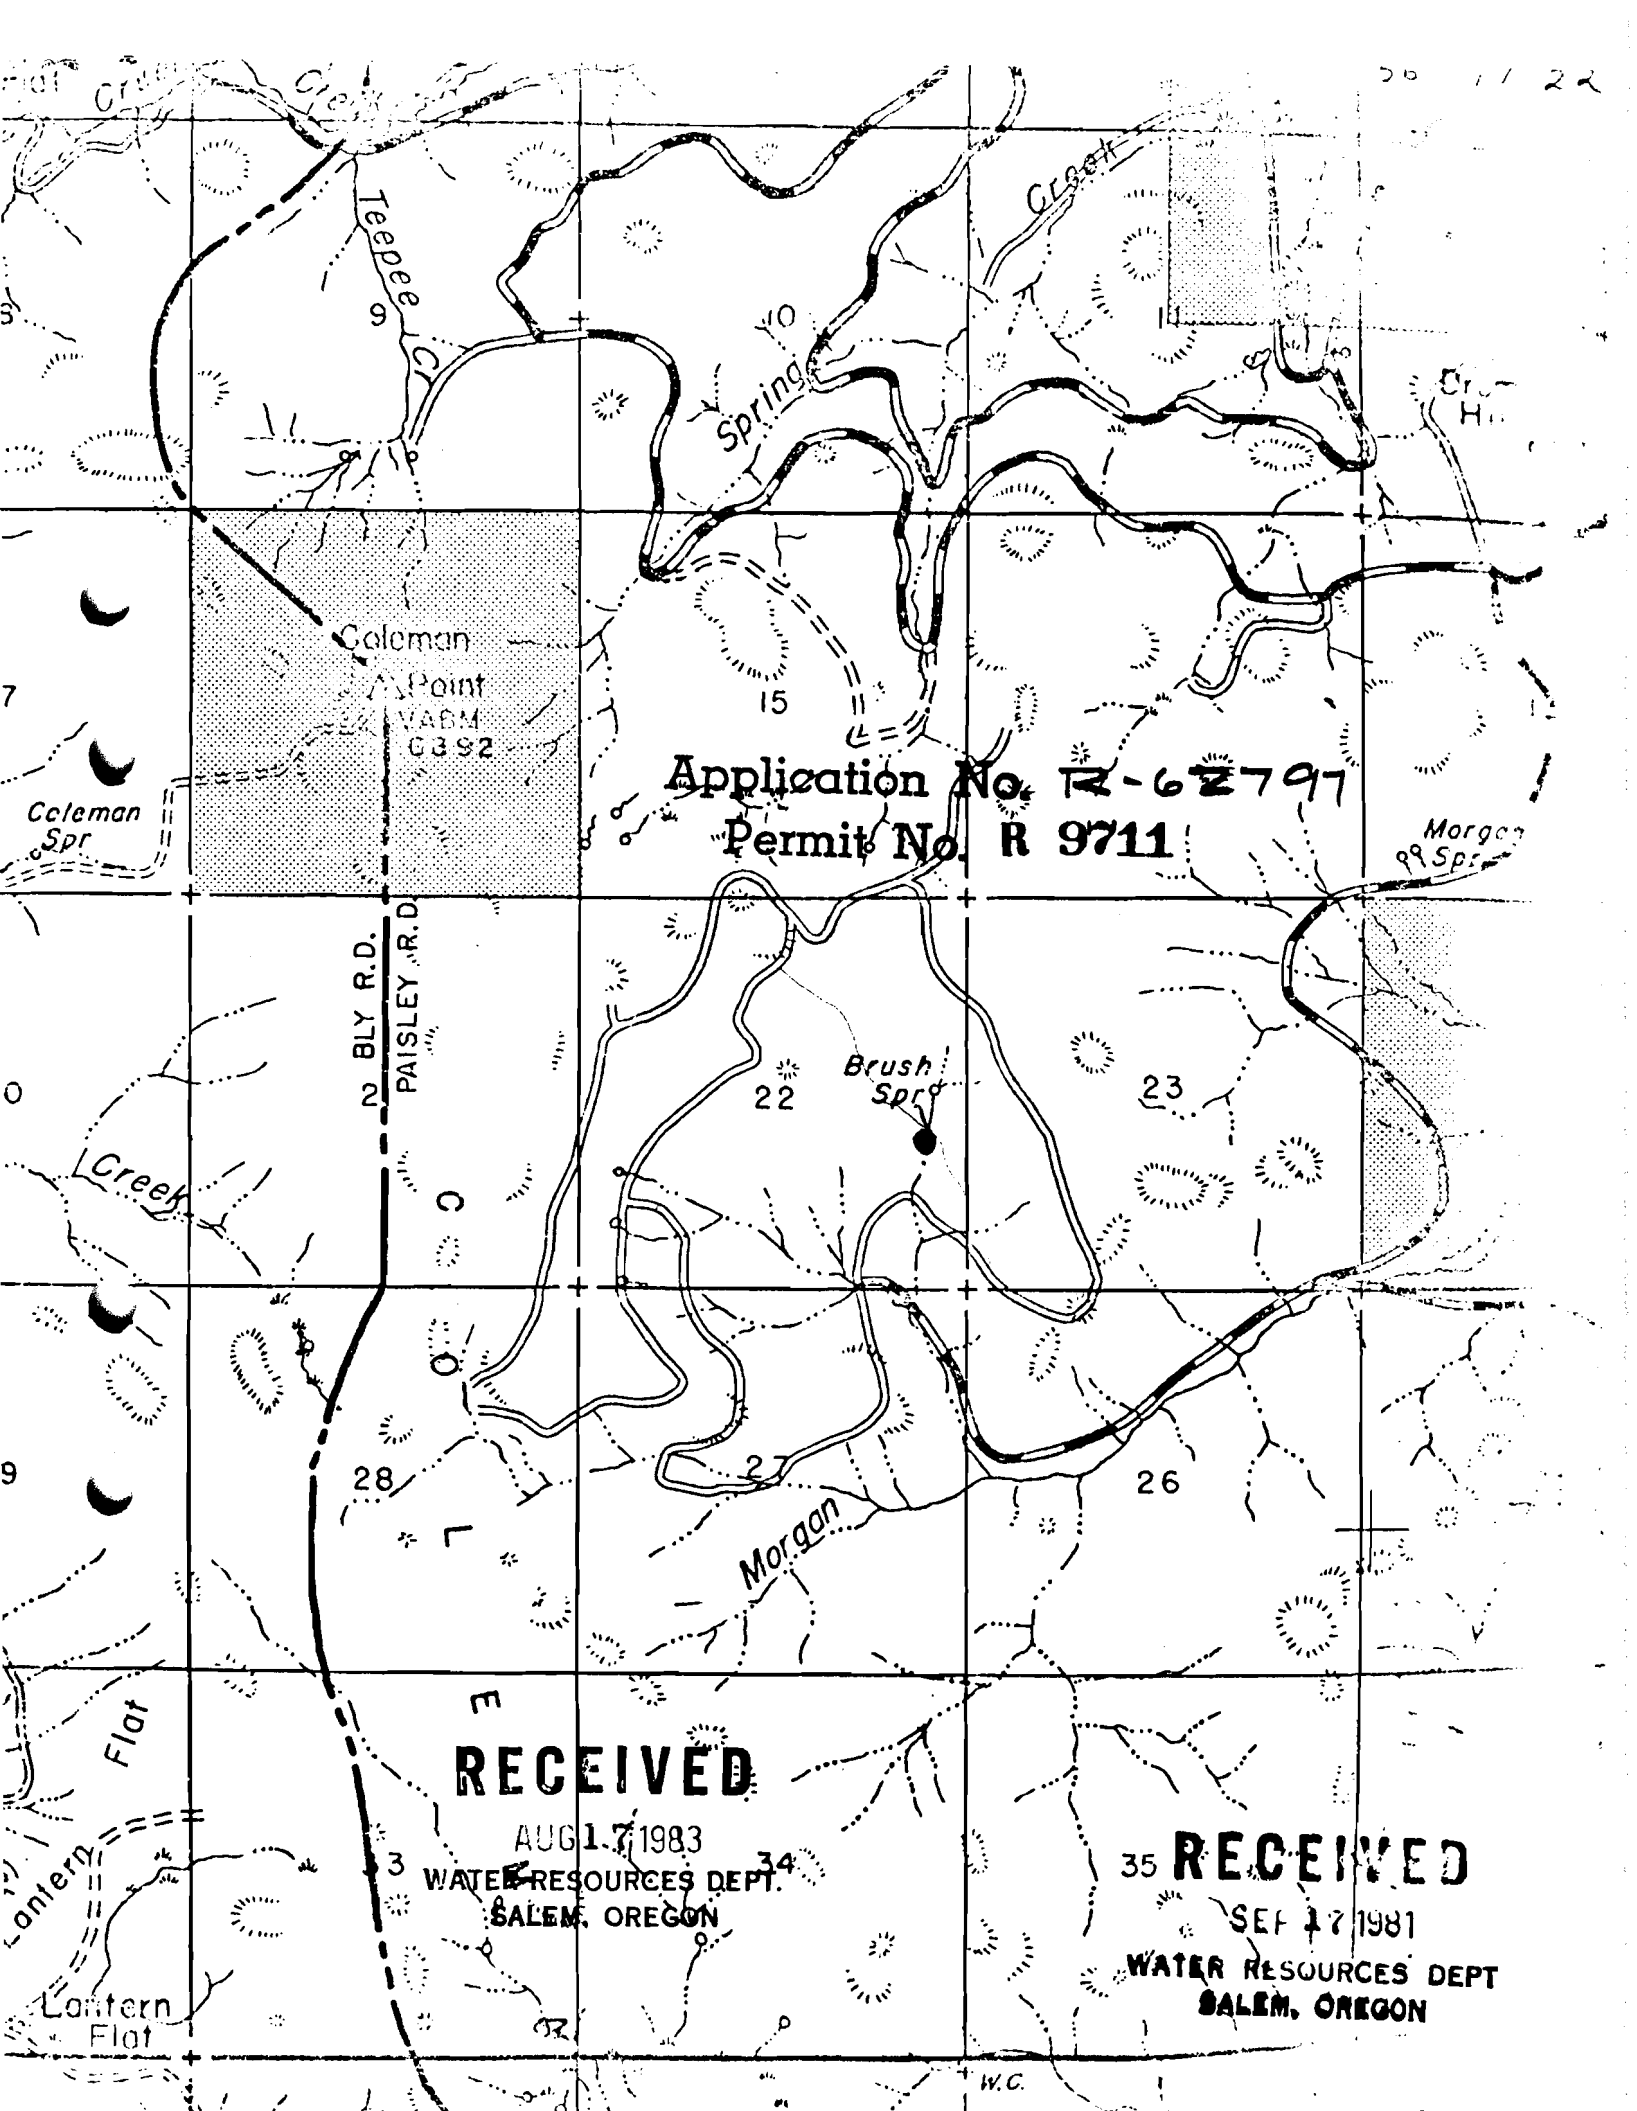

Application No. **R-62797**
Permit No. **R 9711**

RECEIVED

AUG 17 1983
WATER RESOURCES DEPT.
SALEM, OREGON

RECEIVED

SEP 17 1981
WATER RESOURCES DEPT.
SALEM, OREGON