

FIELD MAP SHEET Application No. R-62798

Permit No. R 9712

T. 35S R. 18E/19E Sec. Subdiv. FREMONT N.F.


Mapped by J. OLENICHAH Reviewed by Scale 2 inches = 1 Mile

RECEIVED

8/18, 1981

SEP 17 1981


WATER RESOURCES DEPT
SALEM, OREGON

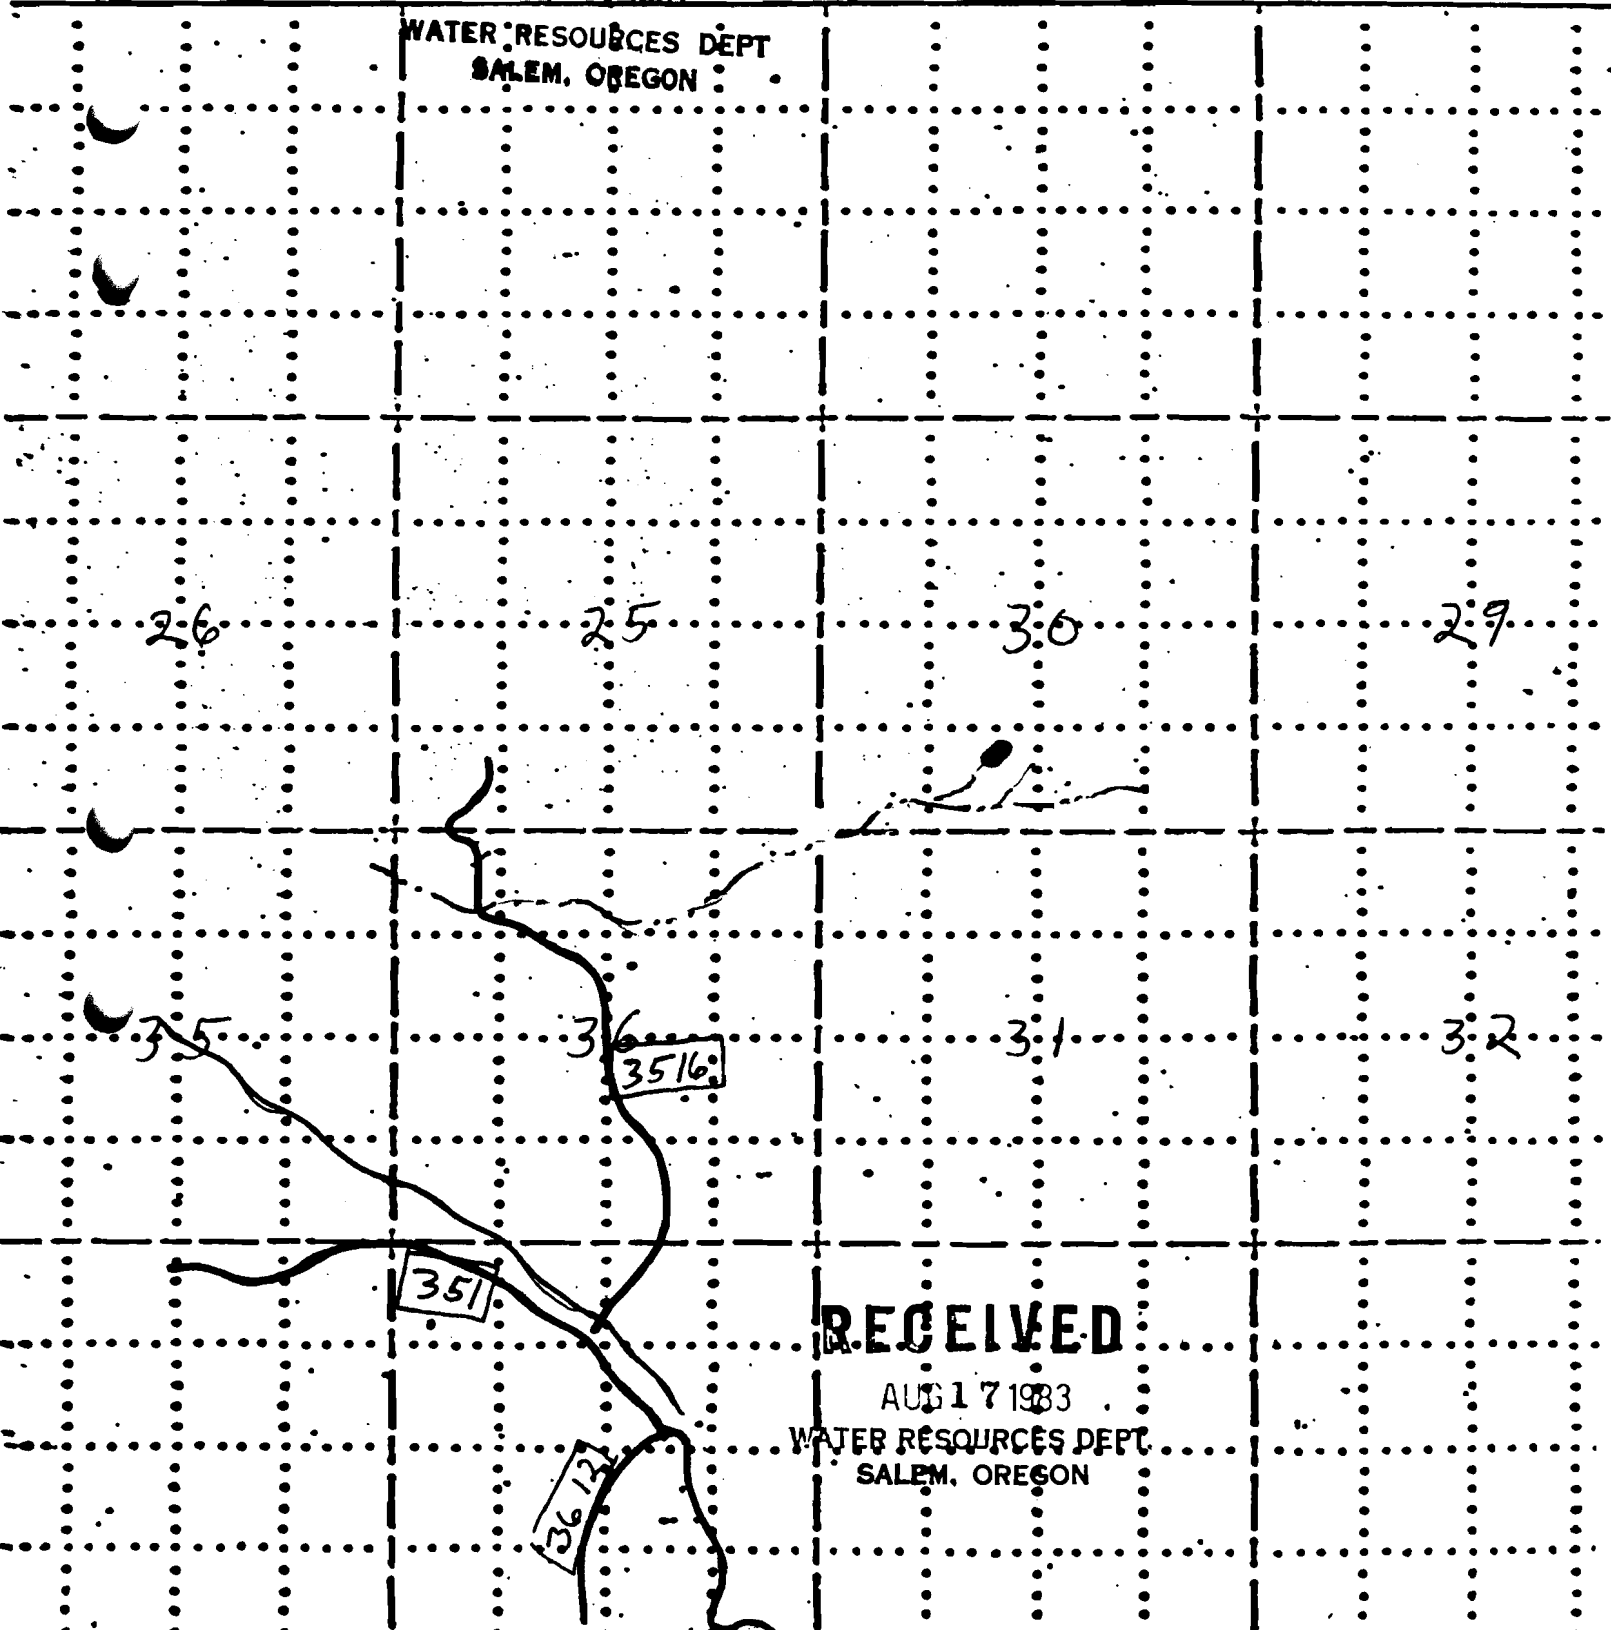

RECEIVED

AUG 17 1983

WATER RESOURCES DEPT
SALEM, OREGON

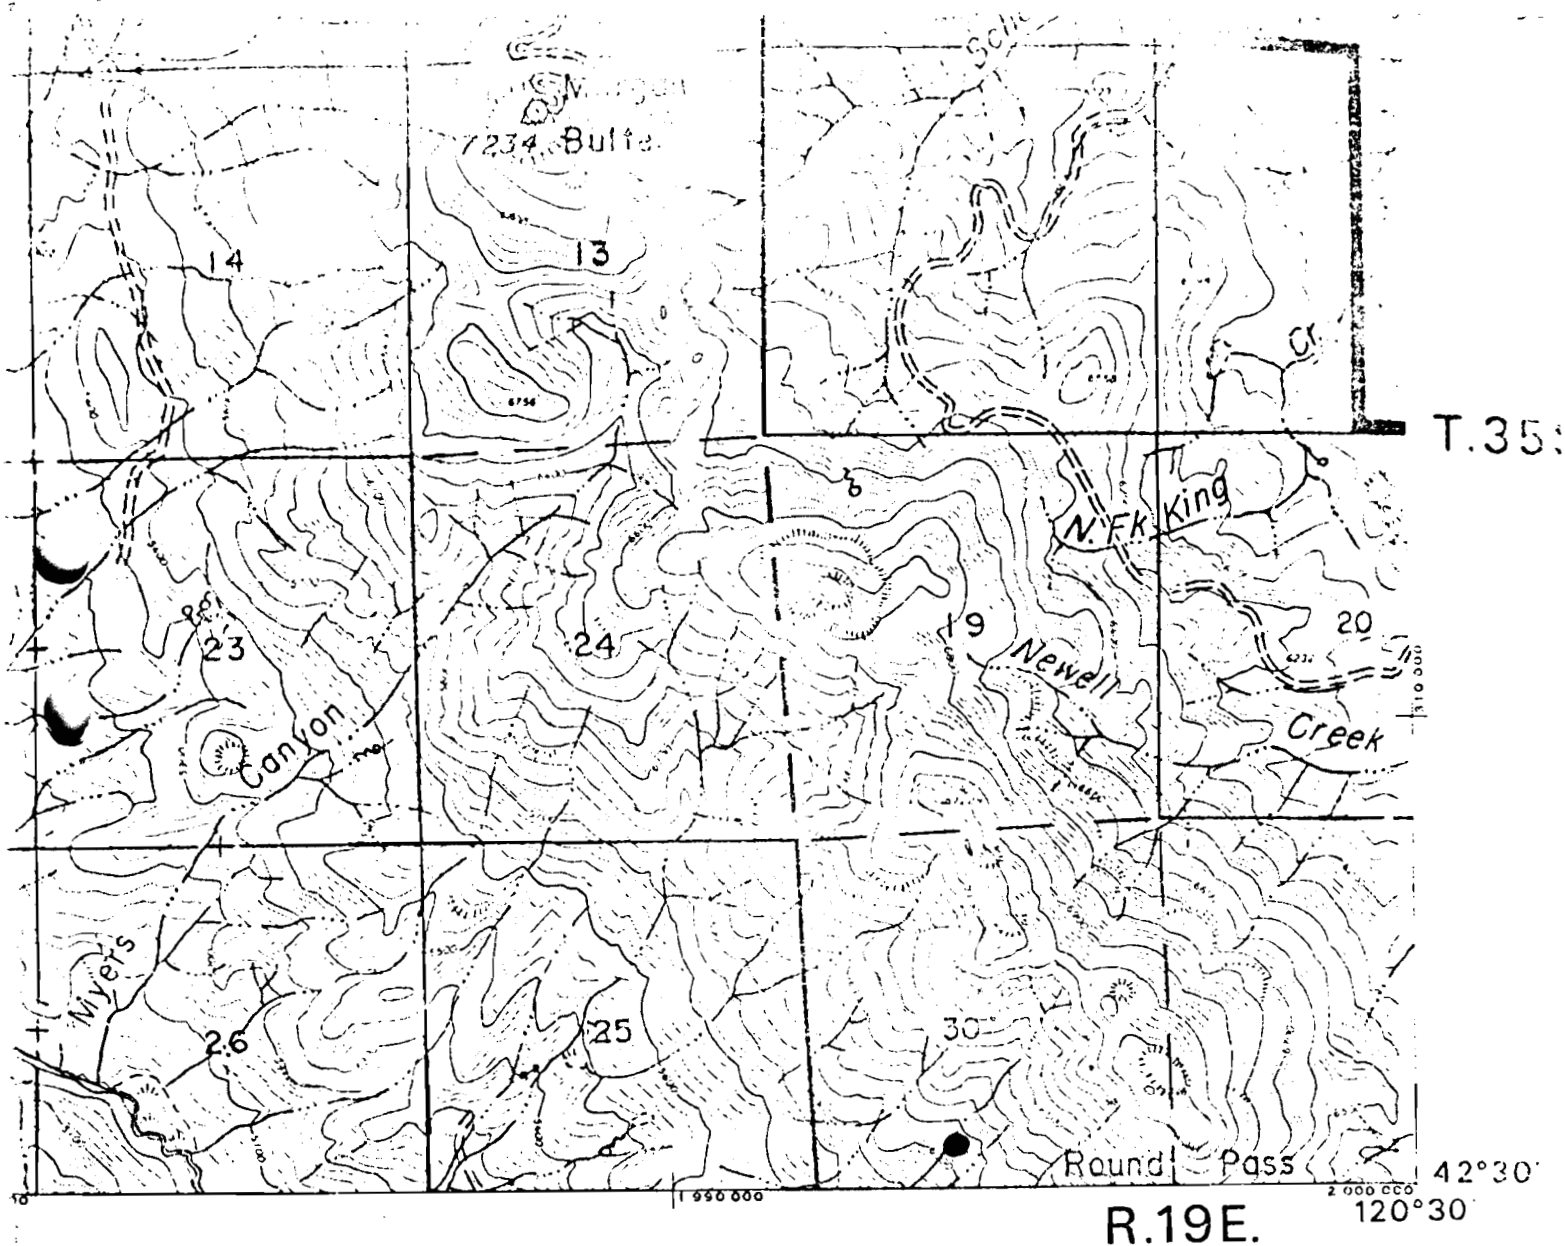

Application No. **R-62798**

Permit No. **R 9712**

ROAD CLASSIFICATION


HEAVY DUTY ALL WEATHER

DRY WEATHER


Paved Road




Dirt Road

 

Rock Surface Road

 

Primitive Road

 

U. S. Route



State Route



RECEIVED

SEP 17 1981

WATER RESOURCES DEPT.
SALEM, OREGON

RECEIVED

AUG 17 1983

WATER RESOURCES DEPT.
SALEM, OREGON

PAISLEY, OREGON

433

RECEIVED

SEP 17 1981

WATER RESOURCES DEPT
SALEM, OREGON

35 19 30

Application No. R-62798


Permit No. R 9712

VISTILLAS I QUADRANGLE
OREGON

R.19 E.

120°30'

42°30'

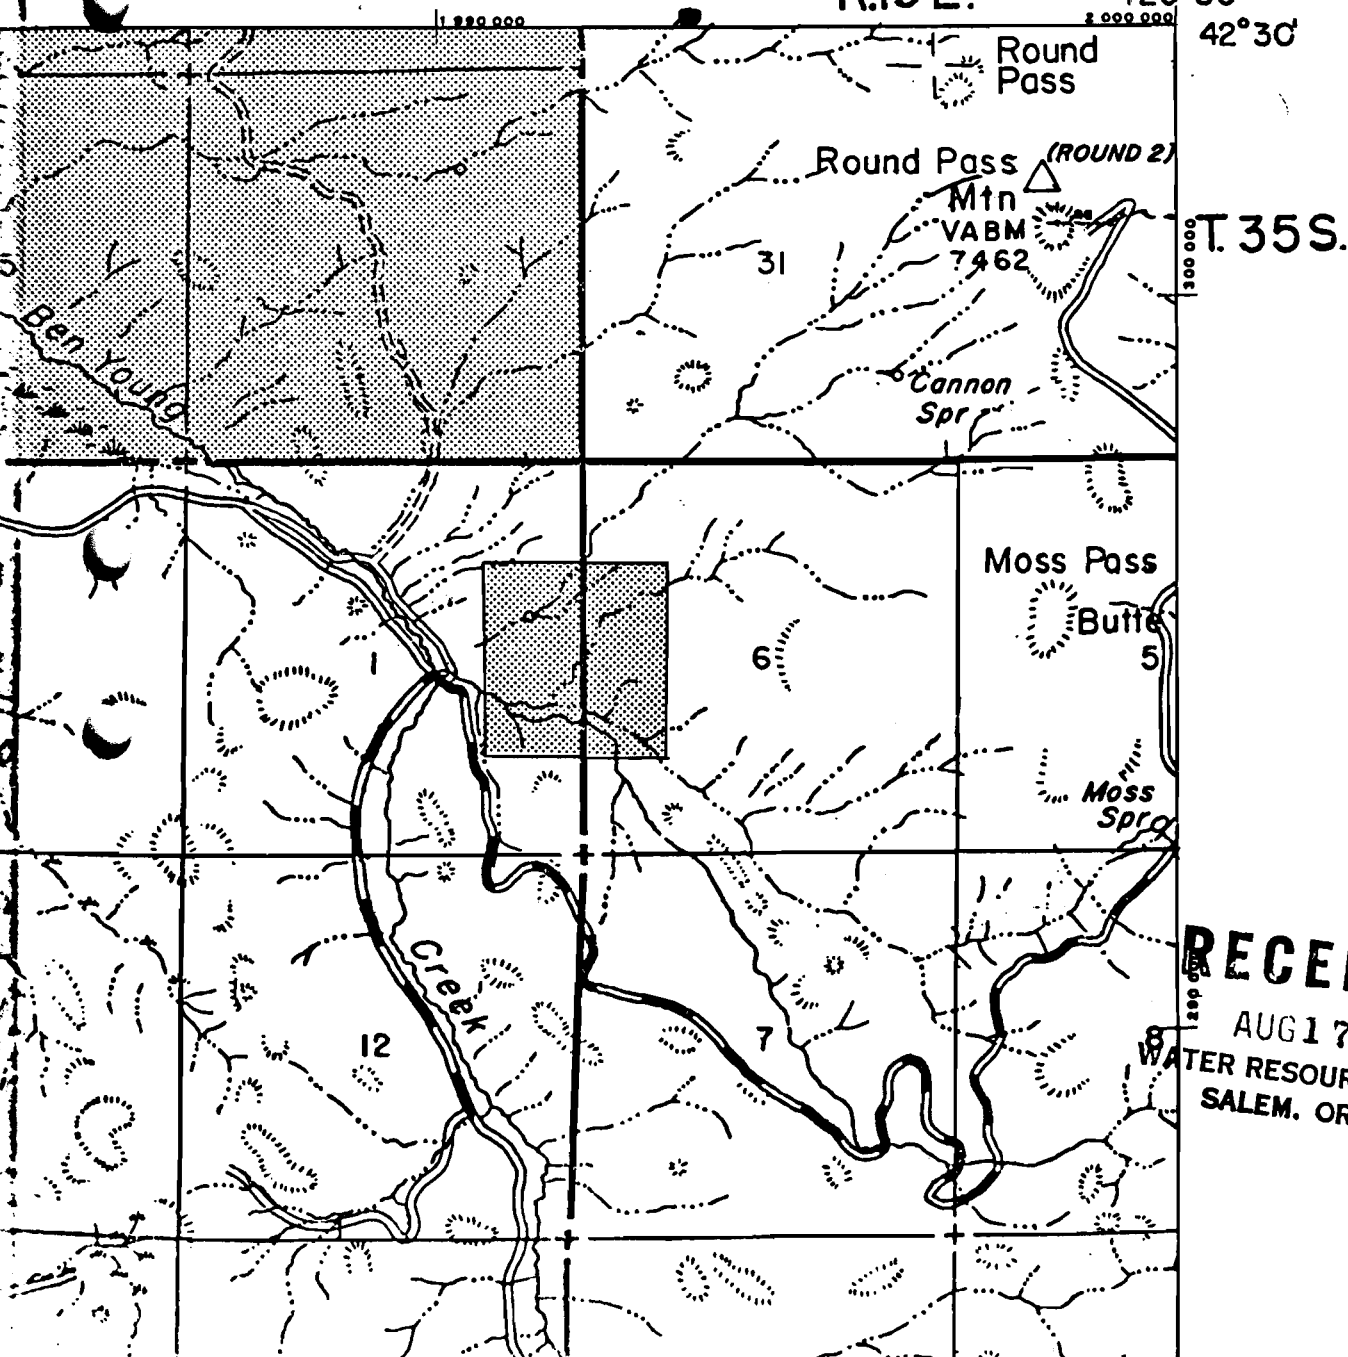

RECEIVED

AUG 17 1983

WATER RESOURCES DEPT.
SALEM, OREGON