

RECEIVED

R-9915
59246

AUG 19 1981

FIELD MAP SHEET

WATER RESOURCES DEPT

SALEM, OREGON

FREEMONT

N.F.

T. 39S R. 15E Sec. Subdiv.

Mapped by T. OLENICHAK Reviewed by

Scale 2 inches = 1 Mile


- RESERVIOR
- DRAINAGE
- ROAD

Application No. R-62448

7/7, 1981

Permit No. R 9915

LITTLE
SQUAW
FLAT

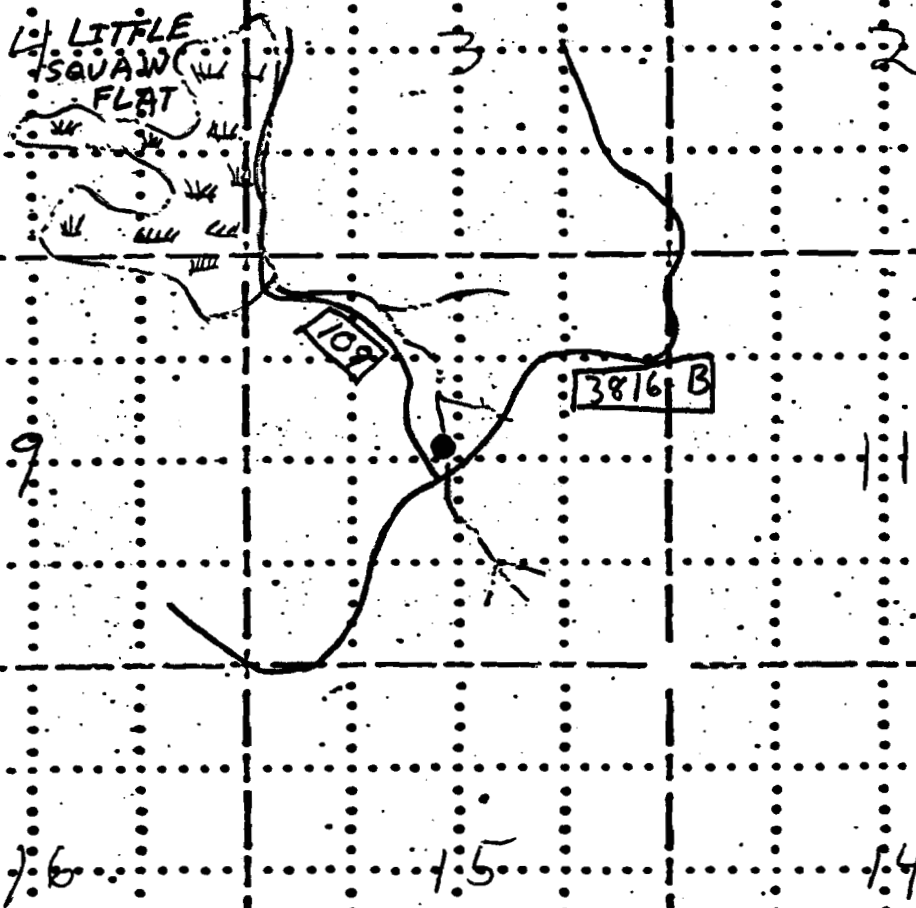

RECEIVED

MAY 11 1984

WATER RESOURCES DEPT
SALEM, OREGON

