

R-9917
RECEIVED 59248

FIELD MAP SHEET

AUG 19 1981

WATER RESOURCES DEPT.
SALEM, OREGON N.F.
FREMONT

T. 38S R. 14E Sec. _____ Subdiv. _____


Mapped by _____ Reviewed by _____ Scale 2 inches = 1 Mile

● **RESERVOIR** Application No. R-62465 7/20 _____, 19 81

— **DRAINAGE**

Permit No. R 9917

— **ROAD**

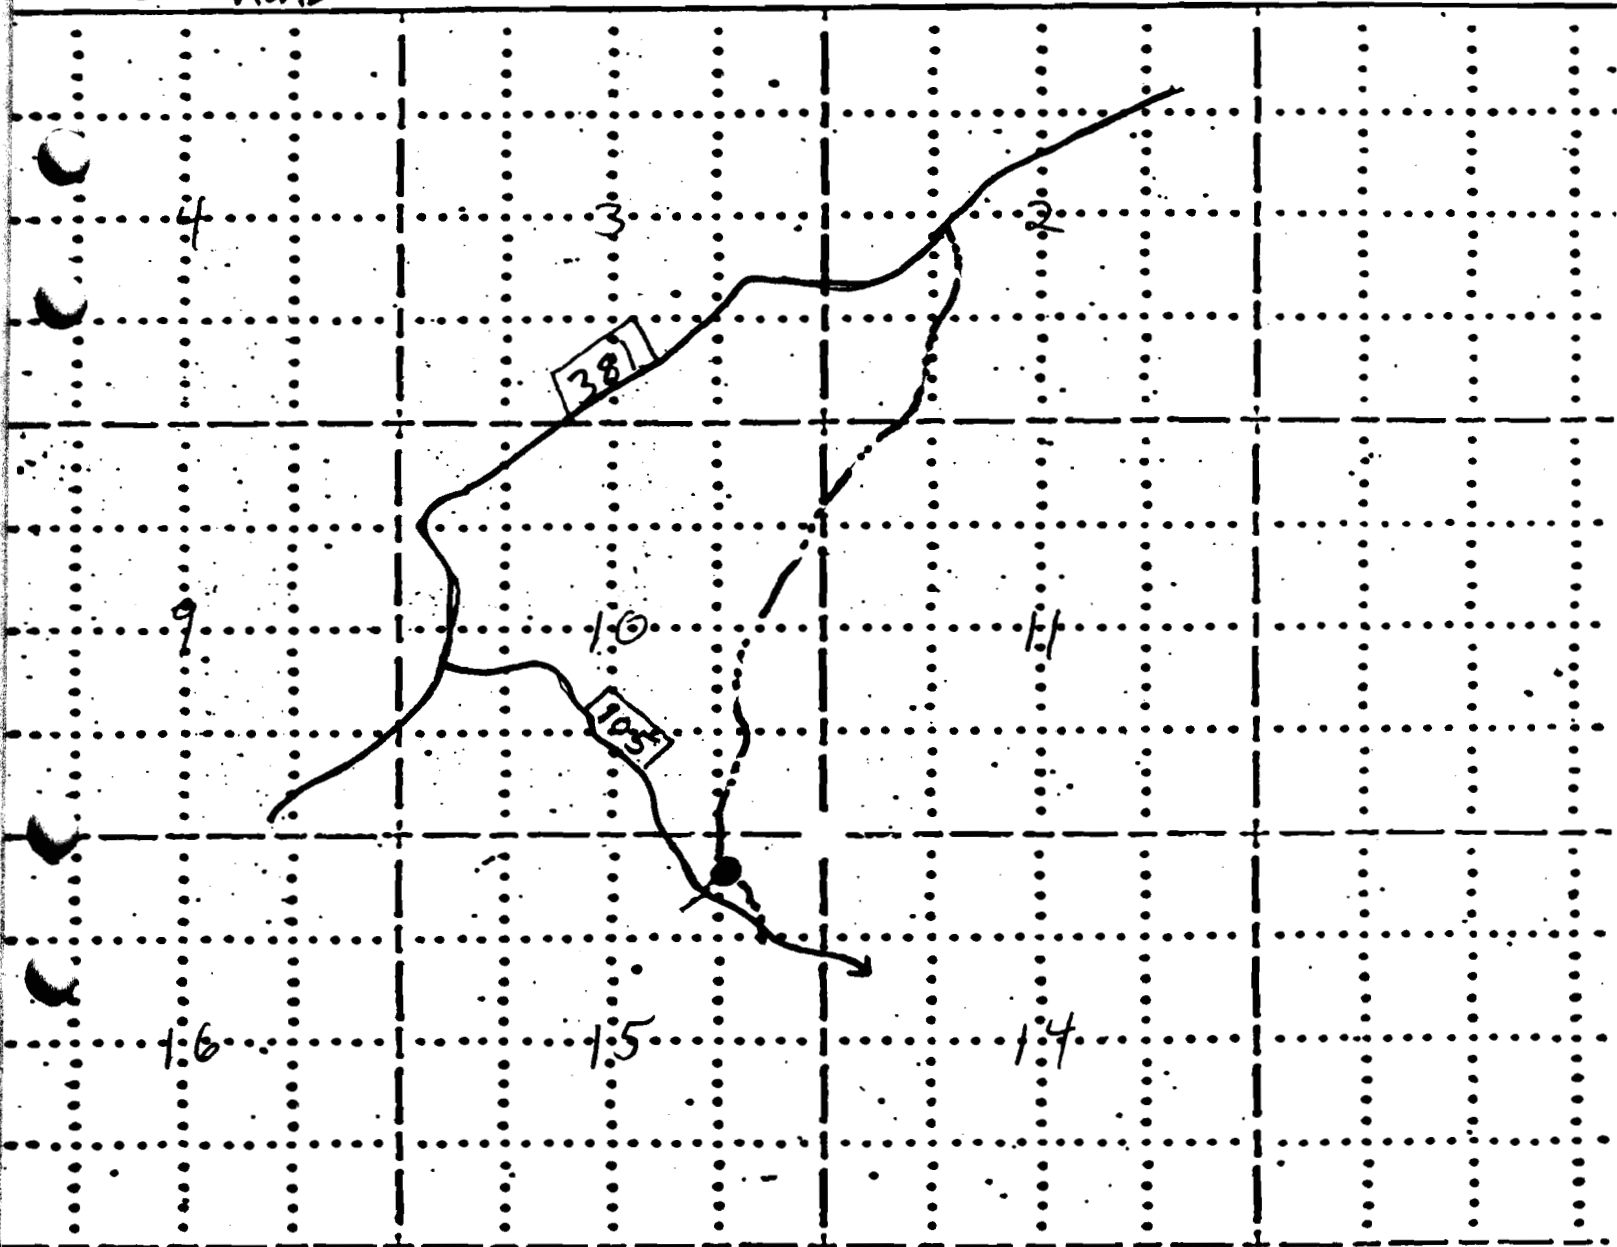

RECEIVED

AUG 17 1983
WATER RESOURCES DEPT.
SALEM, OREGON

WATER RESOURCES DEPT.
SALEM, OREGON
AUG 12 1983

RECEIVED

4 MILES

Application No. R-2445
Permit No. R 9917

ROAD CLASSIFICATION

DR
Dirt Road
Primitive
State R




HEAVY DUTY ALL WEATHER

Paved Road

Rock Surface Road

U.S. Route

BARNES VA.

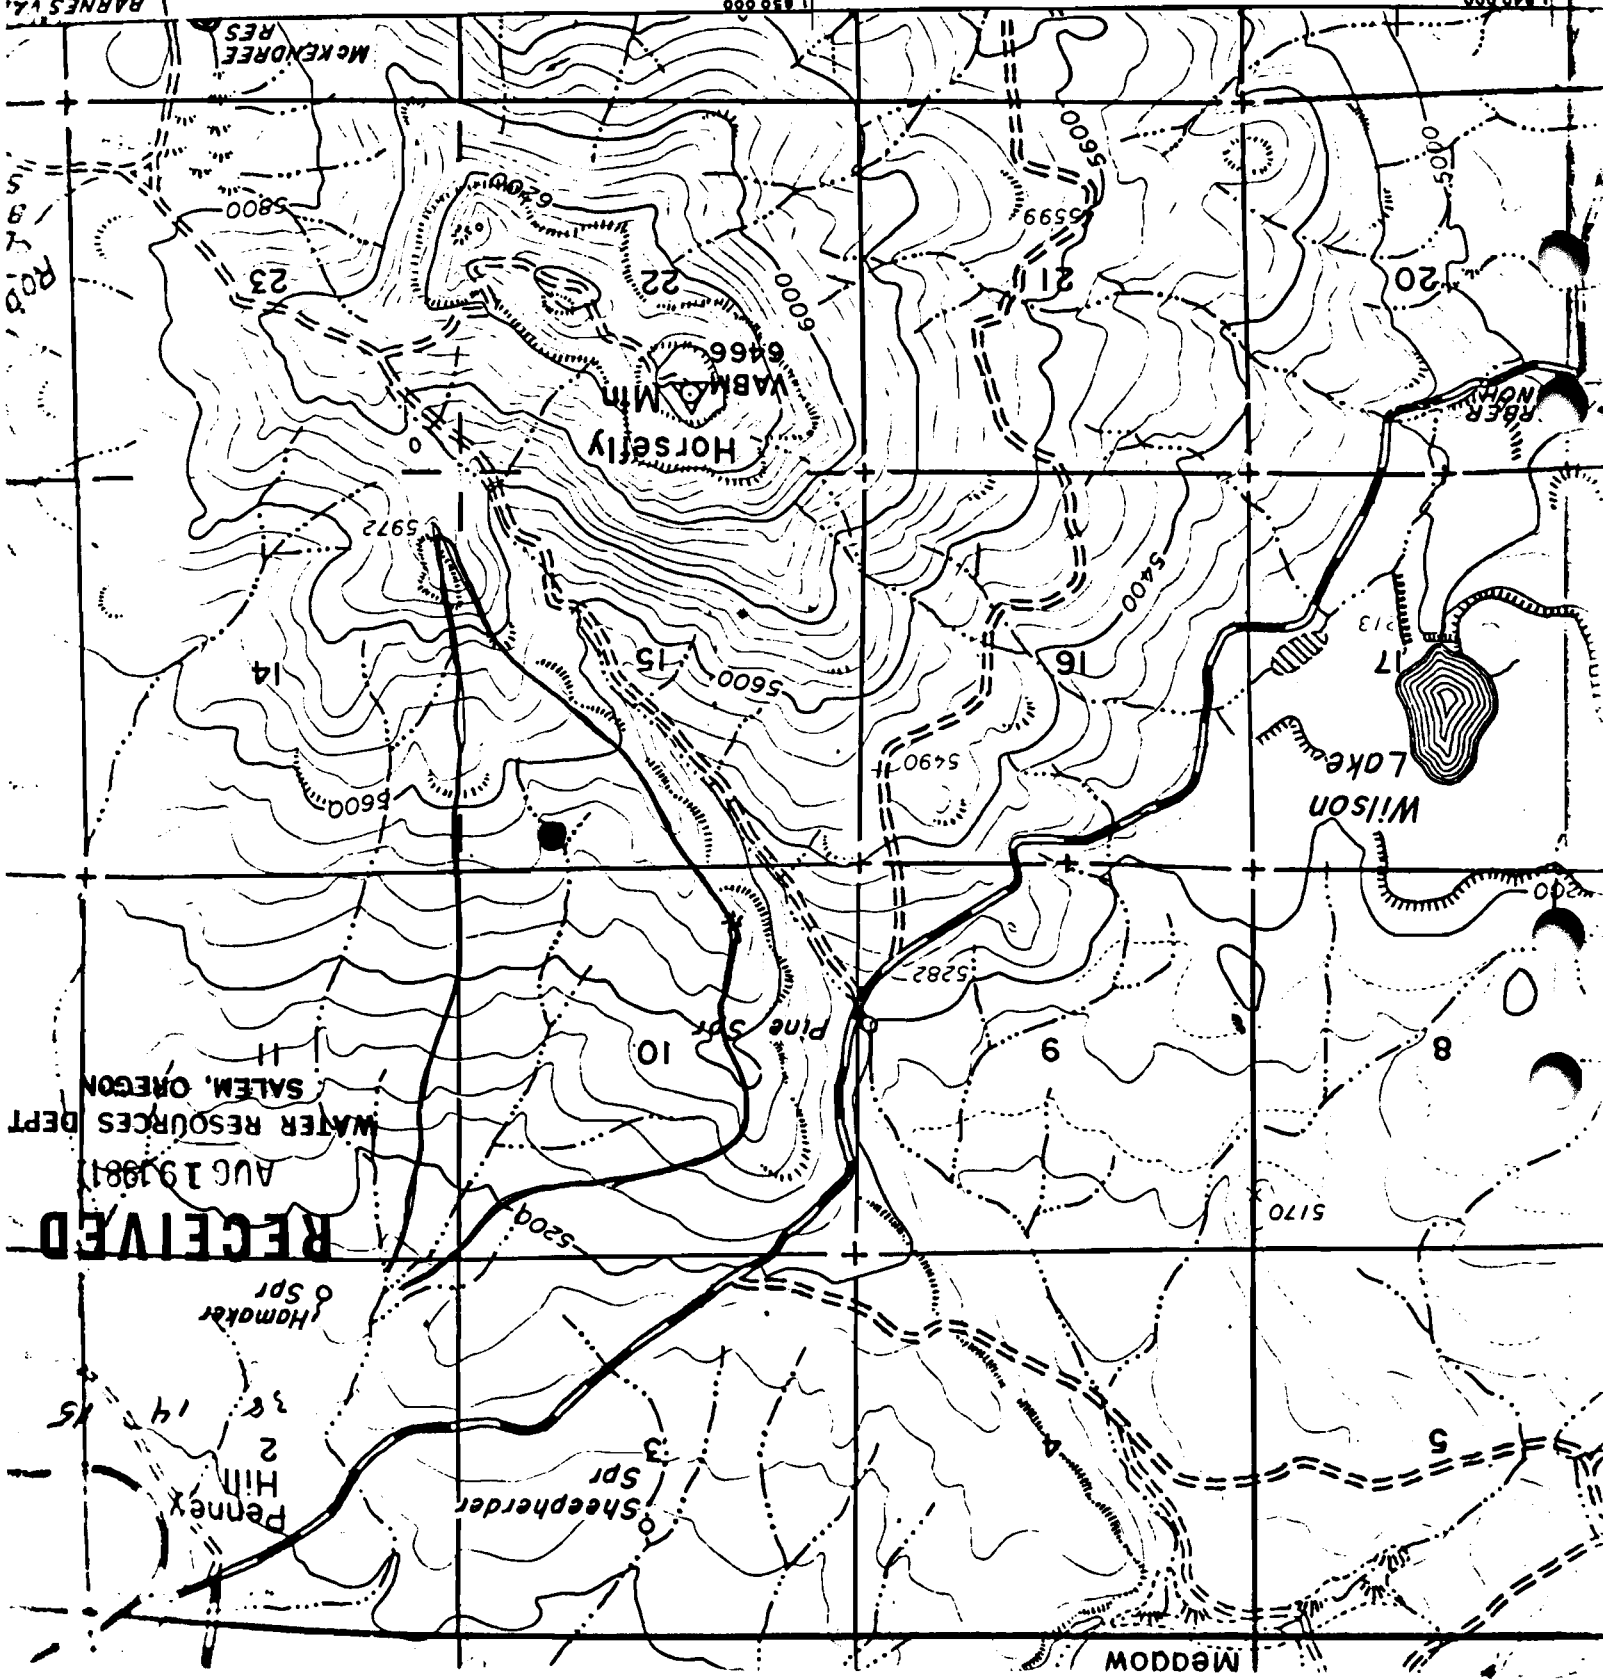

WATER RESOURCES DEPT.
SALEM, OREGON
AUG 19 1981

RECEIVED

Hamaker
Spr
Penney
Hill
2
3
14
15

MEDDOW