

Revised July 1941

UNITED STATES DEPARTMENT OF AGRICULTURE
FOREST SERVICE

RECEIVED. 59250

AUG 19 1981

FIELD MAP SHEET


WATER RESOURCES DEPT
SALEM, OREGON
PREMONT N.F.

T. 375
385 R. 14E Sec. _____ Subdiv. _____

Mapped by _____ Reviewed by _____ Scale 2 inches = 1 Mile


- RESERVOIR
- DRAINAGE
- ROAD

Application No. R-62474 7/21, 1981
Permit No. R 9919

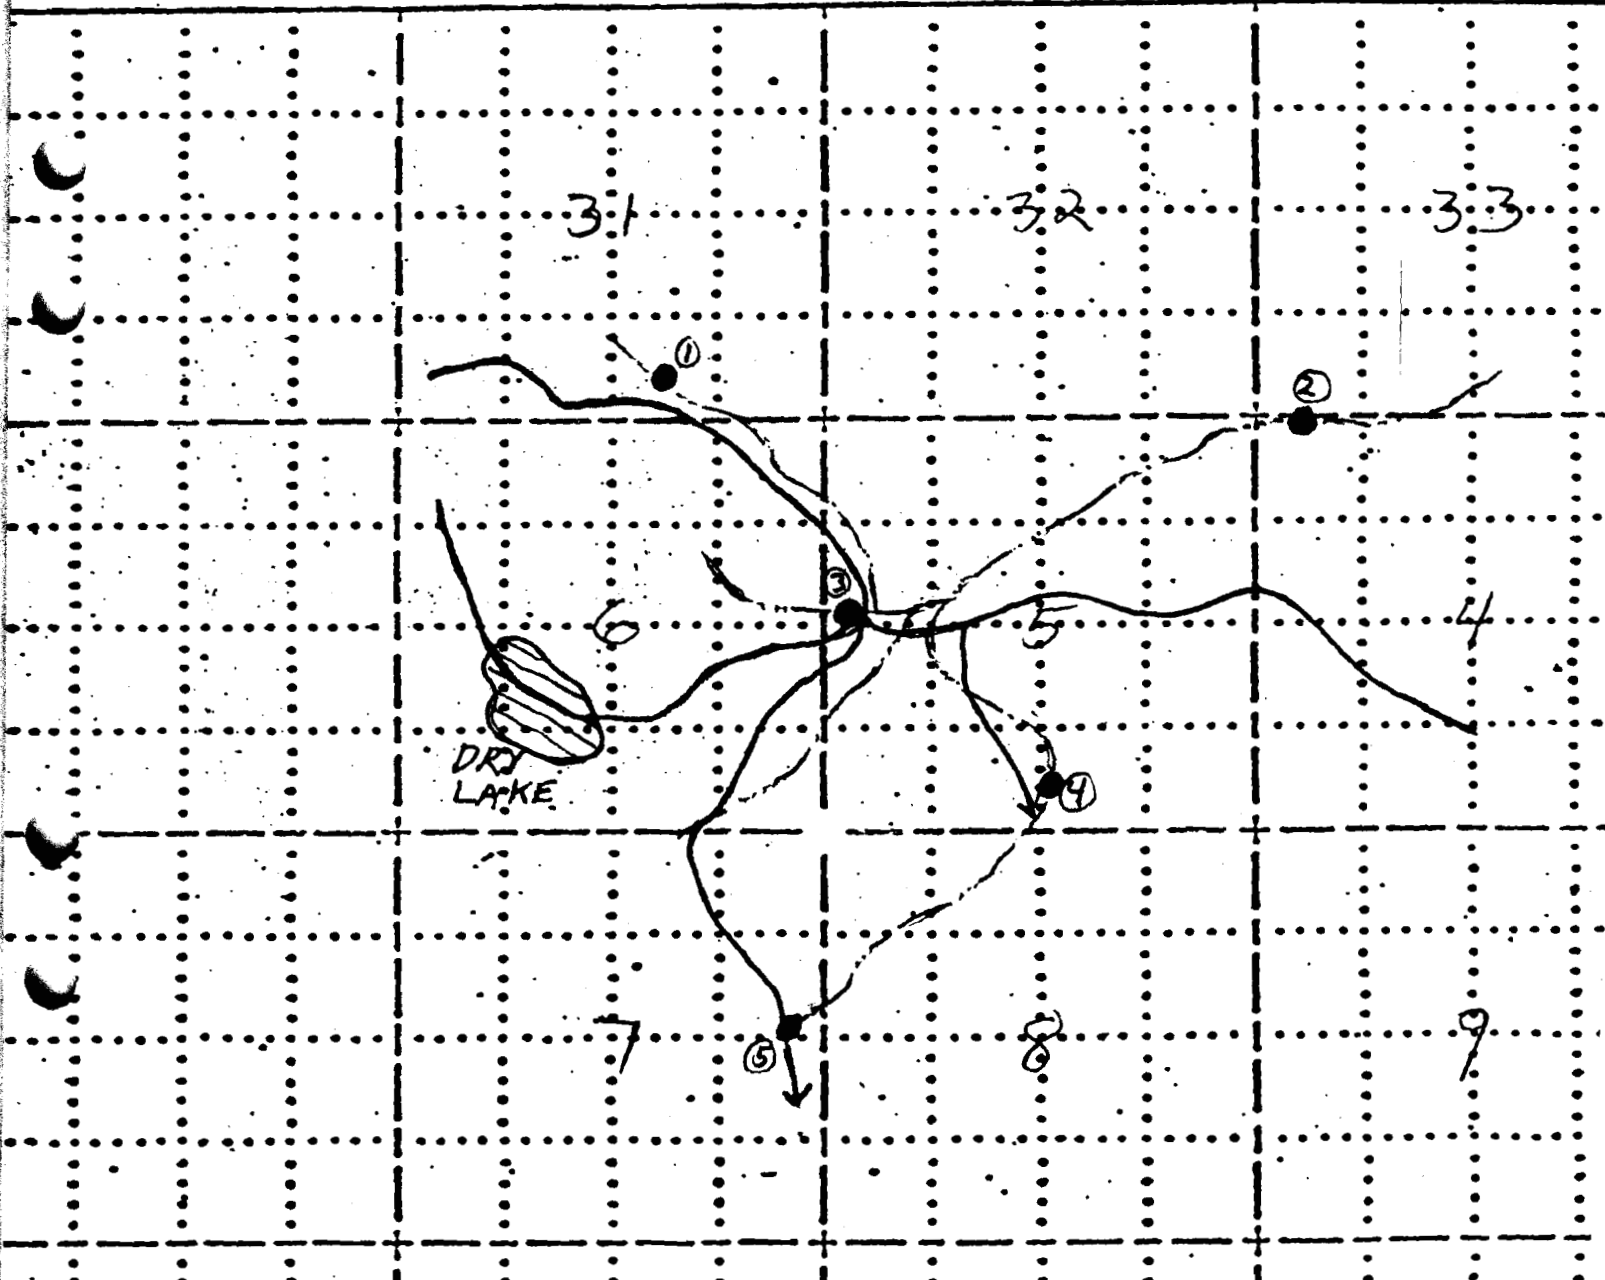

RECEIVED

AUG 17 1983
WATER RESOURCES DEPT.
SALEM, OREGON

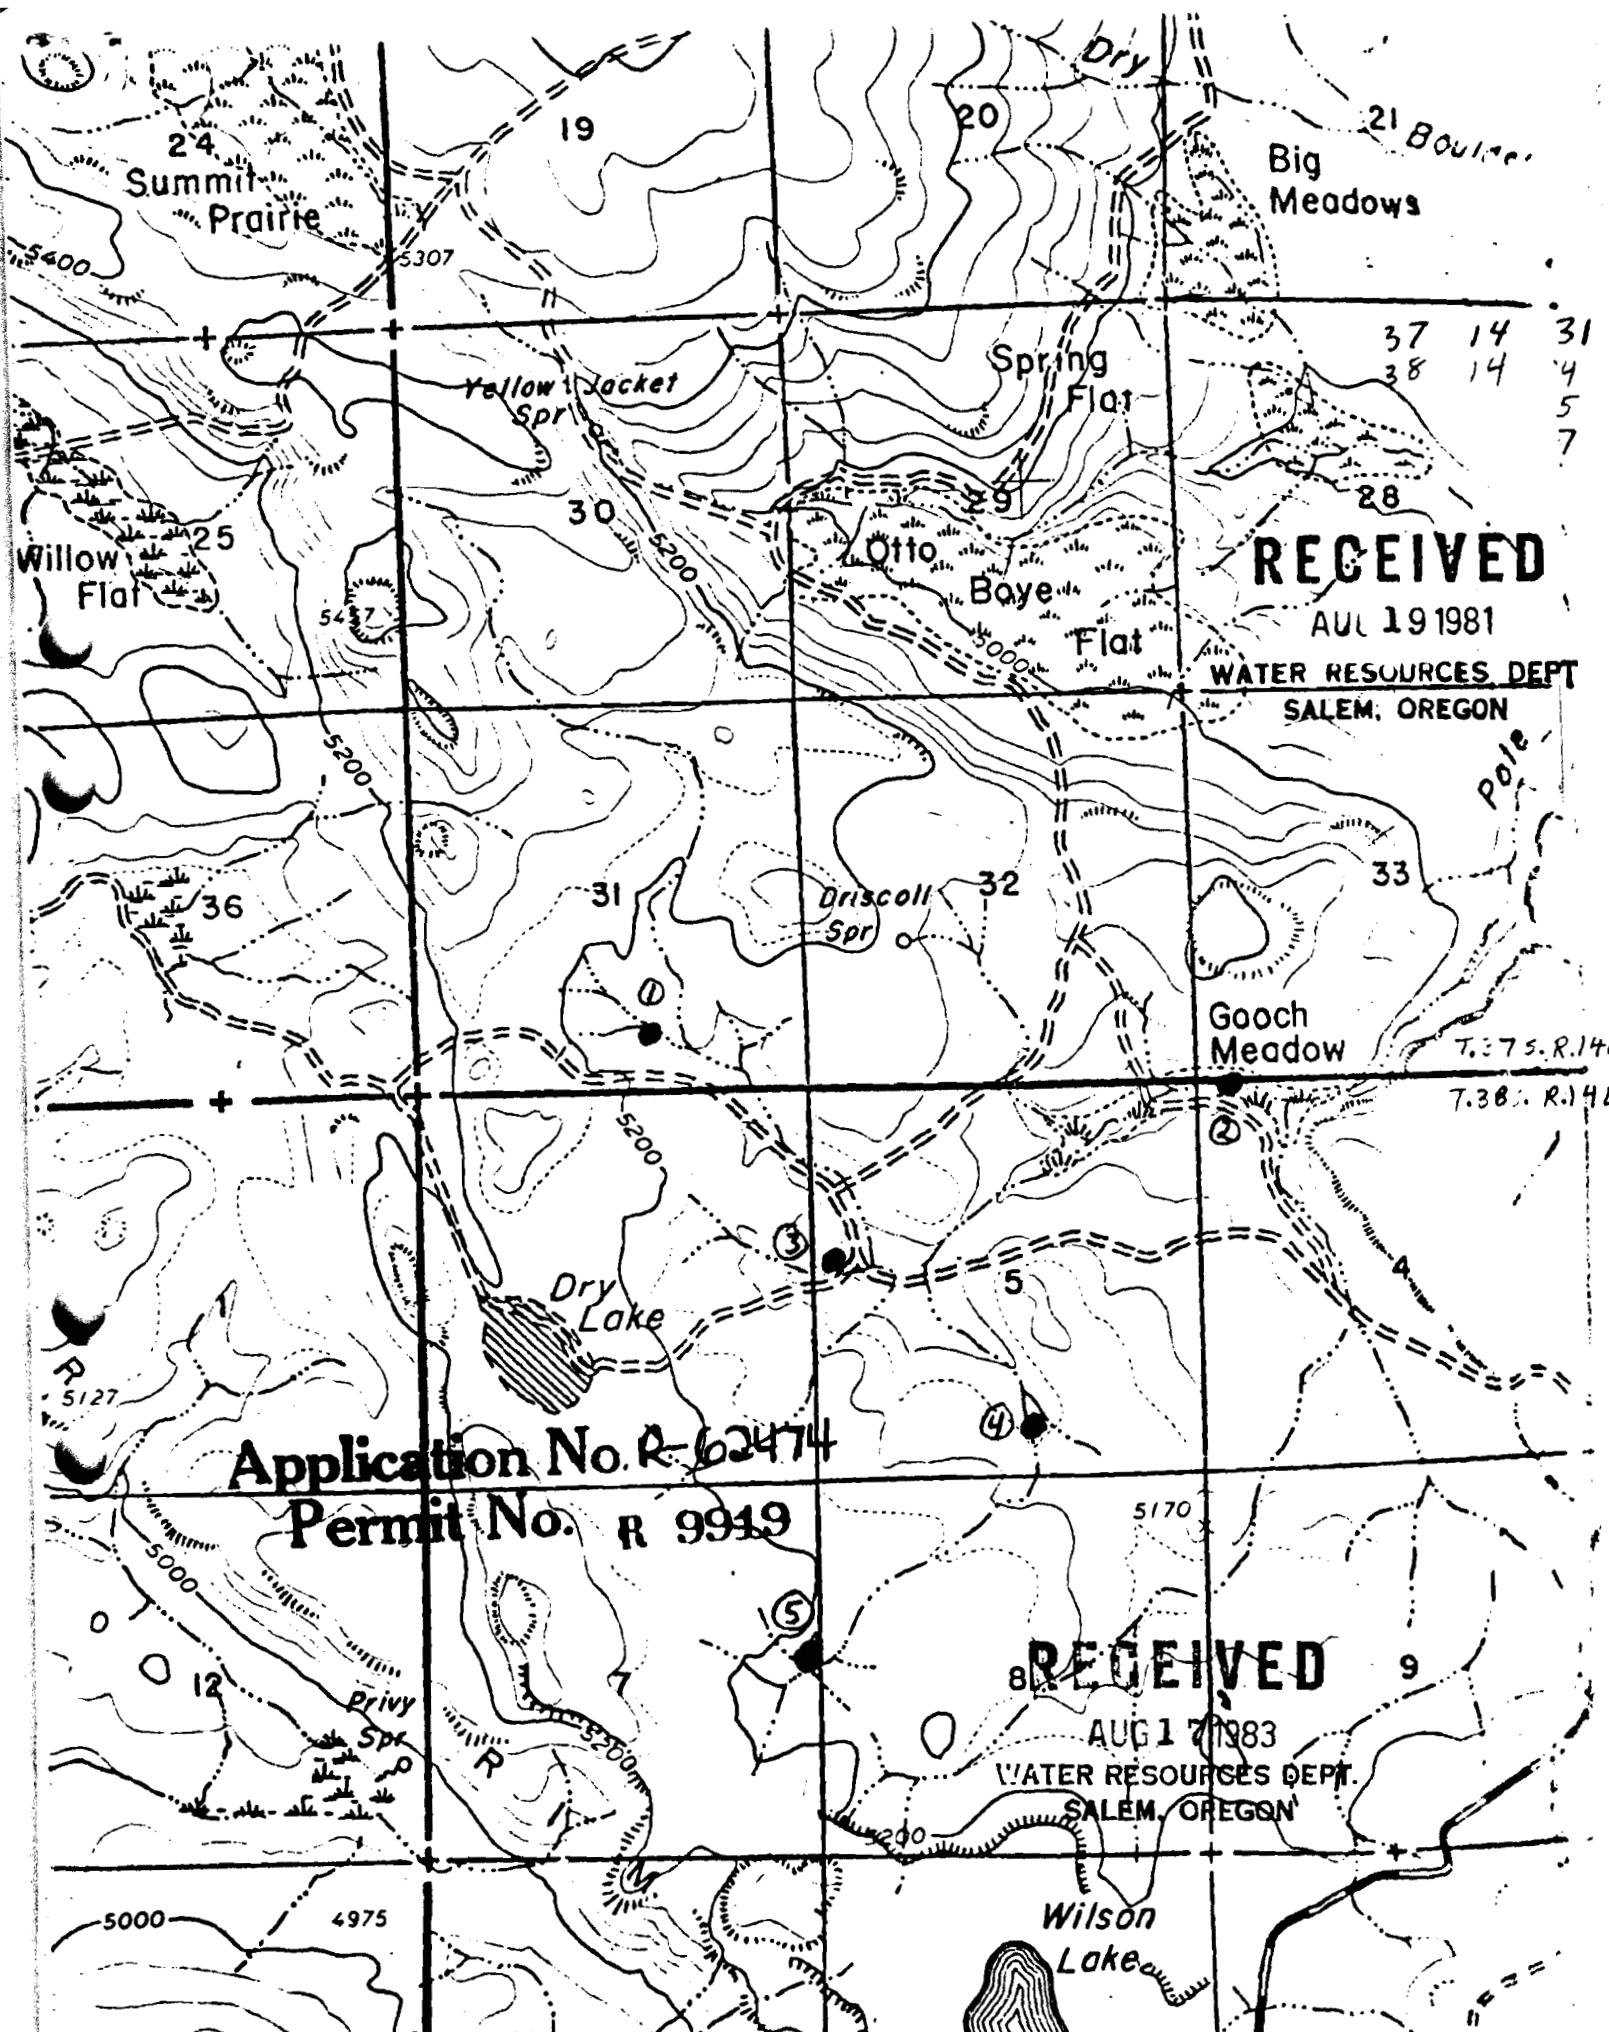

RECEIVED

AUG 19 1981

WATER RESOURCES DEPT
SALEM, OREGON

Application No. R-62474

Permit No. R 9919

RECEIVED

AUG 17 1983

WATER RESOURCES DEPT.
SALEM, OREGON