

FIELD MAP SHEET

WATER RESOURCES DEPT
SALEM, OREGON


T. 385/395 R. 12F Sec. _____ Subdiv. _____ FREMONT N.F.

Mapped by _____ Reviewed by _____ Scale 2 inches = 1 Mile

- RESERVOIR
- DRAINAGE
- ROAD

Application No. R-62496
Permit No: R 9920

7/21, 1981

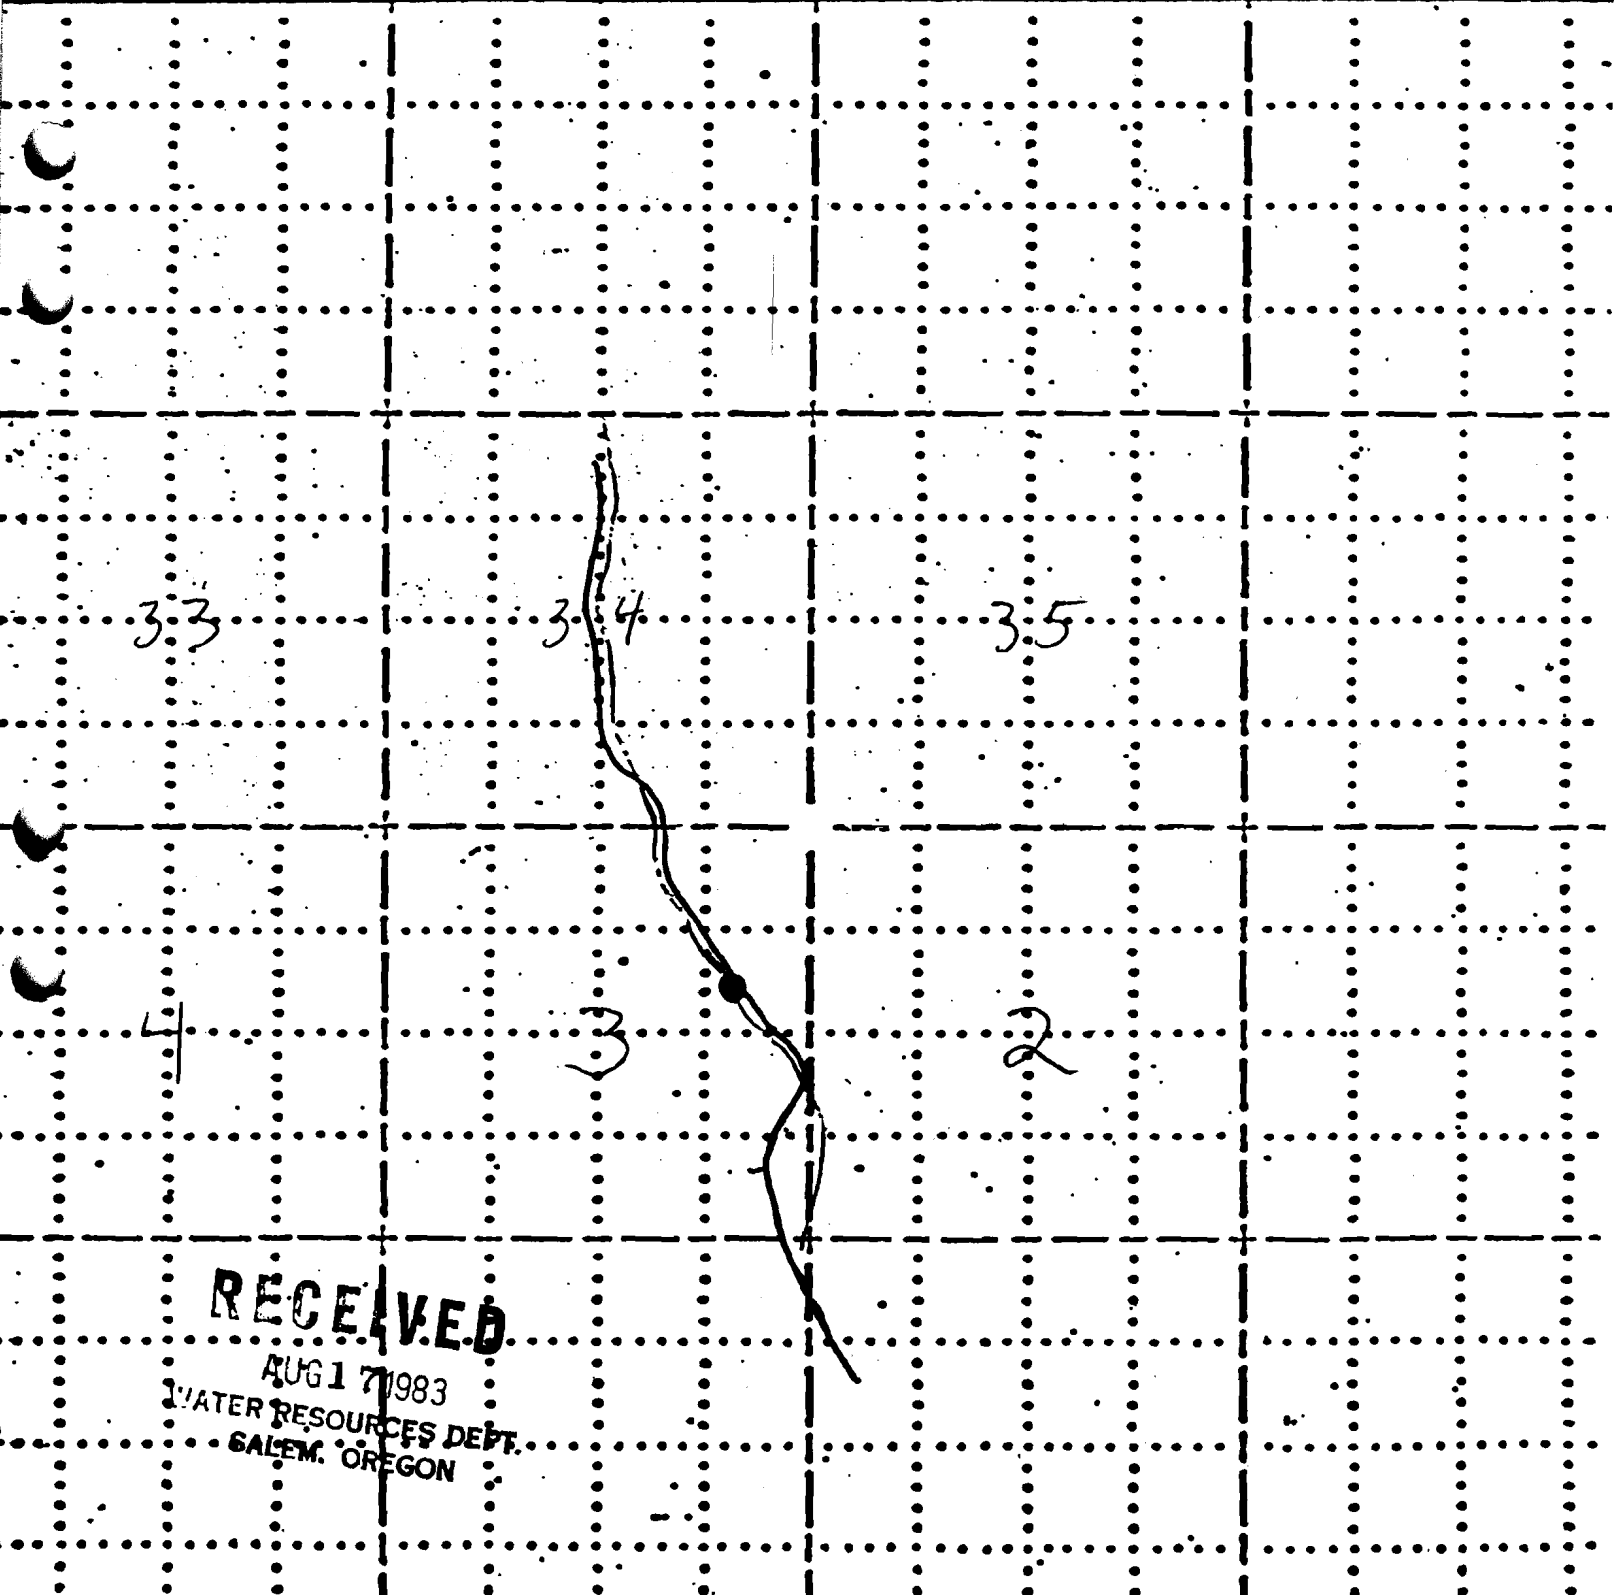

RECEIVED

AUG 17 1983
WATER RESOURCES DEPT.
SALEM, OREGON

38

RECEIVED

AUG 19 1981

WATER RESOURCES DEPT
SALEM, OREGON

Application No. R-62496
Permit No. R 9920

RECEIVED

AUG 17 1983

WATER RESOURCES DEPT.
SALEM, OREGON

MALIN QUADRANGLE
OREGON

R.12 E.

121°15'

42°1

T.3

