

DEC 11 1986

FOREST SERVICE

R-9922
59253

AUG 19 1981

WATER RESOURCES DEPT.
SALEM, OREGON

FIELD MAP SHEET


WATER RESOURCES DEPT.
SALEM, OREGON

T. 37S R. 20E Sec. _____ Subdiv. _____

FREMONT N.F.

Mapped by _____ Reviewed by _____ Scale 2 inches = 1 Mile

● RESERVOIR Application No. R-62498 8/5, 1981
— DRAINAGE Permit No. R 9922
— ROAD

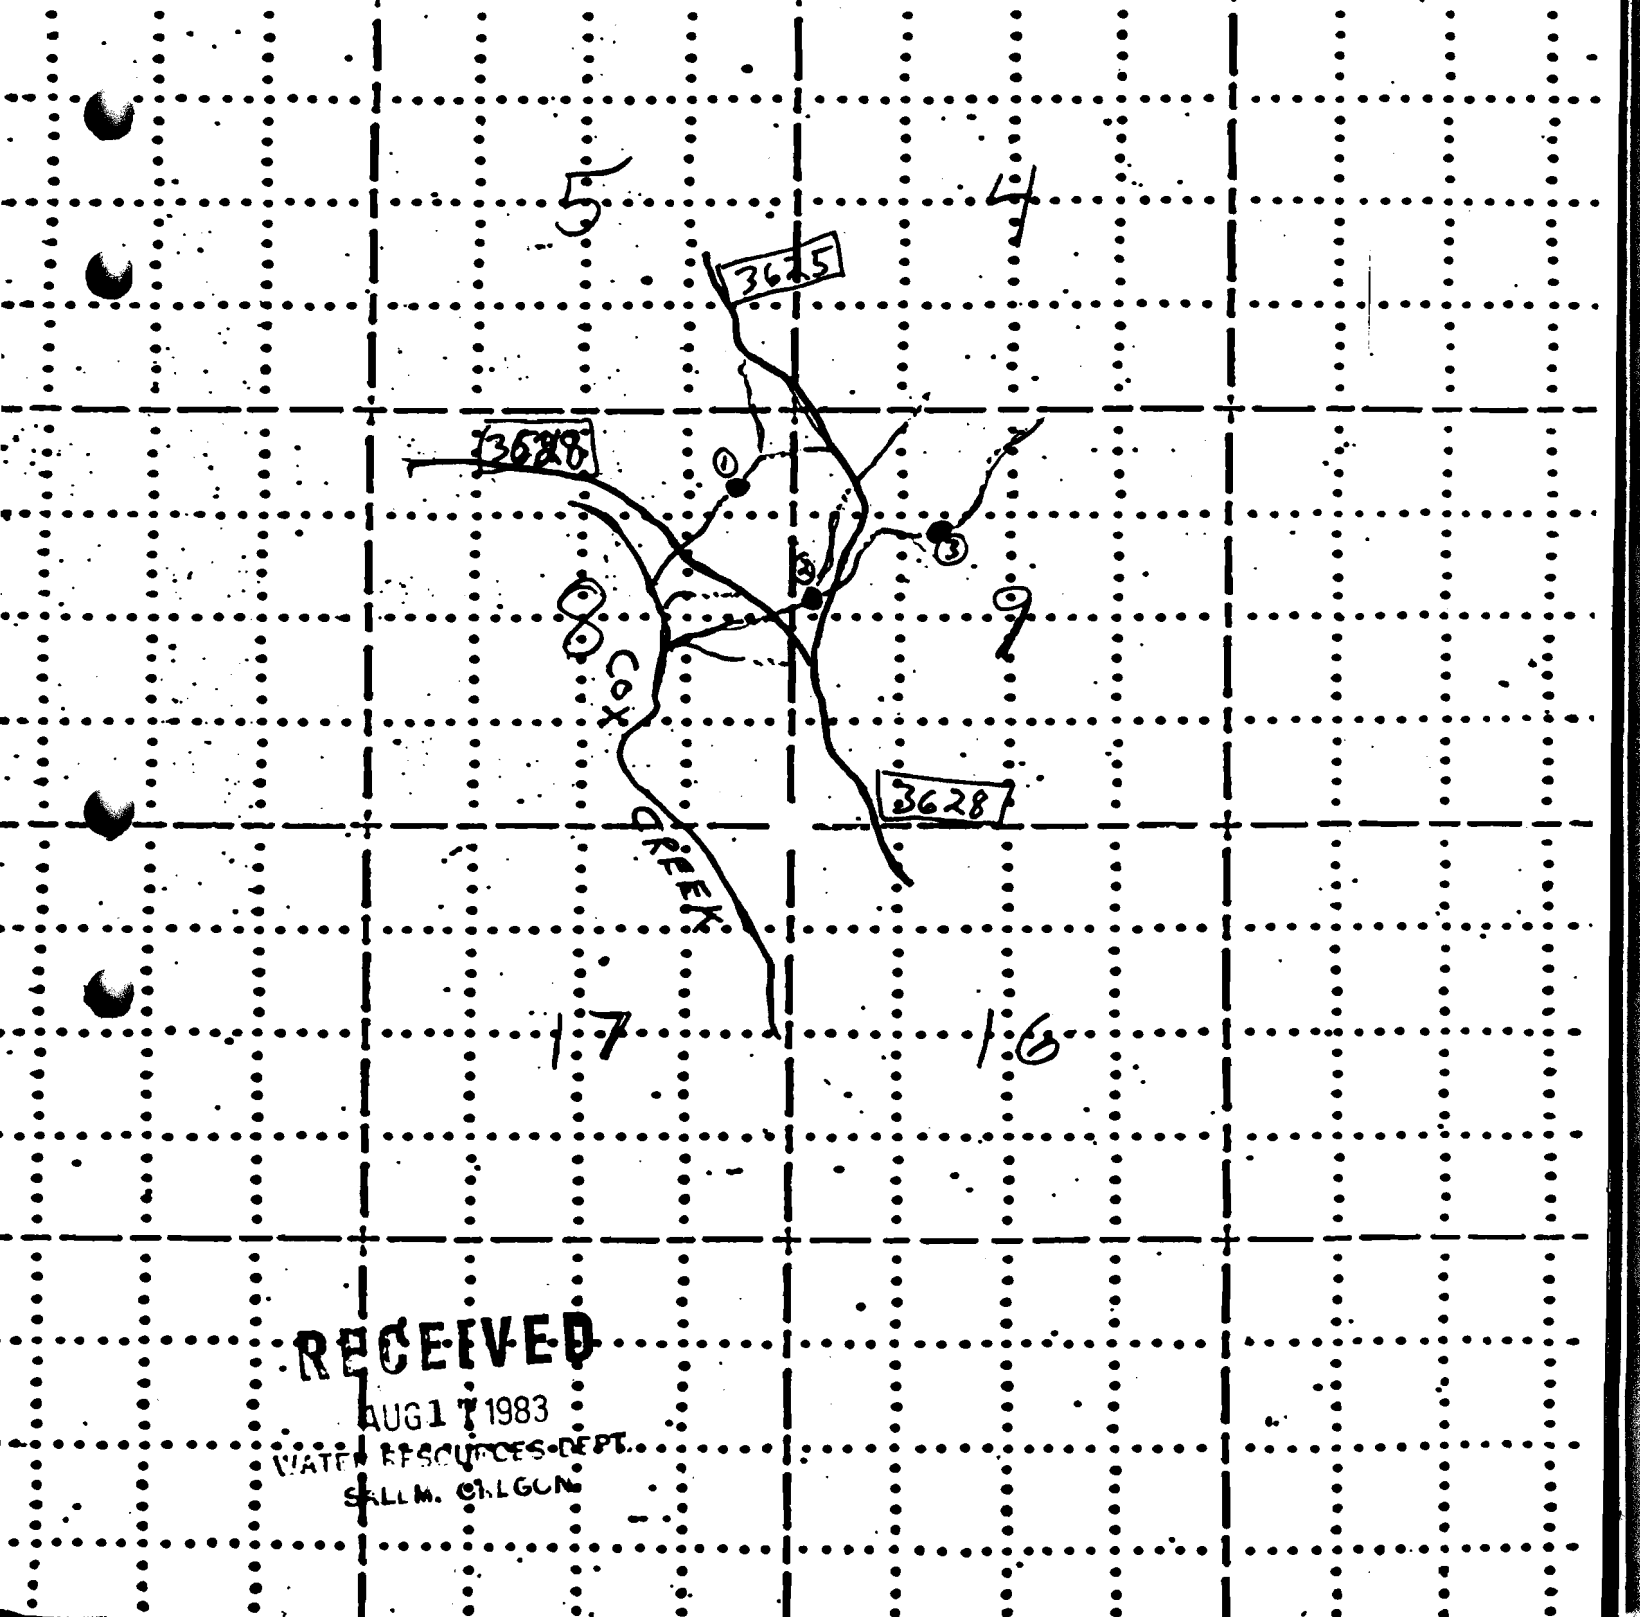

RECEIVED

AUG 17 1983
WATER RESOURCES DEPT.
SALEM, OREGON