

R-9925
RECEIVED 59256

AUG 19 1981


FIELD MAP SHEET WATER RESOURCES DEPT
SALEM, OREGON

T. 39S R. 21E Sec. _____ Subdiv. _____ N.F.

Mapped by _____ Reviewed by _____ Scale 2 inches = 1 Mile

● RESERVOIR
— DRAINAGE
— ROAD

Application No. R-62508
Permit No. R 9925

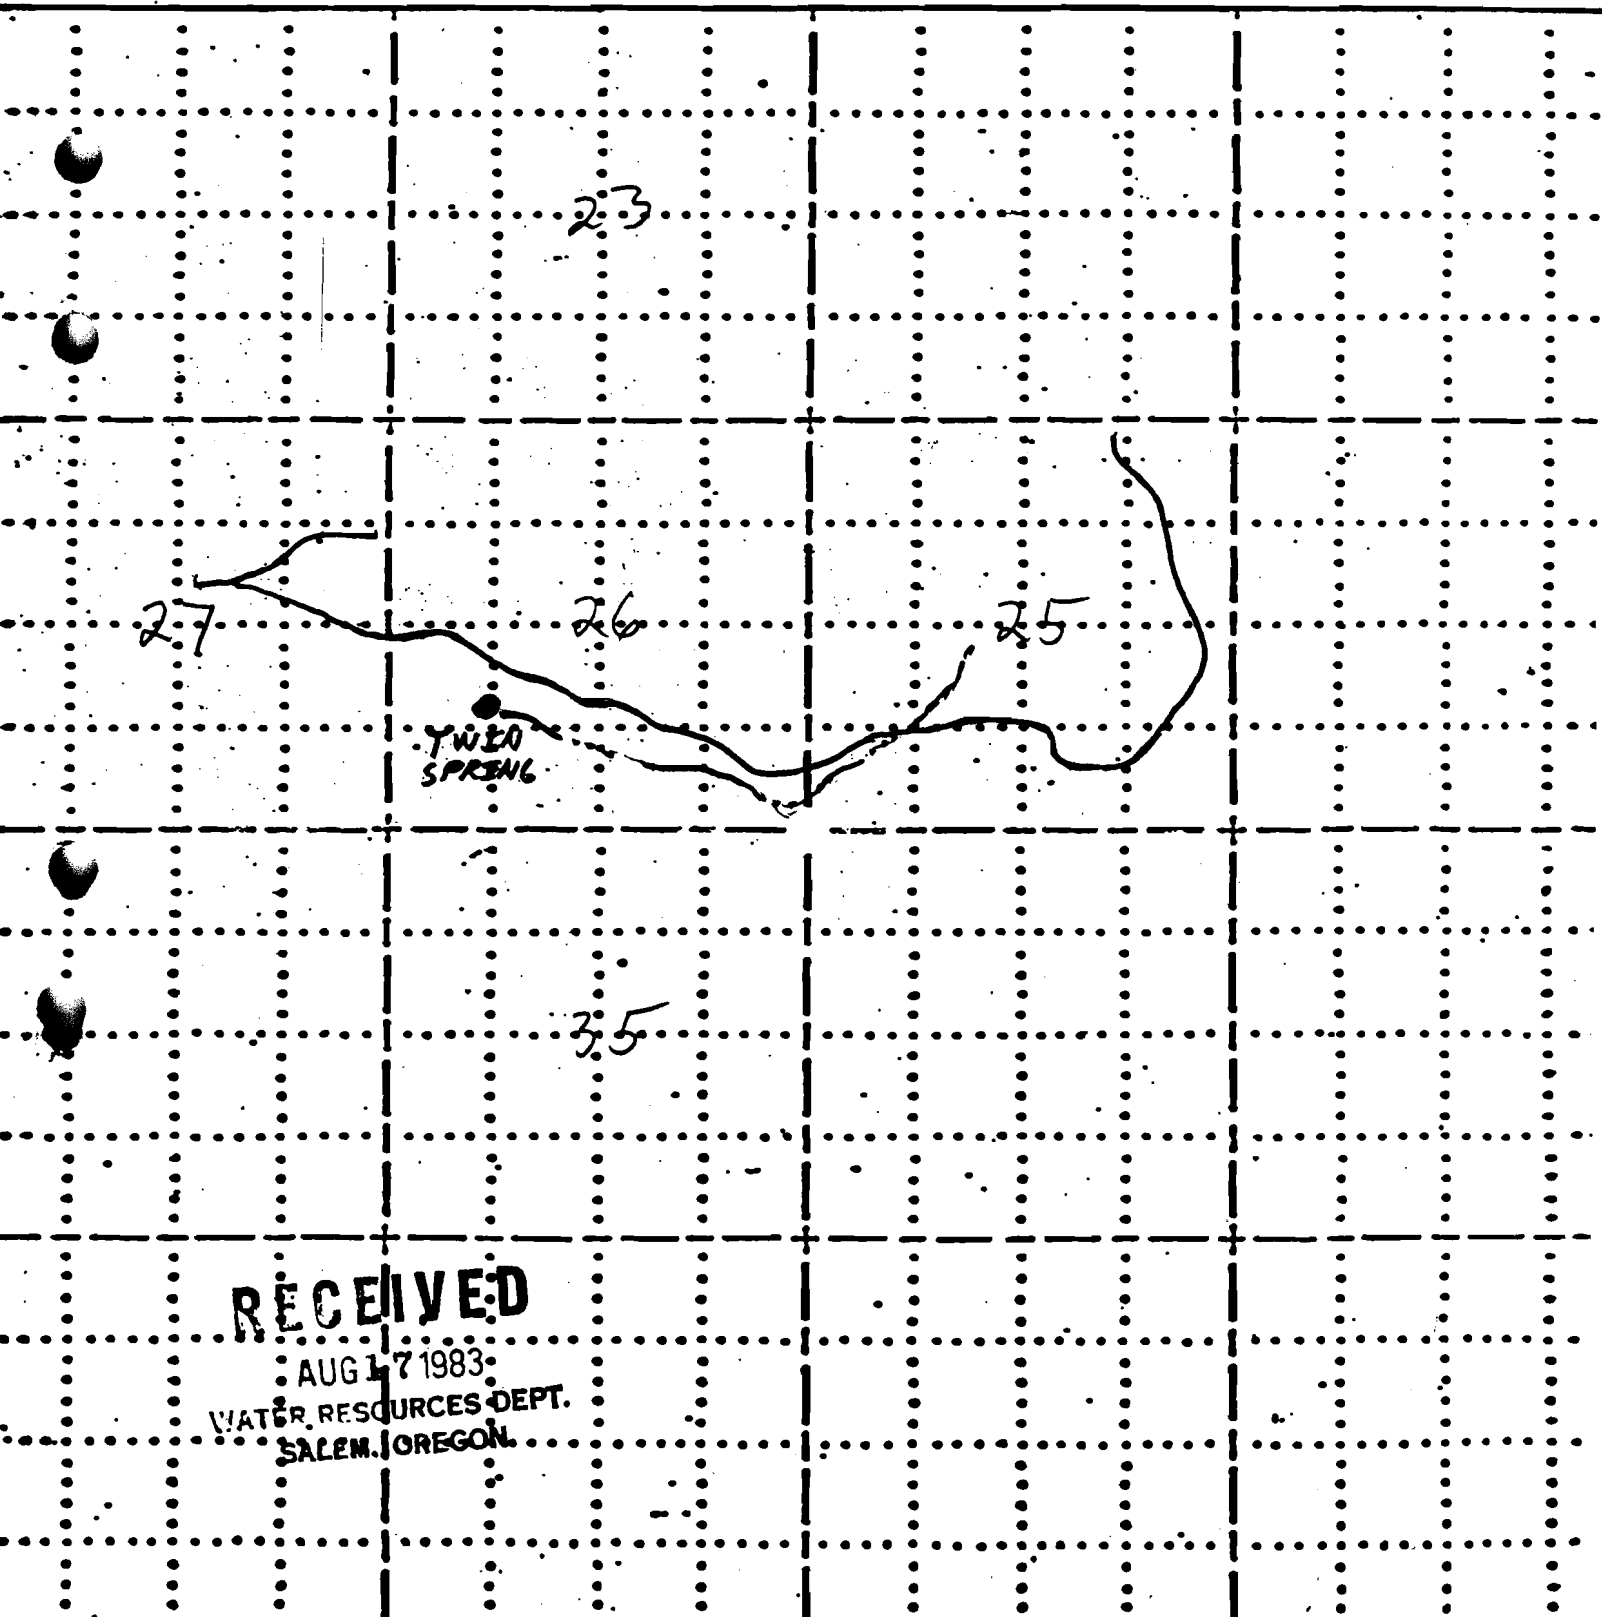


RECEIVED

AUG 17 1983
WATER RESOURCES DEPT.
SALEM, OREGON

RECEIVED
AUG 19 1981
WATER RESOURCES DEPT
SALEM, OREGON

39 21 26

Application No. R-62508
Permit No. R 9925

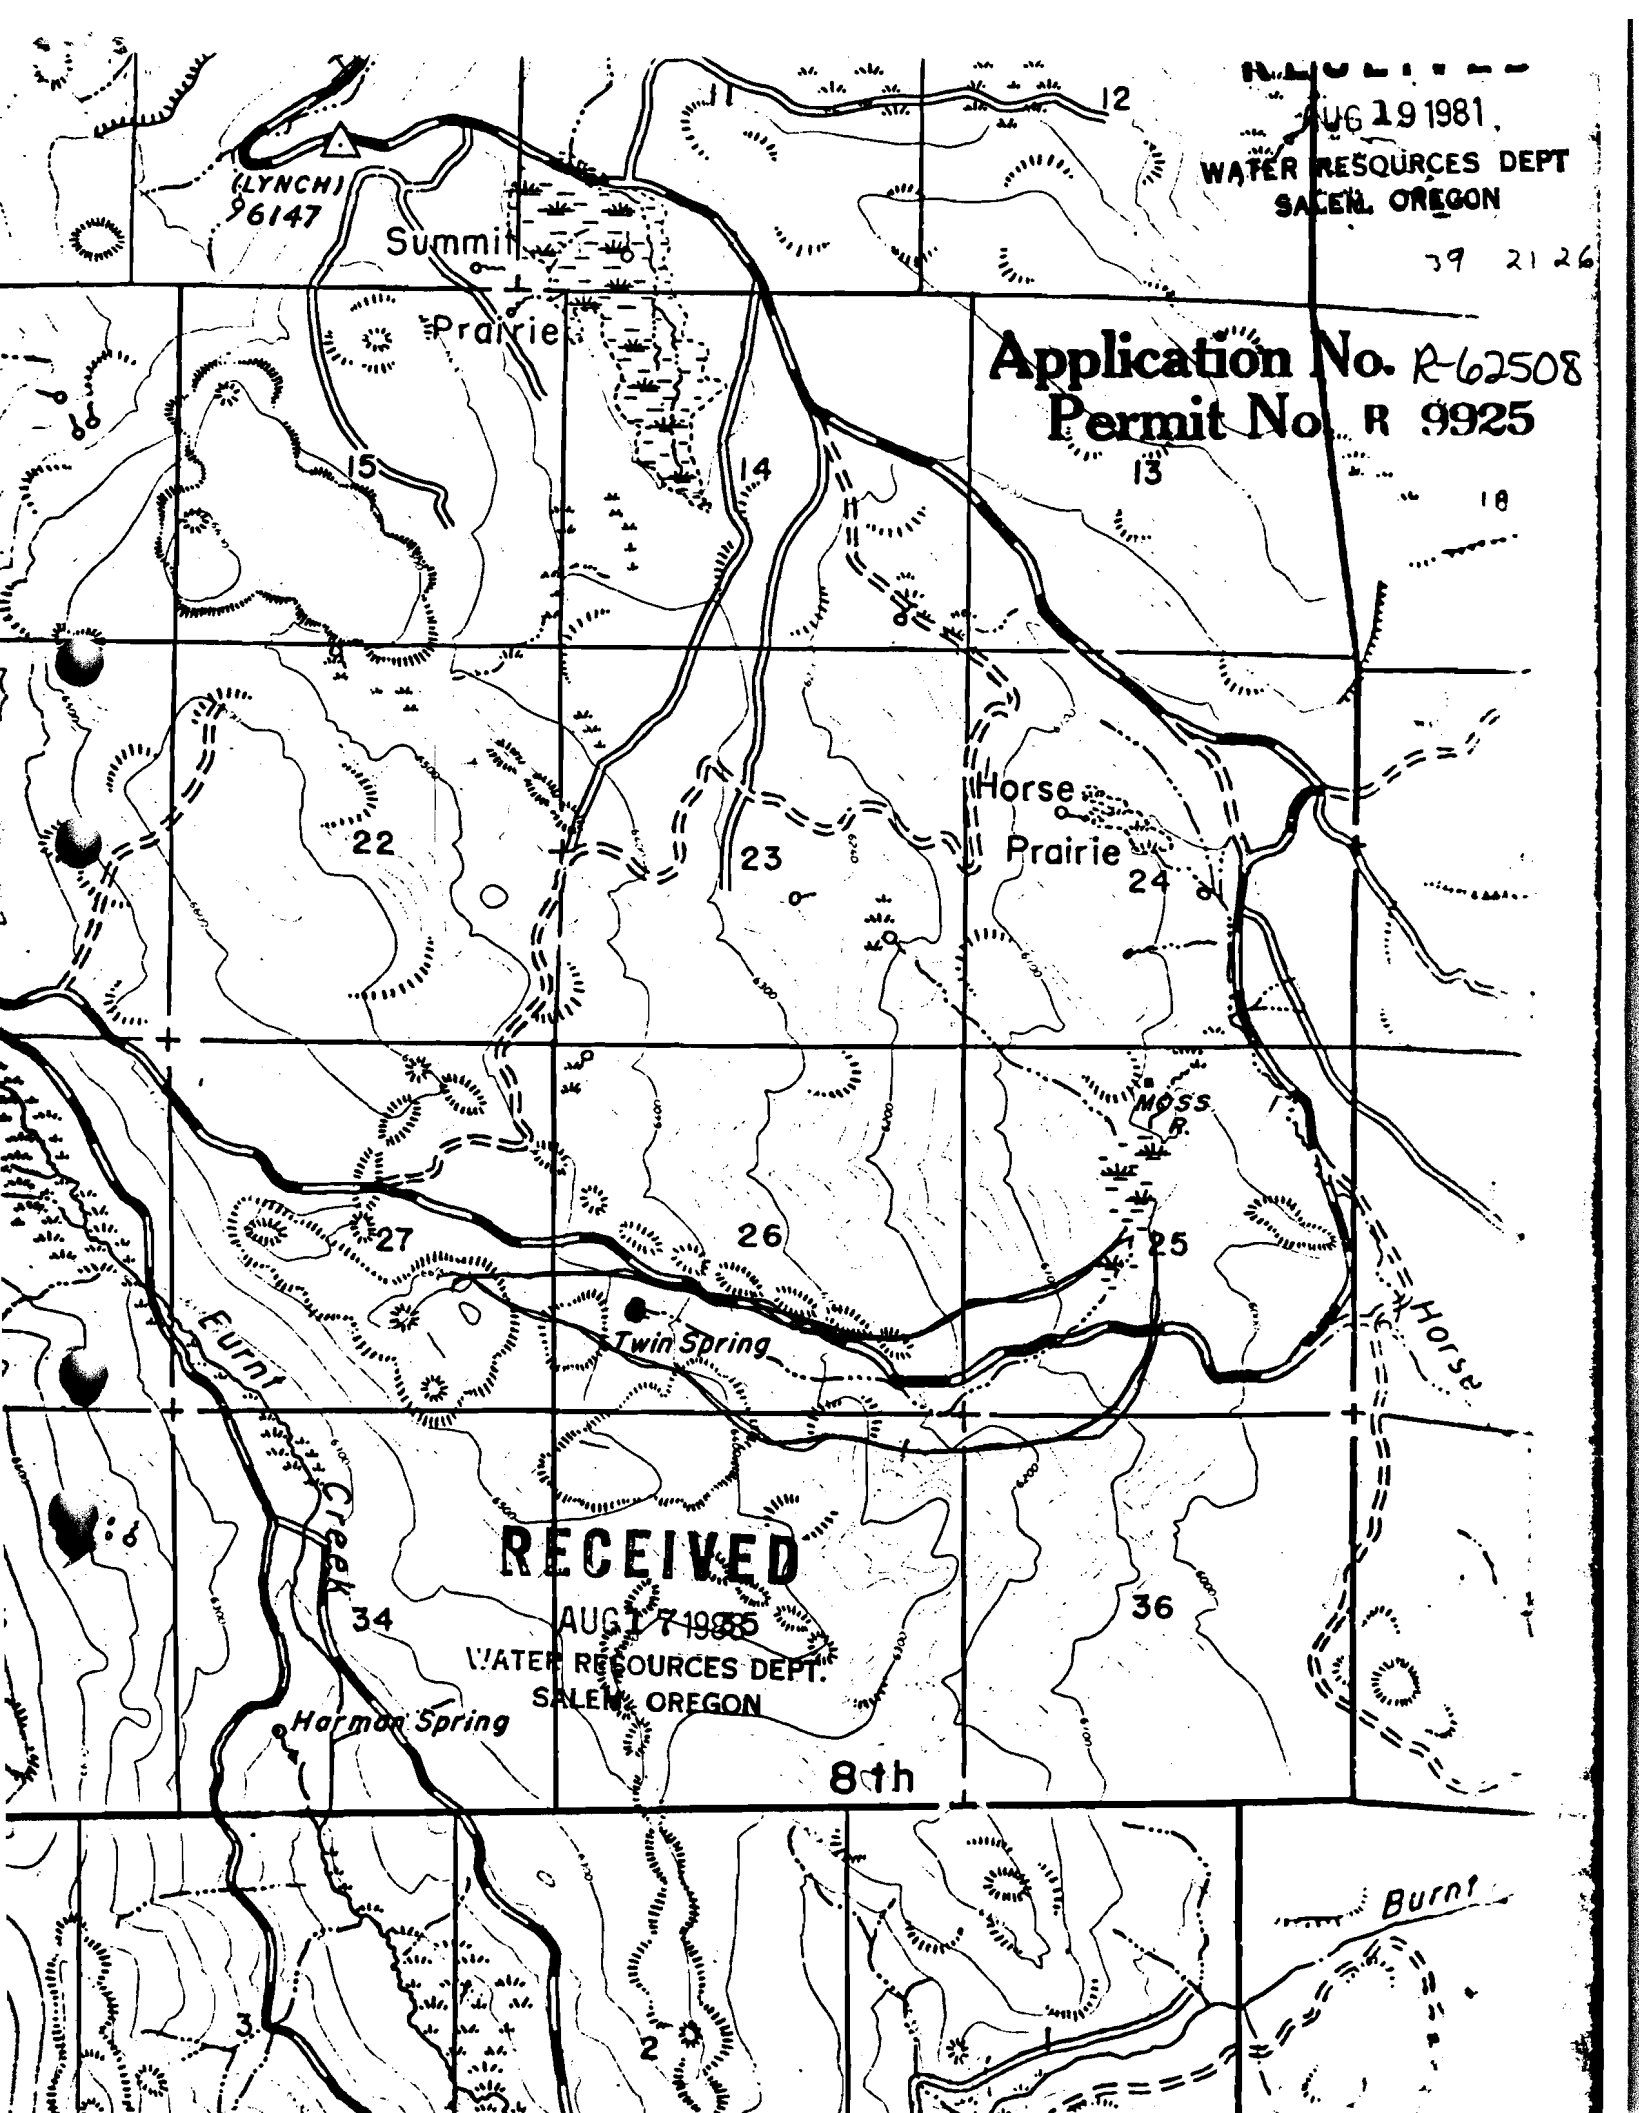

RECEIVED

AUG 17 1985
WATER RESOURCES DEPT.
SALEM, OREGON

8th

Burnt