

R-9926
RECEIVED 59257

AUG 19 1981

FIELD MAP SHEET

WATER RESOURCES DEPT
SALEM, OREGON

T. 40S R. 18E Sec. Subdiv. N.F.

Mapped by Reviewed by Scale 2 inches = 1 Mile

- RESERVOIR
- DRAINAGE
- ROAD

Application No. R-62516, 19

Permit No. R 9926

22

23

24

27

VENATOR

CREEK

26


CREEK

25

RECEIVED


AUG 17 1983

WATER RESOURCES DEPT.
SALEM, OREGON

34

35

36

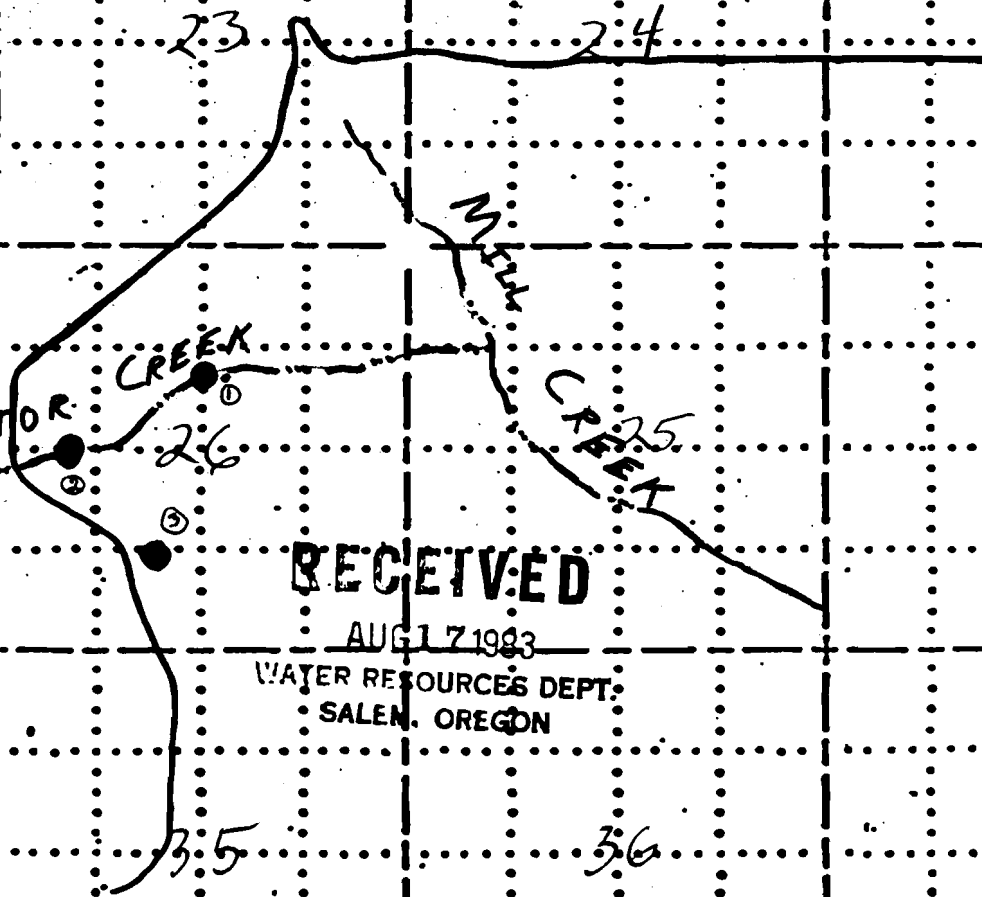

Application No R-60516
Permit No. R 9926

RECEIVED

AUG 19 1981

WATER RESOURCES DEPT
SALEM, OREGON

40 18 26

BEHM
RANCH

LAKEVIEW WATER

USERS HDQ

ASHCRAFT
FLUME

FRIDAY
RANCH

BE CRAFT
RANCH

BOB'S
WELL

RECEIVED

AUG 17 1983

WATER RESOURCES DEPT
SALEM, OREGON

