

RECEIVED

AUG 19 1981

FIELD MAP SHEET


WATER RESOURCES DEPT
SALEM, OREGON

T. 37S R. 18E Sec. _____ Subdiv. _____ N.F. _____

Mapped by _____ Reviewed by _____ Scale 2 inches = 1 Mile

● RESERVOIR
— DRAINAGE
— ROAD

Application No. R-62539, 19
Permit No. R 9927

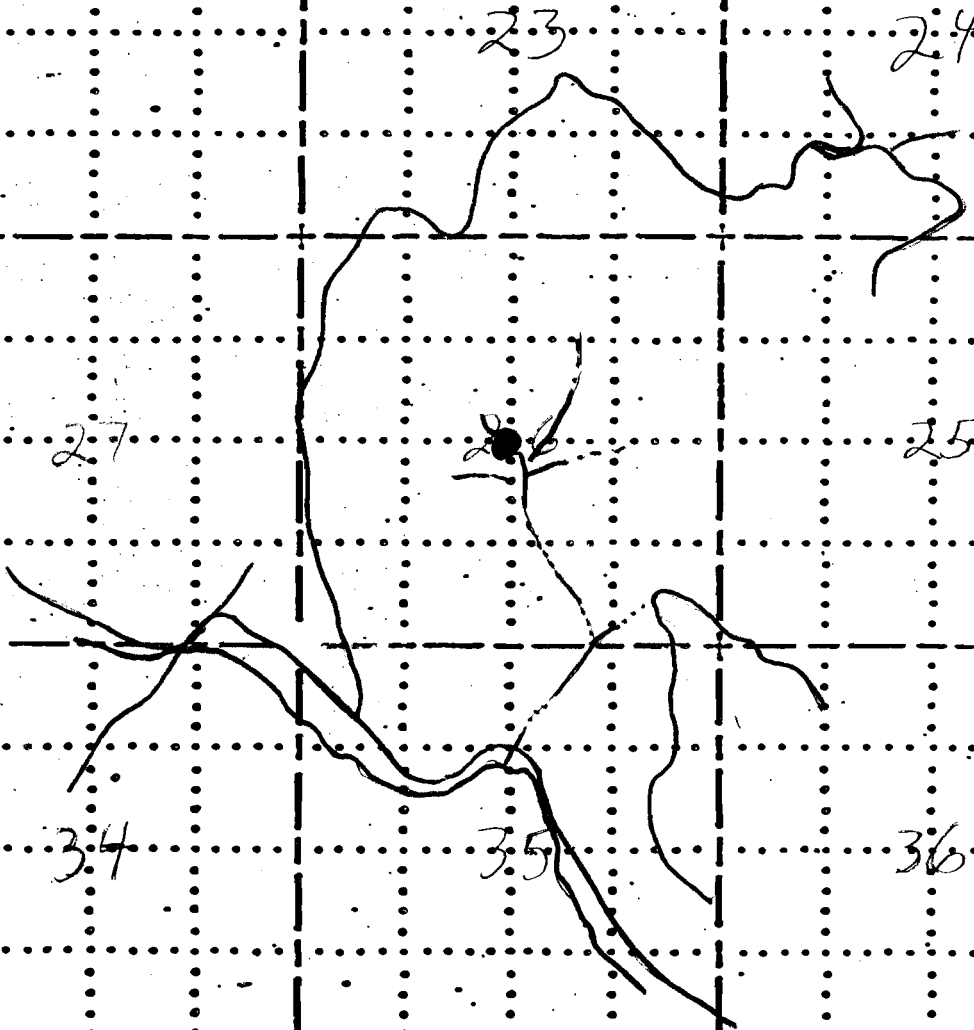

RECEIVED

AUG 17 1983
WATER RESOURCES DEPT.
SALEM, OREGON

