

R-9928  
RECEIVED  
AUG 19 1981  
WATER RESOURCES DEPT  
SALEM, OREGON

# FIELD MAP SHEET


T. <sup>37S</sup>~~38S~~ R. <sup>18E</sup> Sec. \_\_\_\_\_ Subdiv. \_\_\_\_\_ N.F.

Mapped by \_\_\_\_\_ Reviewed by \_\_\_\_\_ Scale <sup>2</sup> inches = 1 Mile

● RESERVOIR  
— DRAINAGE  
— ROAD

Application No. R-62544  
Permit No. R 9928

19

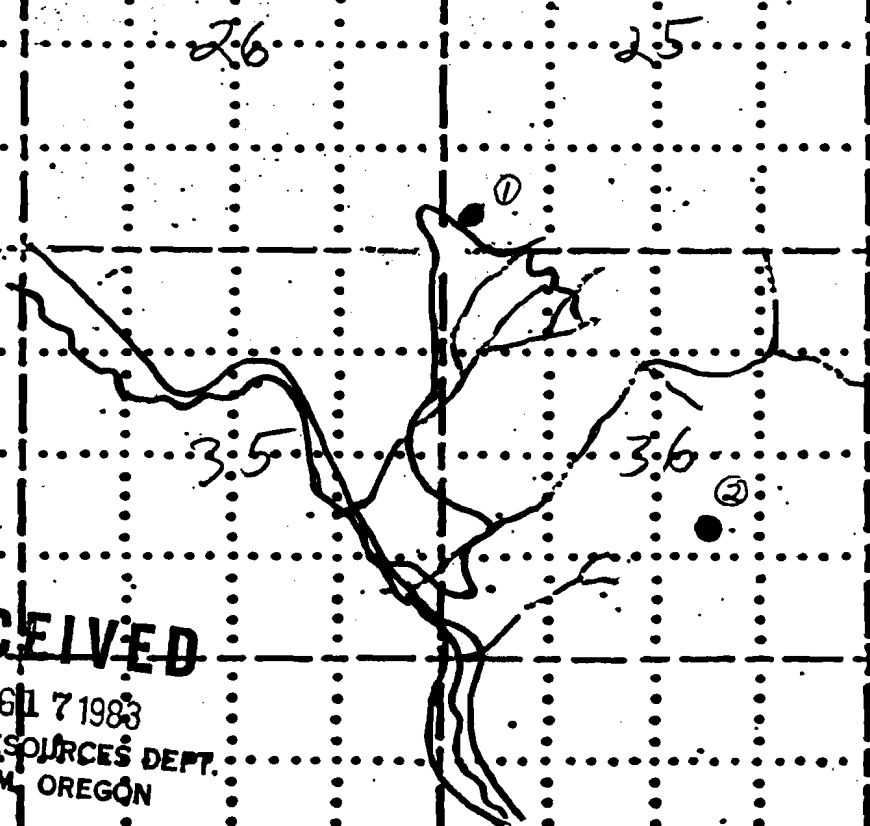


R-9928  
**RECEIVED**

AUG 19 1981

WATER RESOURCES DEPT  
SALEM, OREGON

**Application No. R-62544**  
**Permit No. R 9928**

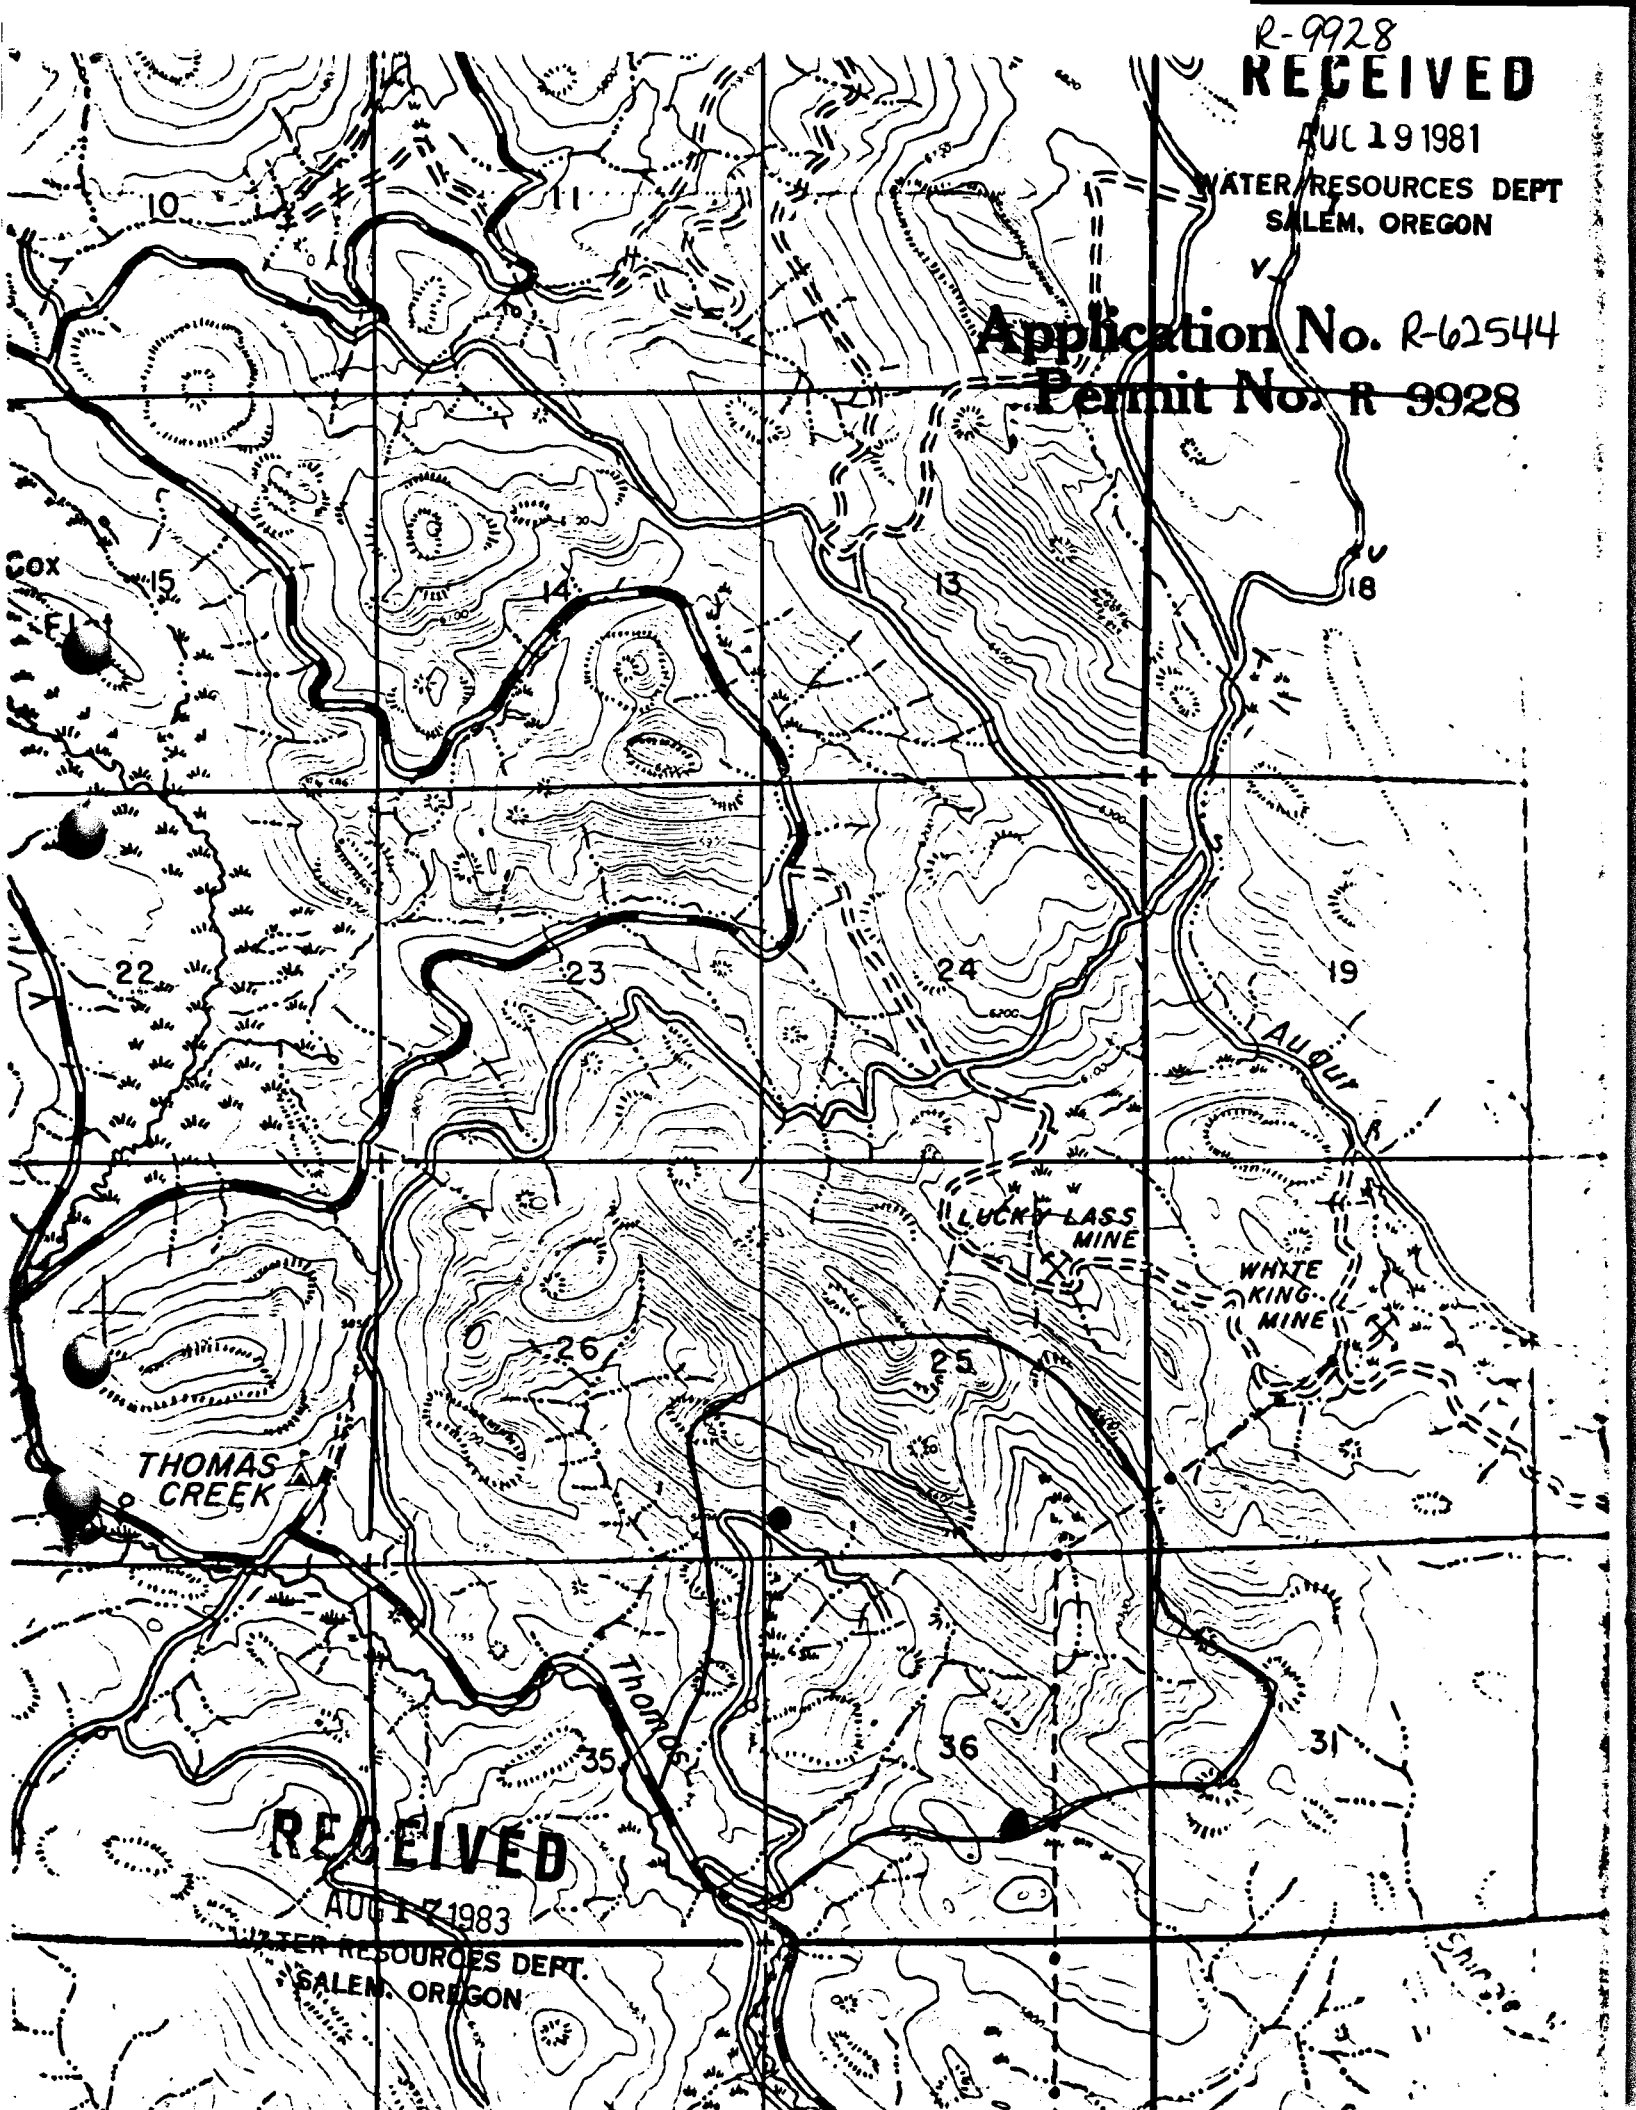

**RECEIVED**

AUG 17 1983

WATER RESOURCES DEPT.  
SALEM, OREGON