

FIELD MAP SHEET

Application No. R-62802

Permit No. R10055

T. 35S R. 18E Sec. Subdiv. FREMONT N.F.

Mapped by T. OLENICHAK Reviewed by Scale 2 inches = 1 Mile

RESERVOIR

DRAINAGE


ROAD

8/17, 1981

RECEIVED

SEP 17 1981

WATER RESOURCES DEPT
SALEM, OREGON

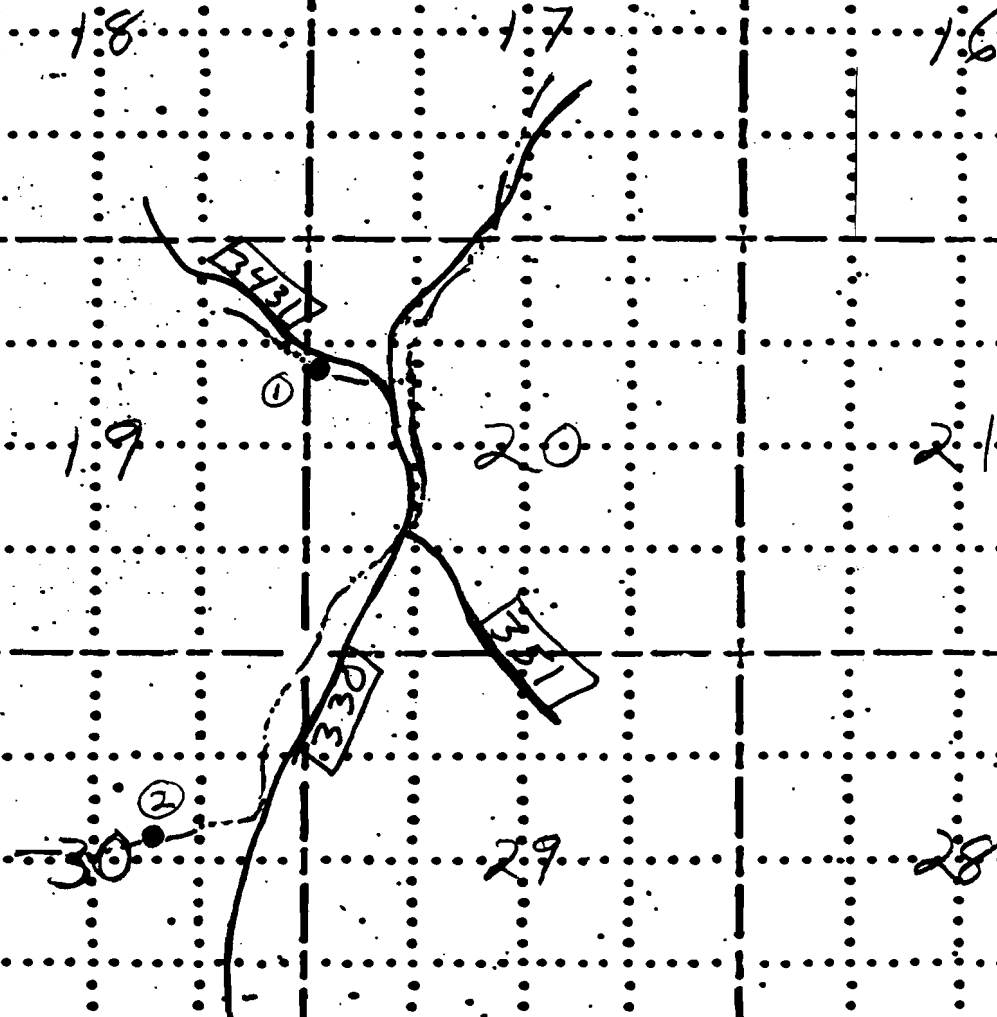

RECEIVED

AUG 17 1983

WATER RESOURCES DEPT
SALEM, OREGON