

Application No. **R-62803**
FIELD MAP SHEET Permit No. **R10056**

T. 36S R. 19E Sec. _____ Subdiv. _____ FREMONT N.F.

Mapped by T. OLENTCHAK Reviewed by _____ Scale 2 inches = 1 Mile

● RESERVOIR


— DRAINAGE

— ROAD

RECEIVED

SEP 17 1981

WATER RESOURCES DEPT
SALEM, OREGON

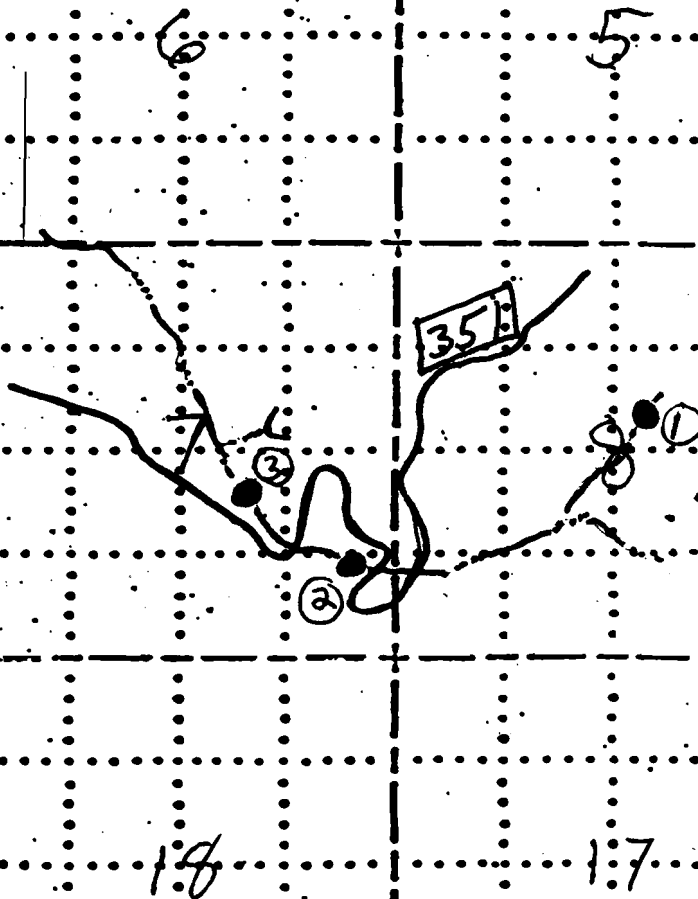

RECEIVED

AUG 17 1983

WATER RESOURCES DEPT.
SALEM, OREGON