


UNITED STATES  
DEPARTMENT OF THE INTERIOR  
BUREAU OF LAND MANAGEMENT

SECTION 25  
NE 1/4 SE 1/4

# Oregon State Water Filings

TOWNSHIP 32S, RANGE 36E, W. M.

4" = 1 MILE      ↑ North      HORSE FLAT RES. #1      10-4651

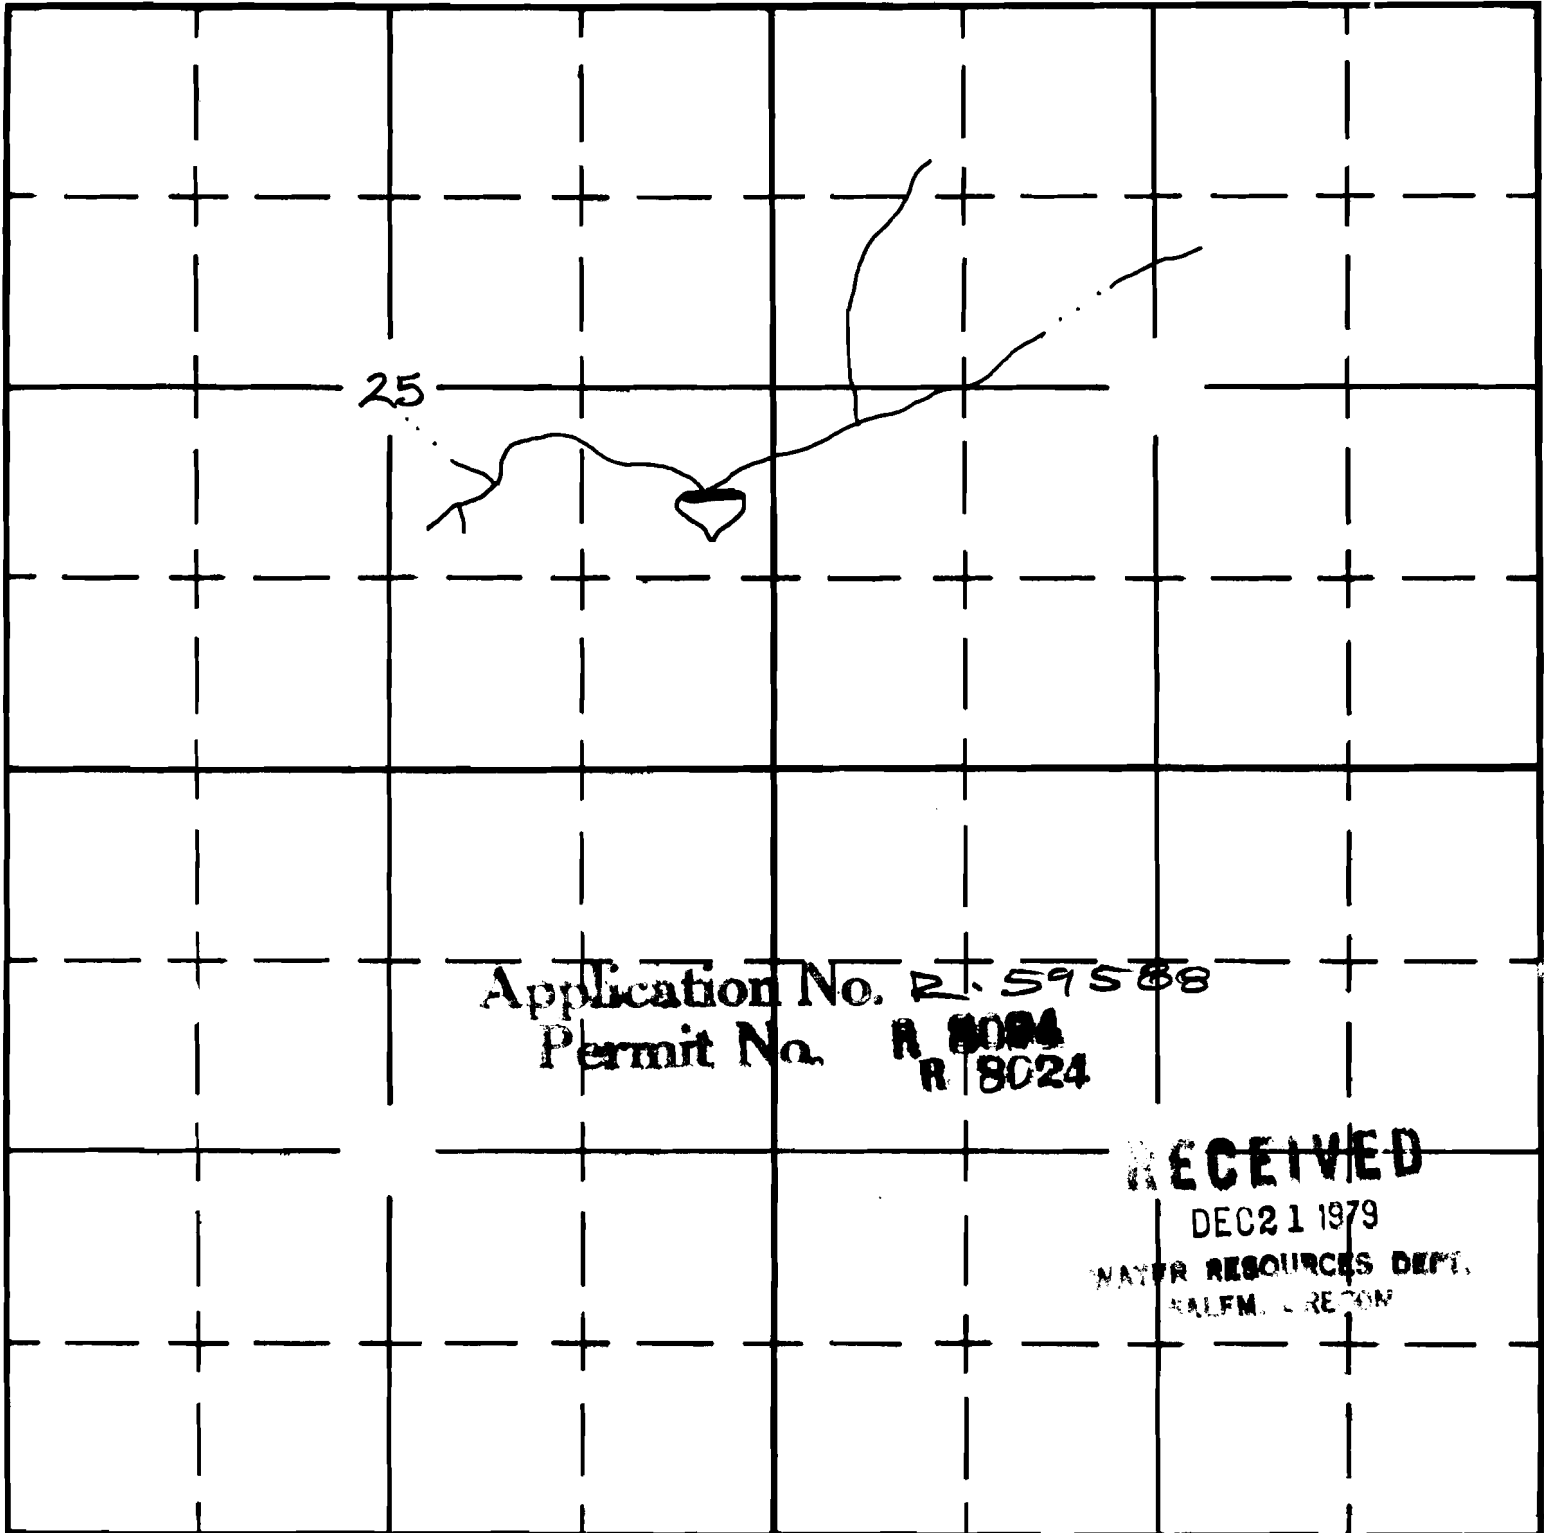

South

APPLICATION No.  
PERMIT No.

Form 187  
March 1961

UNITED STATES  
DEPARTMENT OF THE INTERIOR  
BUREAU OF LAND MANAGEMENT


SECTION 36  
25

# Oregon State Water Filings

~~NE NW~~  
NW NW

TOWNSHIP 32S, RANGE 36E, W. M.

4" = 1 MILE      ↑ North      HORSE FLAT RES. #1      10-4651

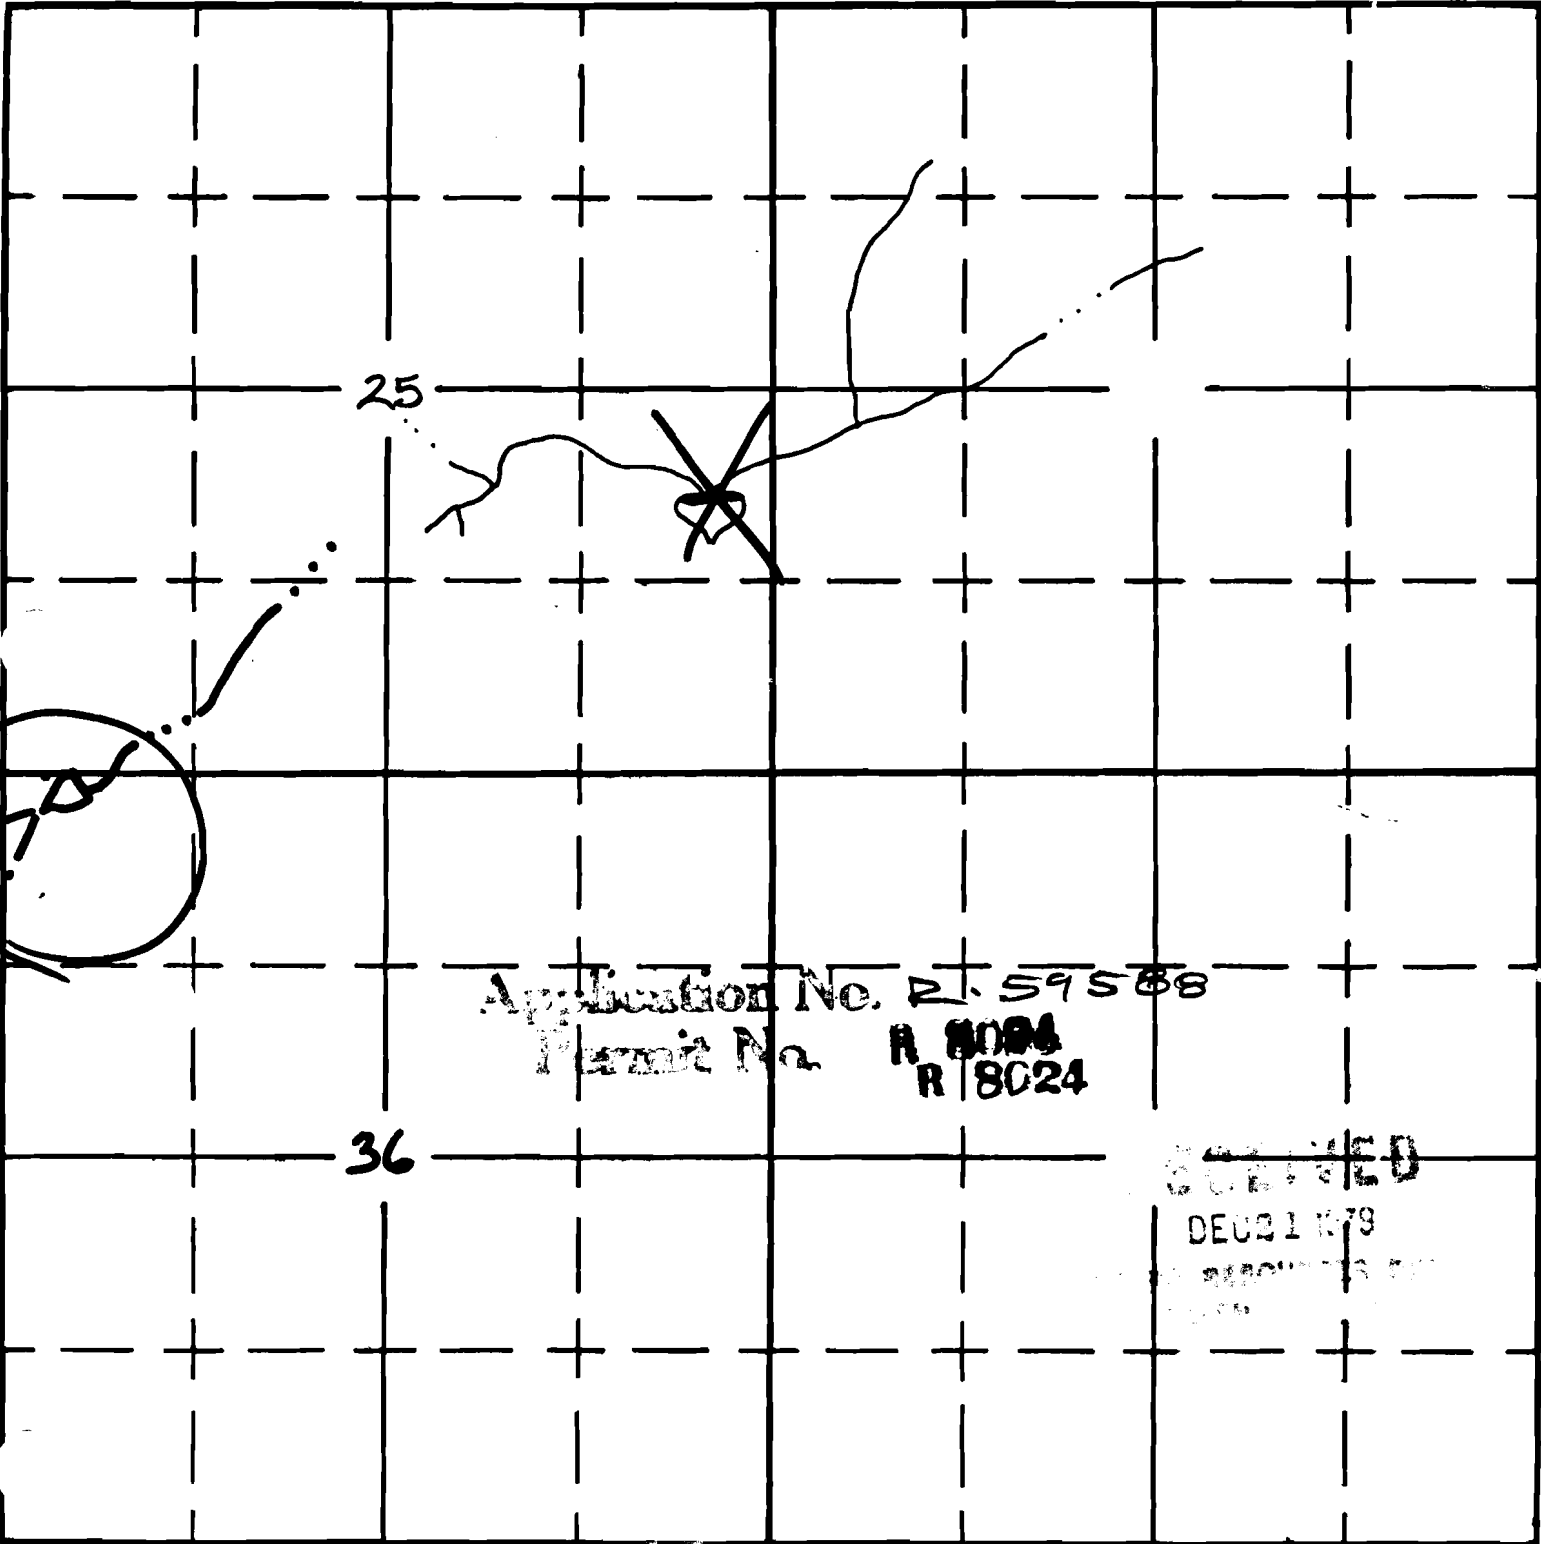

Application No. R 59588

Permit No. R 8024

36

~~RECEIVED~~


South

APPLICATION No.

PERMIT No.