

UNITED STATES
DEPARTMENT OF THE INTERIOR
BUREAU OF LAND MANAGEMENT

SECTION

10

Oregon State Water Filings


NW 1/4 SW 1/4

TOWNSHIP 33S, RANGE 32E, W. M.

4" = 1 MILE

↑
North

SQUARE RES. 09-0799

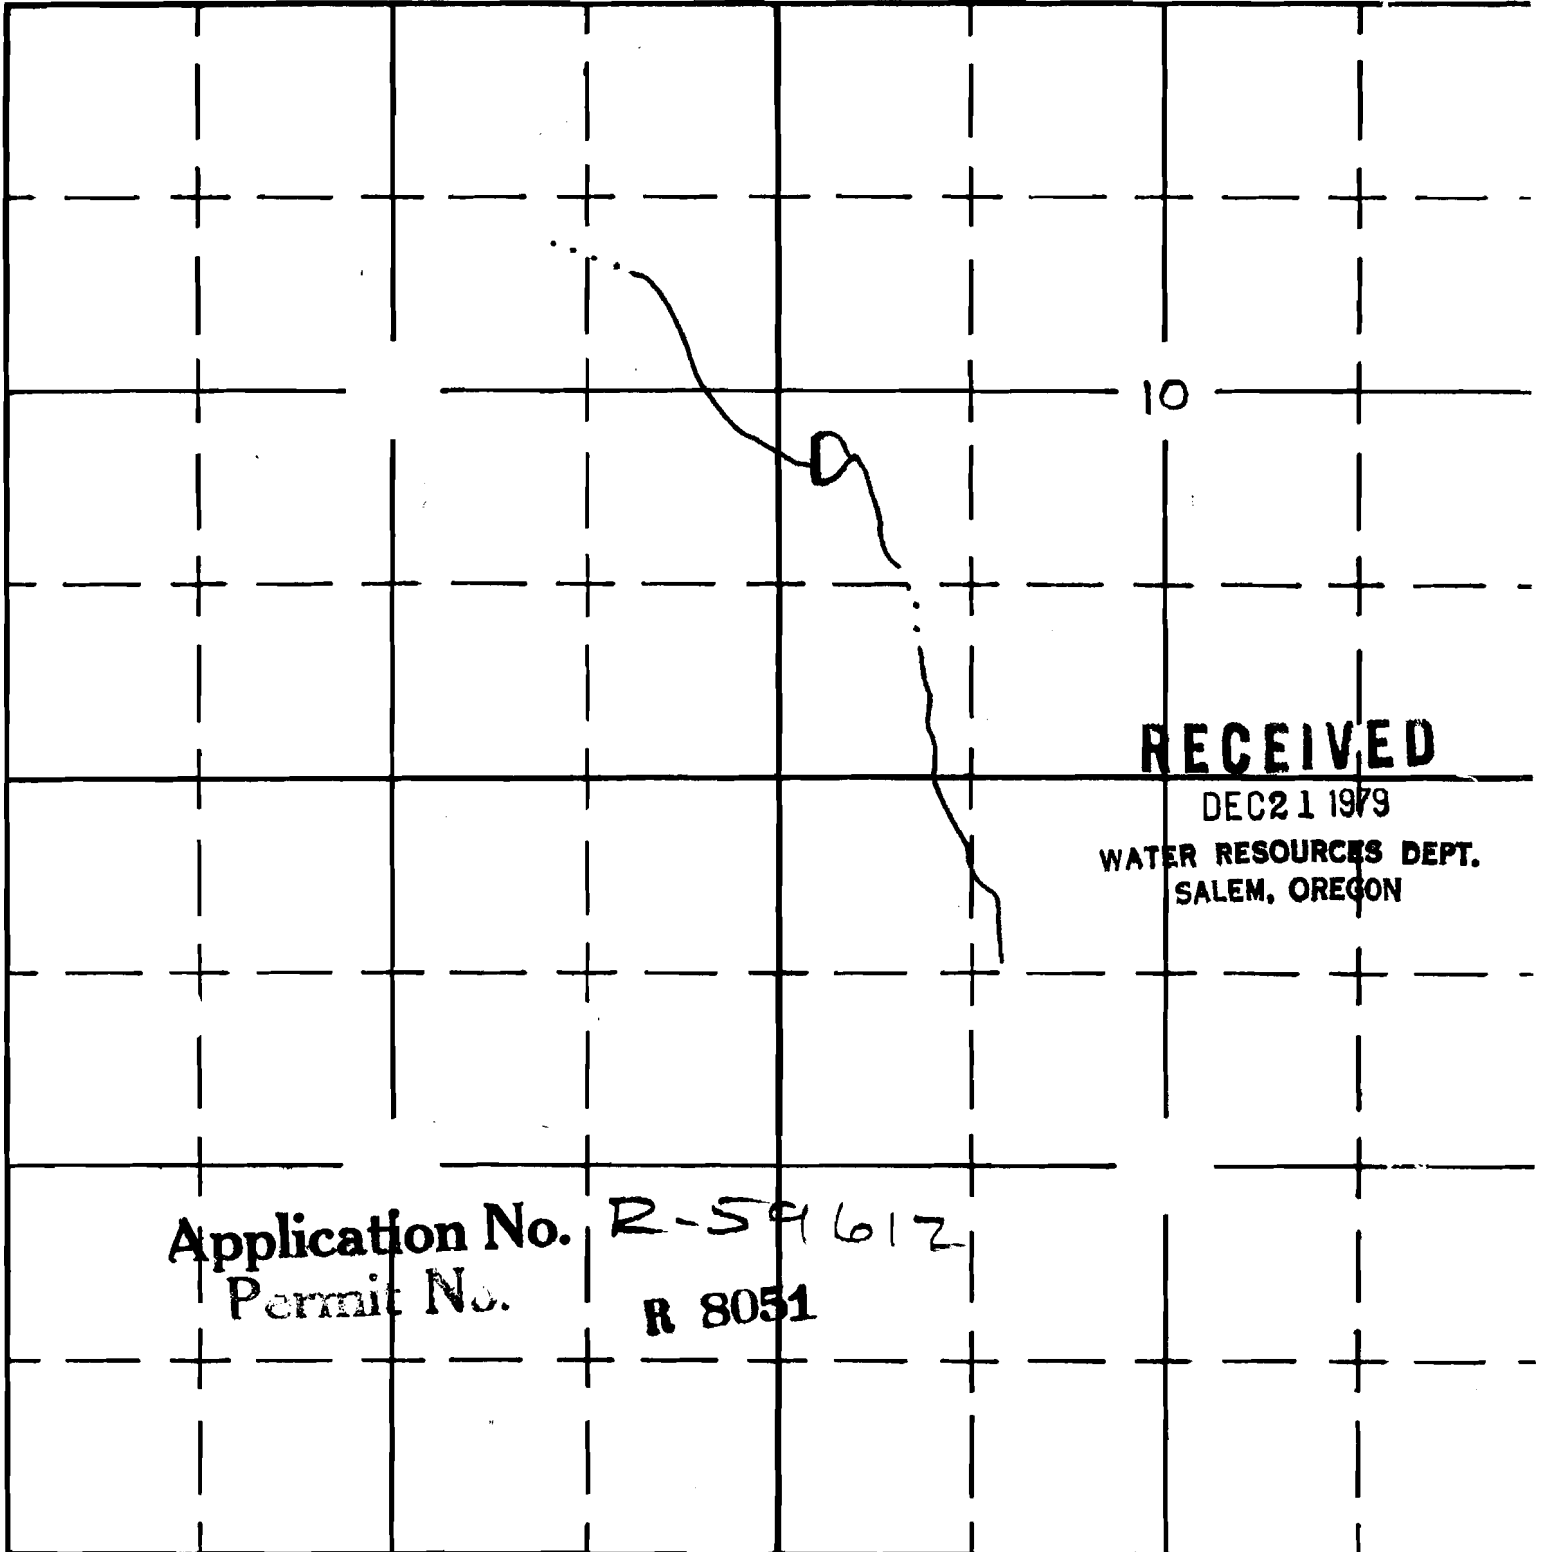

RECEIVED

DEC 21 1979

WATER RESOURCES DEPT.
SALEM, OREGON

Application No. R-59612

Permit No.

R 8051

South