


SECTION

Black Cow Reservoir

11-5028

16
NW SW

TOWNSHIP 40S, RANGE 38E, W. M.

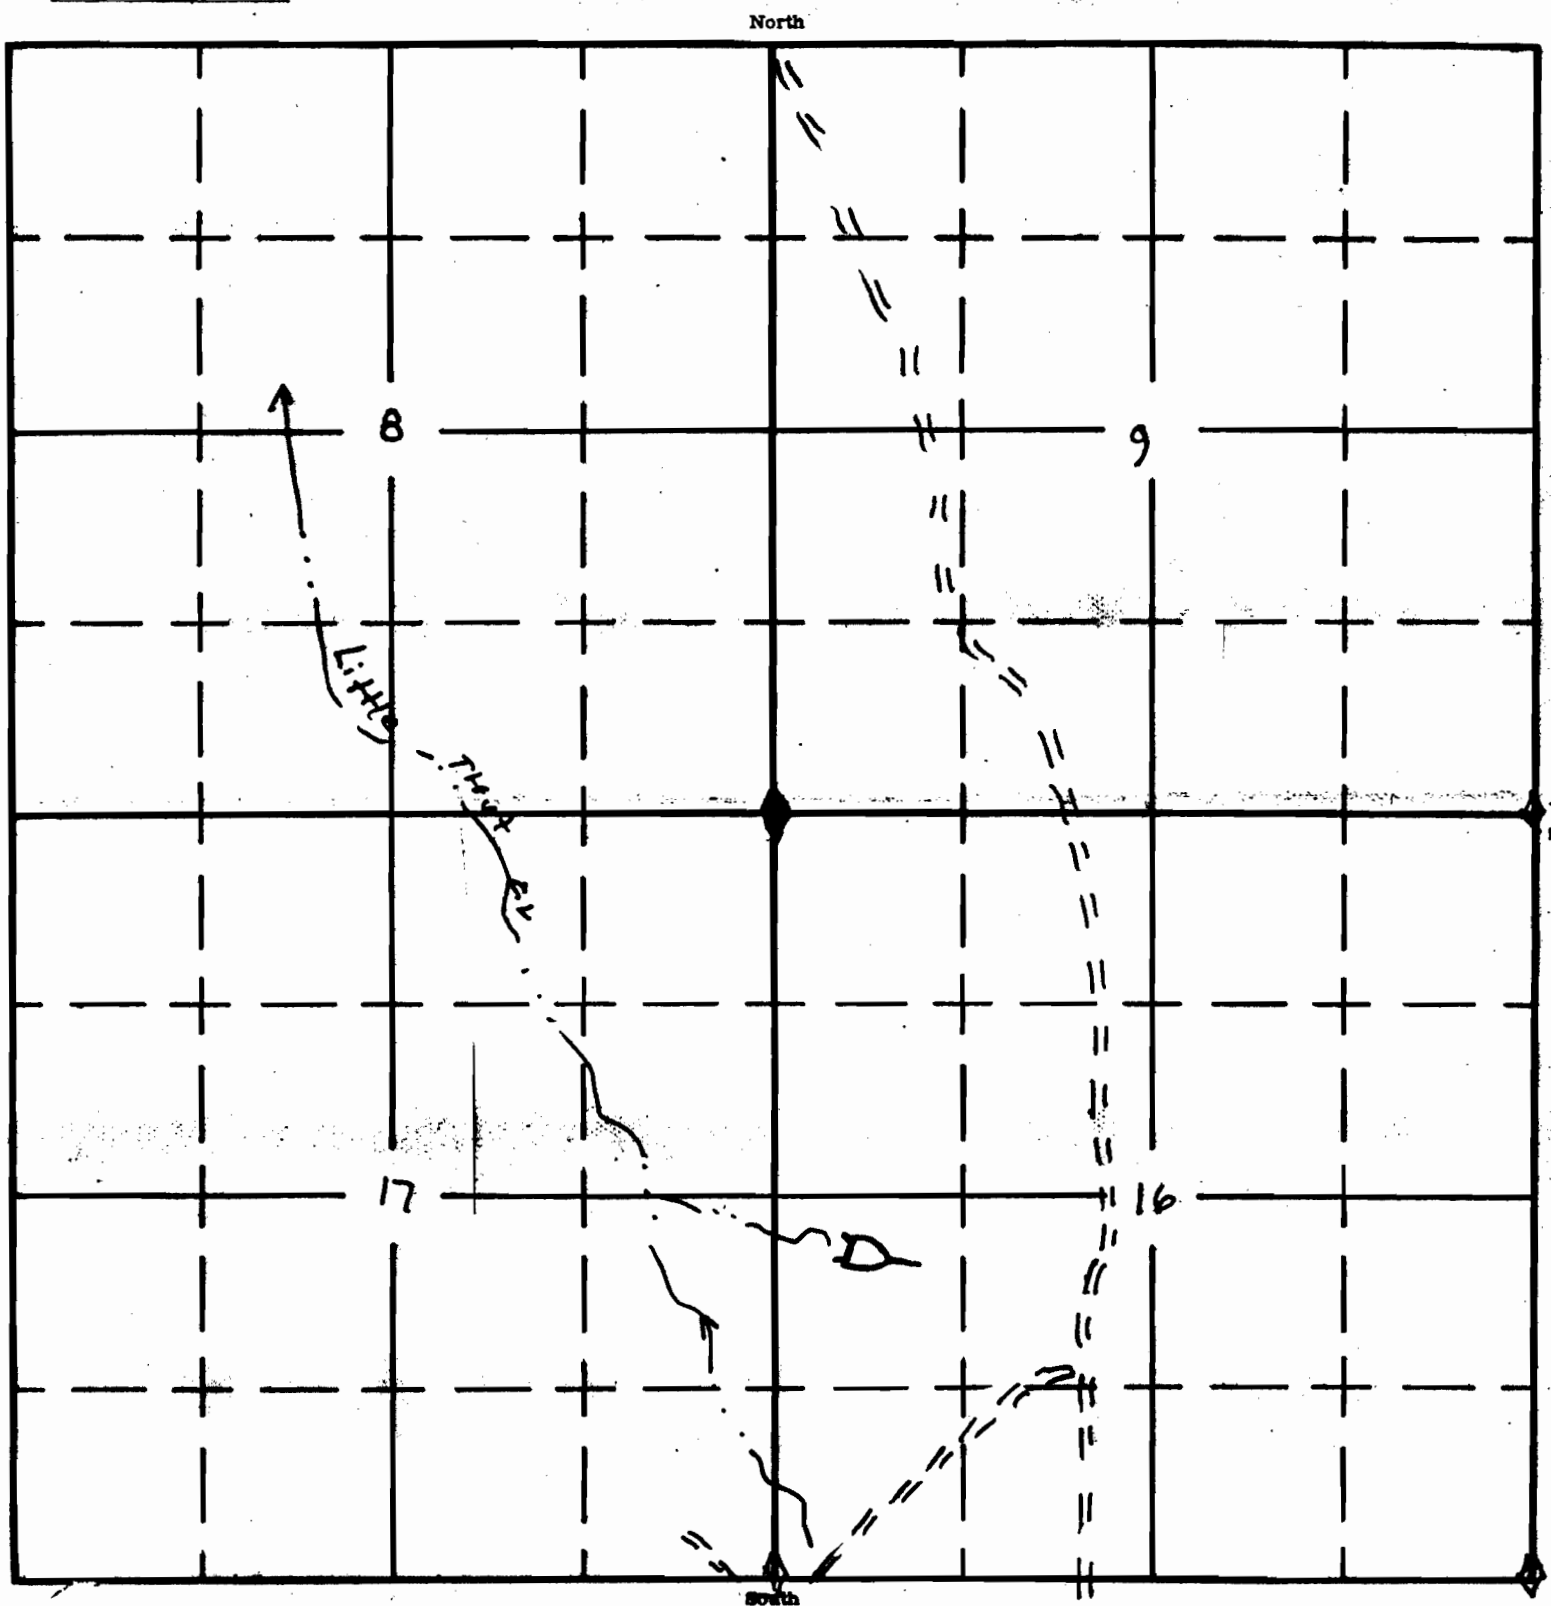

Application No. R86422
Permit No. R10201

RECEIVED

SEP 1 1983
WATER RESOURCES DEPT.
SALIM, OREGON