


SECTION

09-5423 Crud Res

TOWNSHIP 37 S, RANGE 32 3/4 E, W. M.

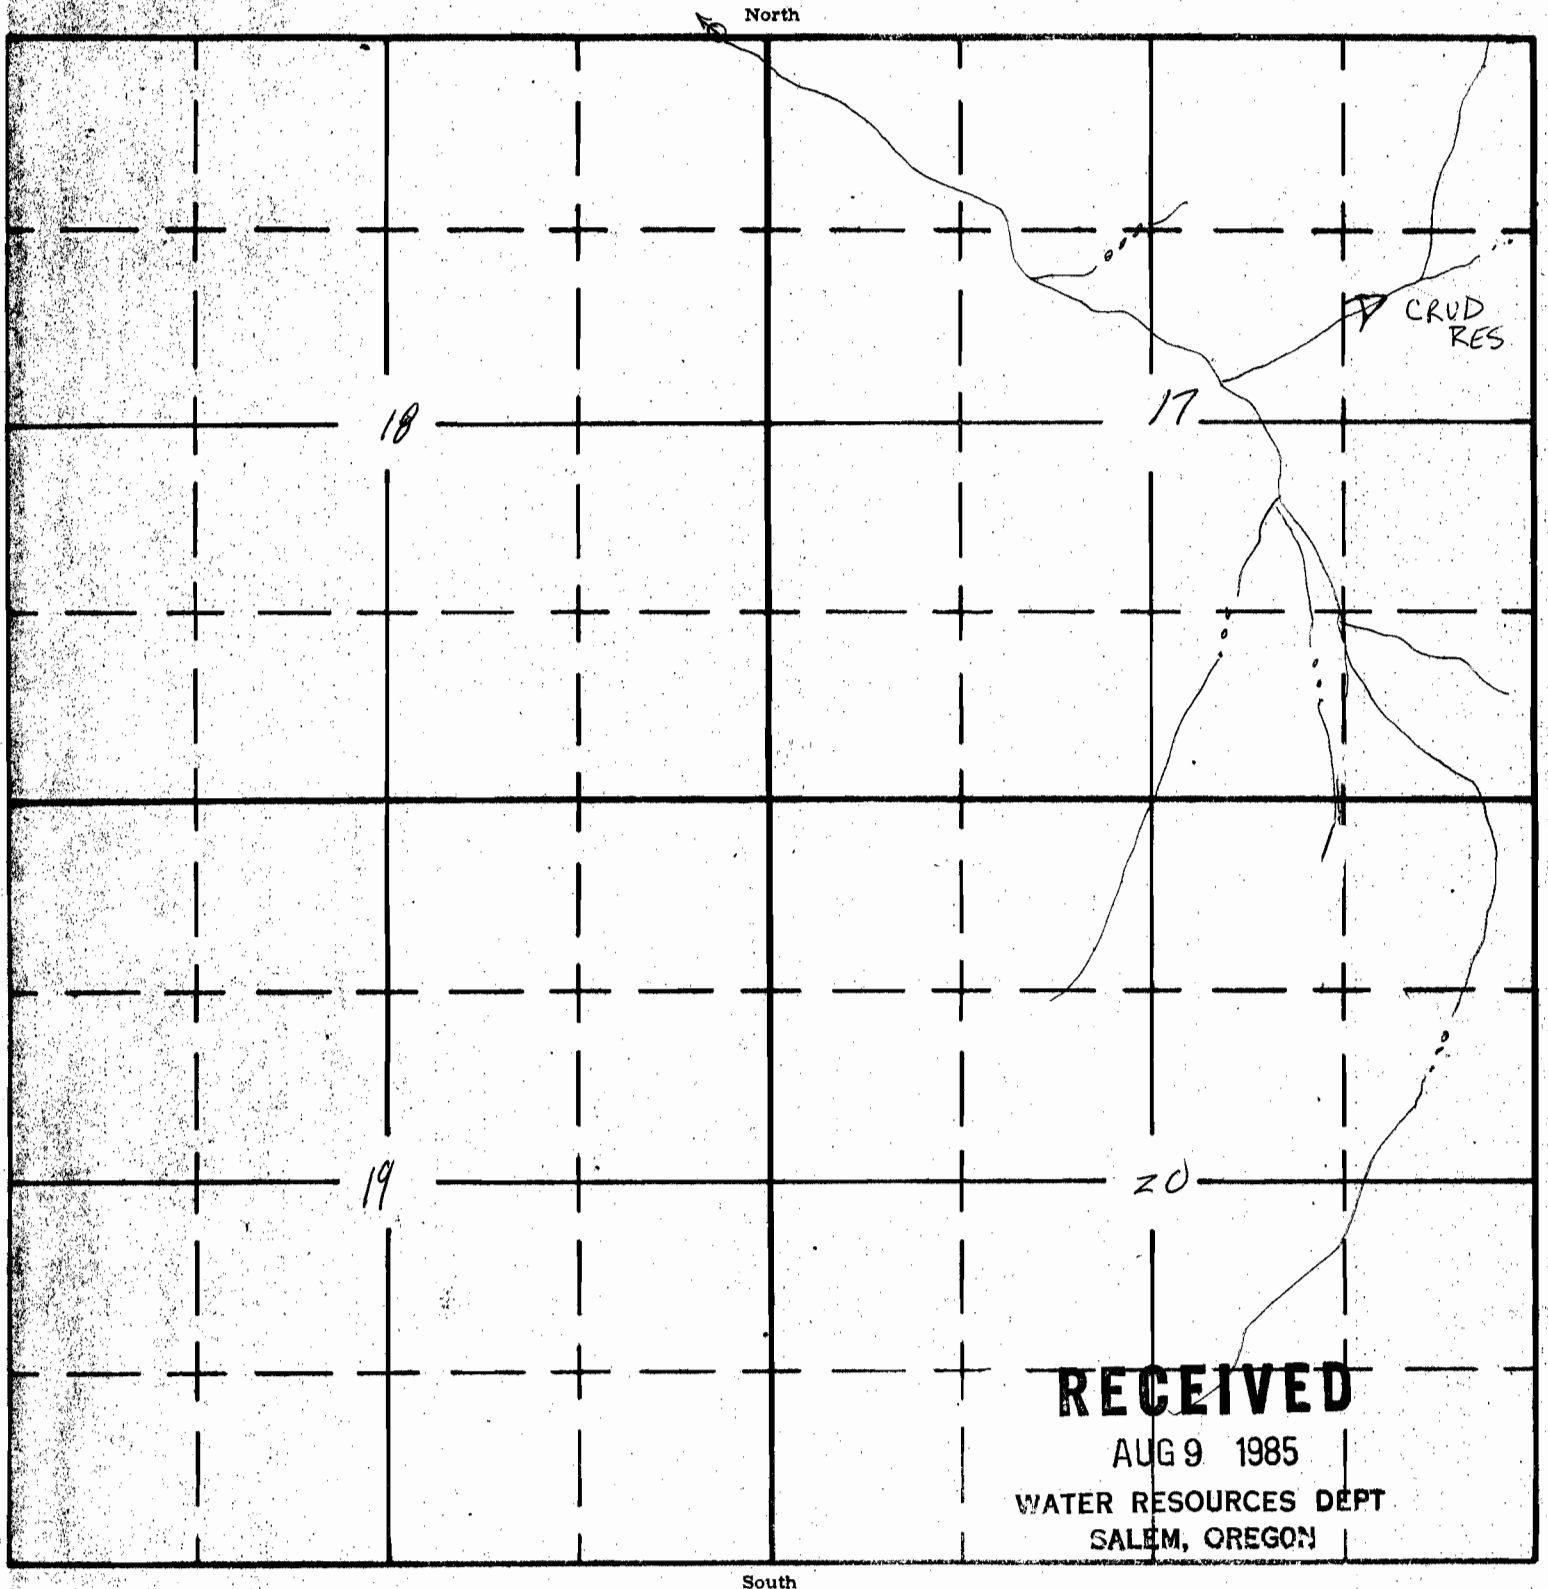

APPLICATION NO R-68519

PERMIT NQ

R10599