

SECTION


28

NW NE

TOWNSHIP 31 S, RANGE 32 E, W. M.

North

08 - 0890 GLENN Sph. Res.

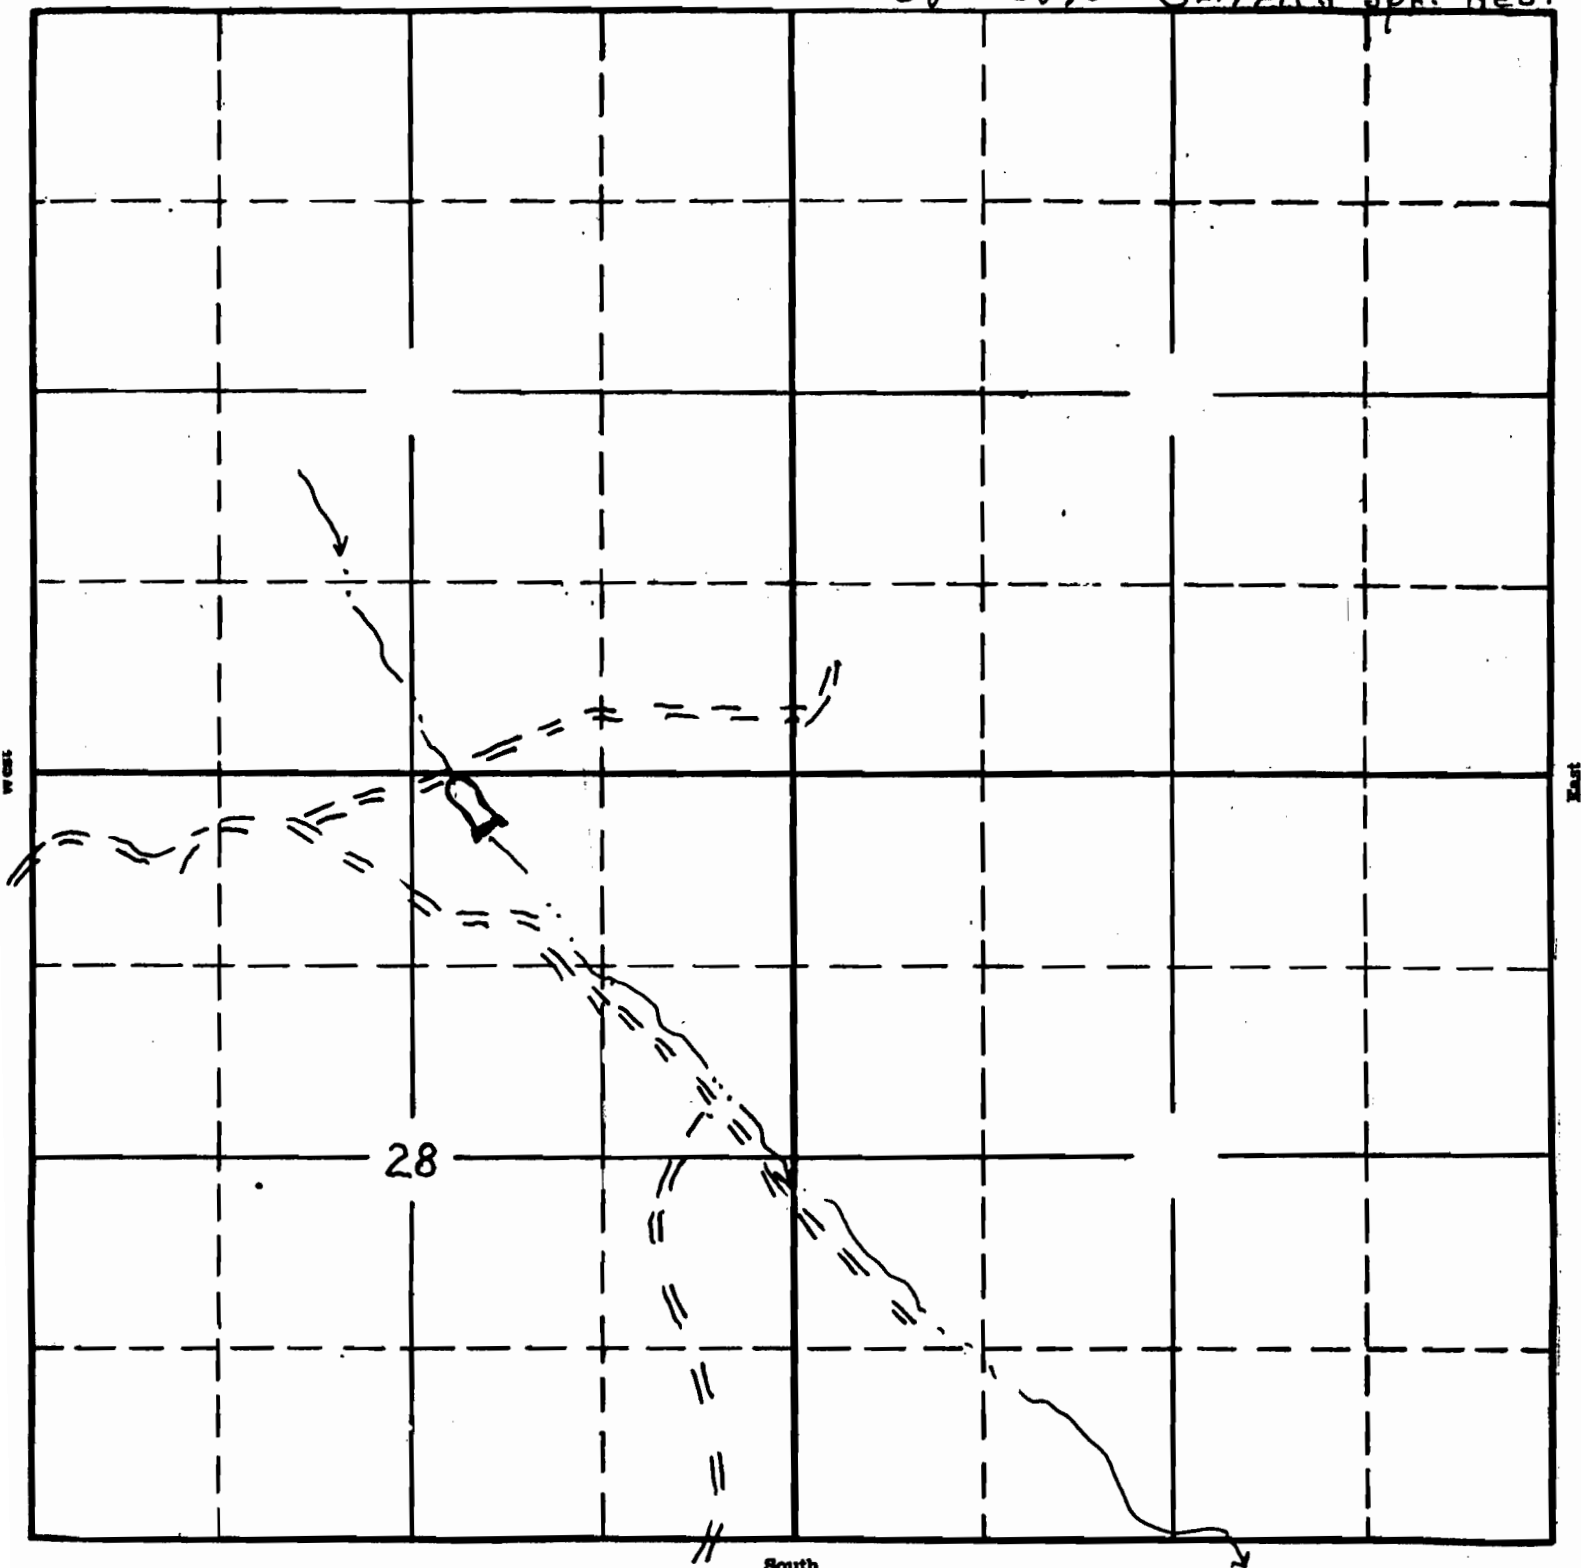

Application No. R66432  
Permit No. R10210

APPLICATION No.  
PERMIT No.