SECTION
31
NE¼SE¼

10-4727
Table Mtn. Res

TOWNSHIP 31S, RANGE 37E, W. M.

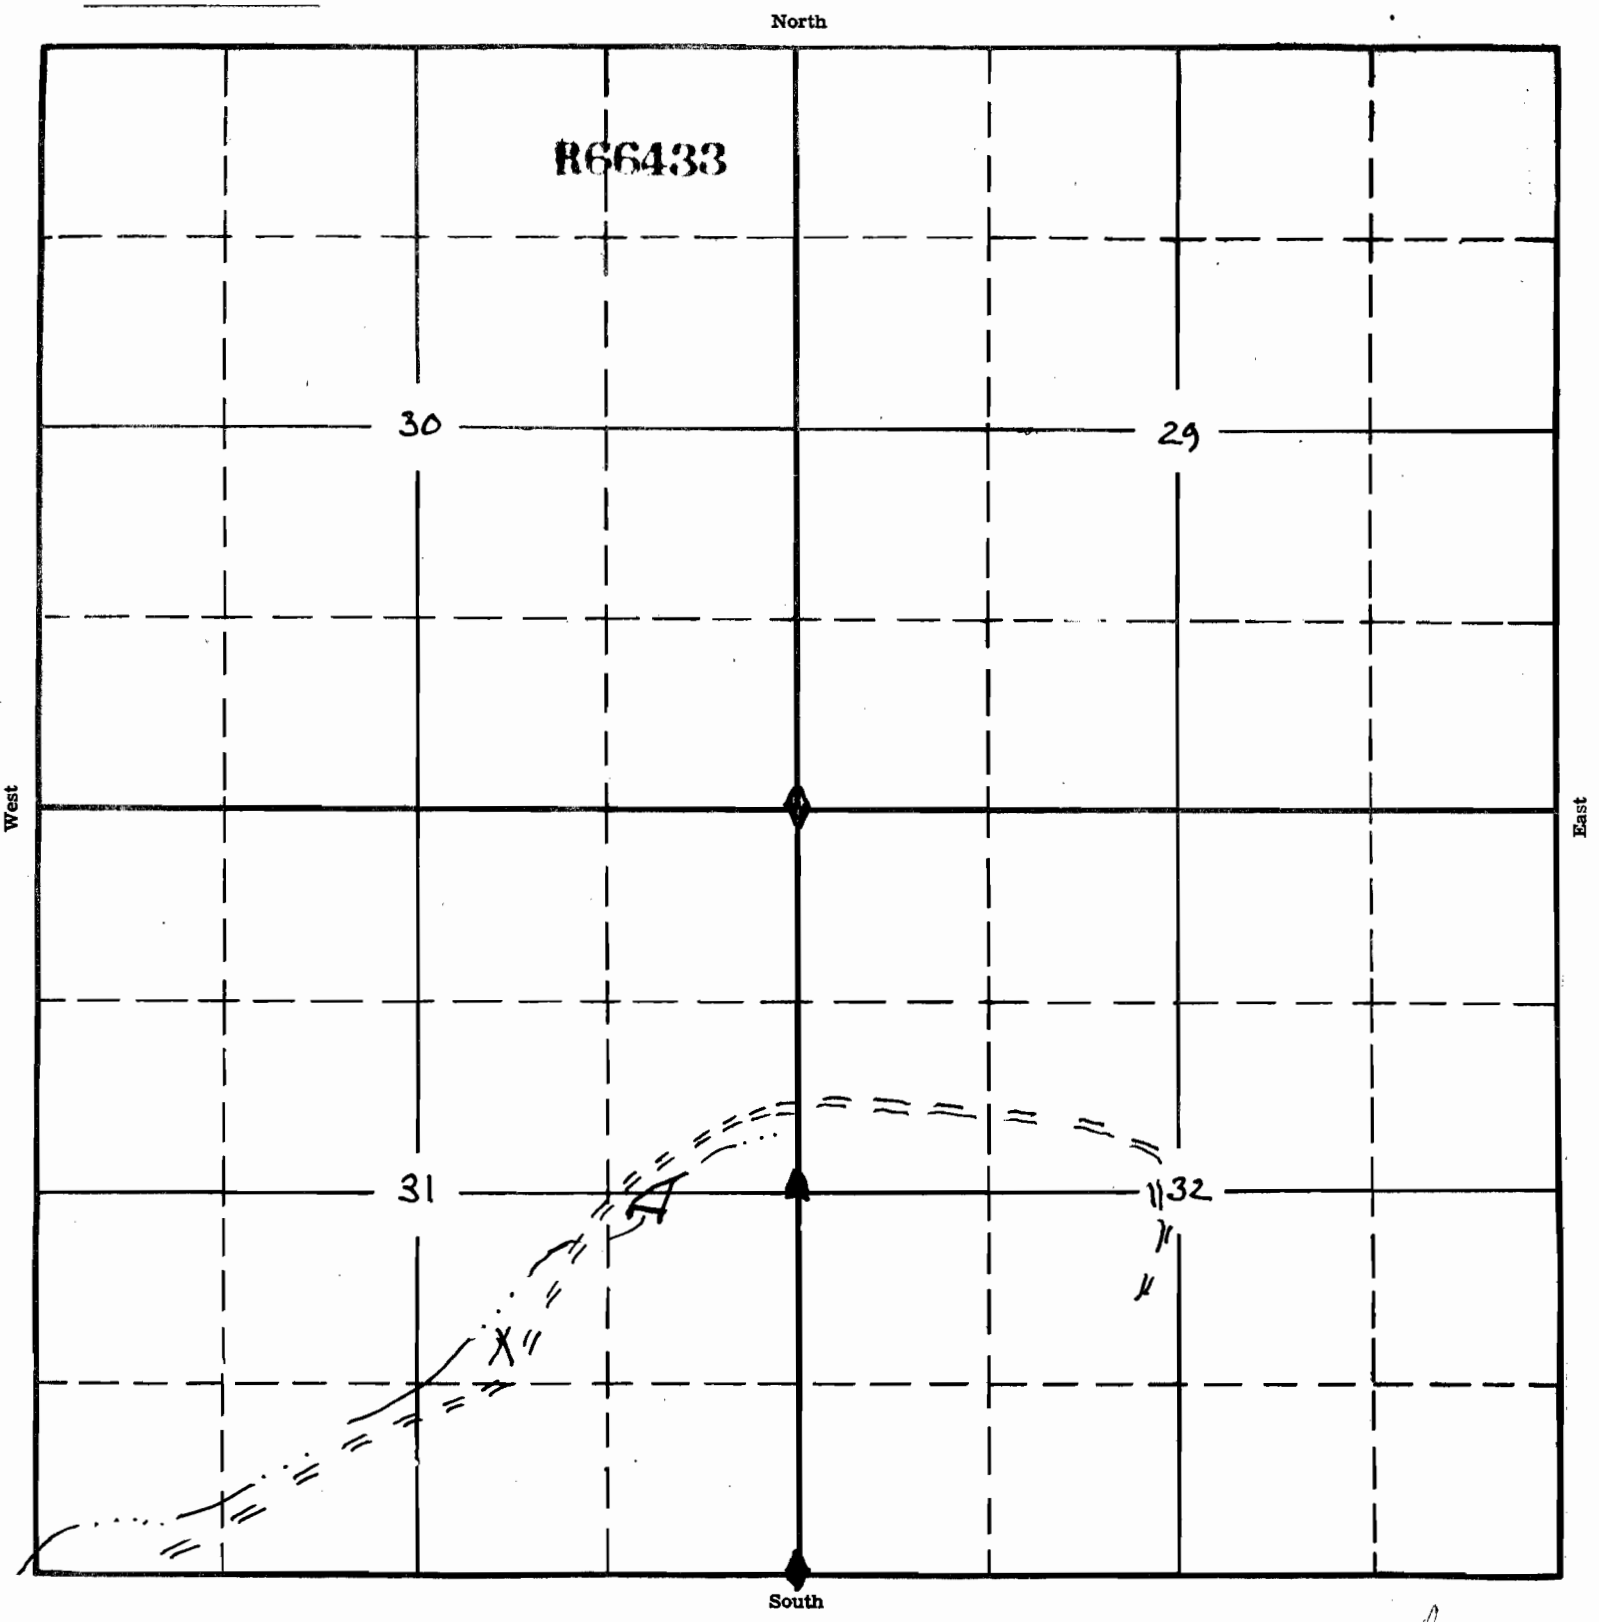

APPLICATION No. R-66433