


SECTION

29 NWNE

TOWNSHIP 21 S, RANGE 27 E, W. M.

North #0788 - Fox-Deer Co.

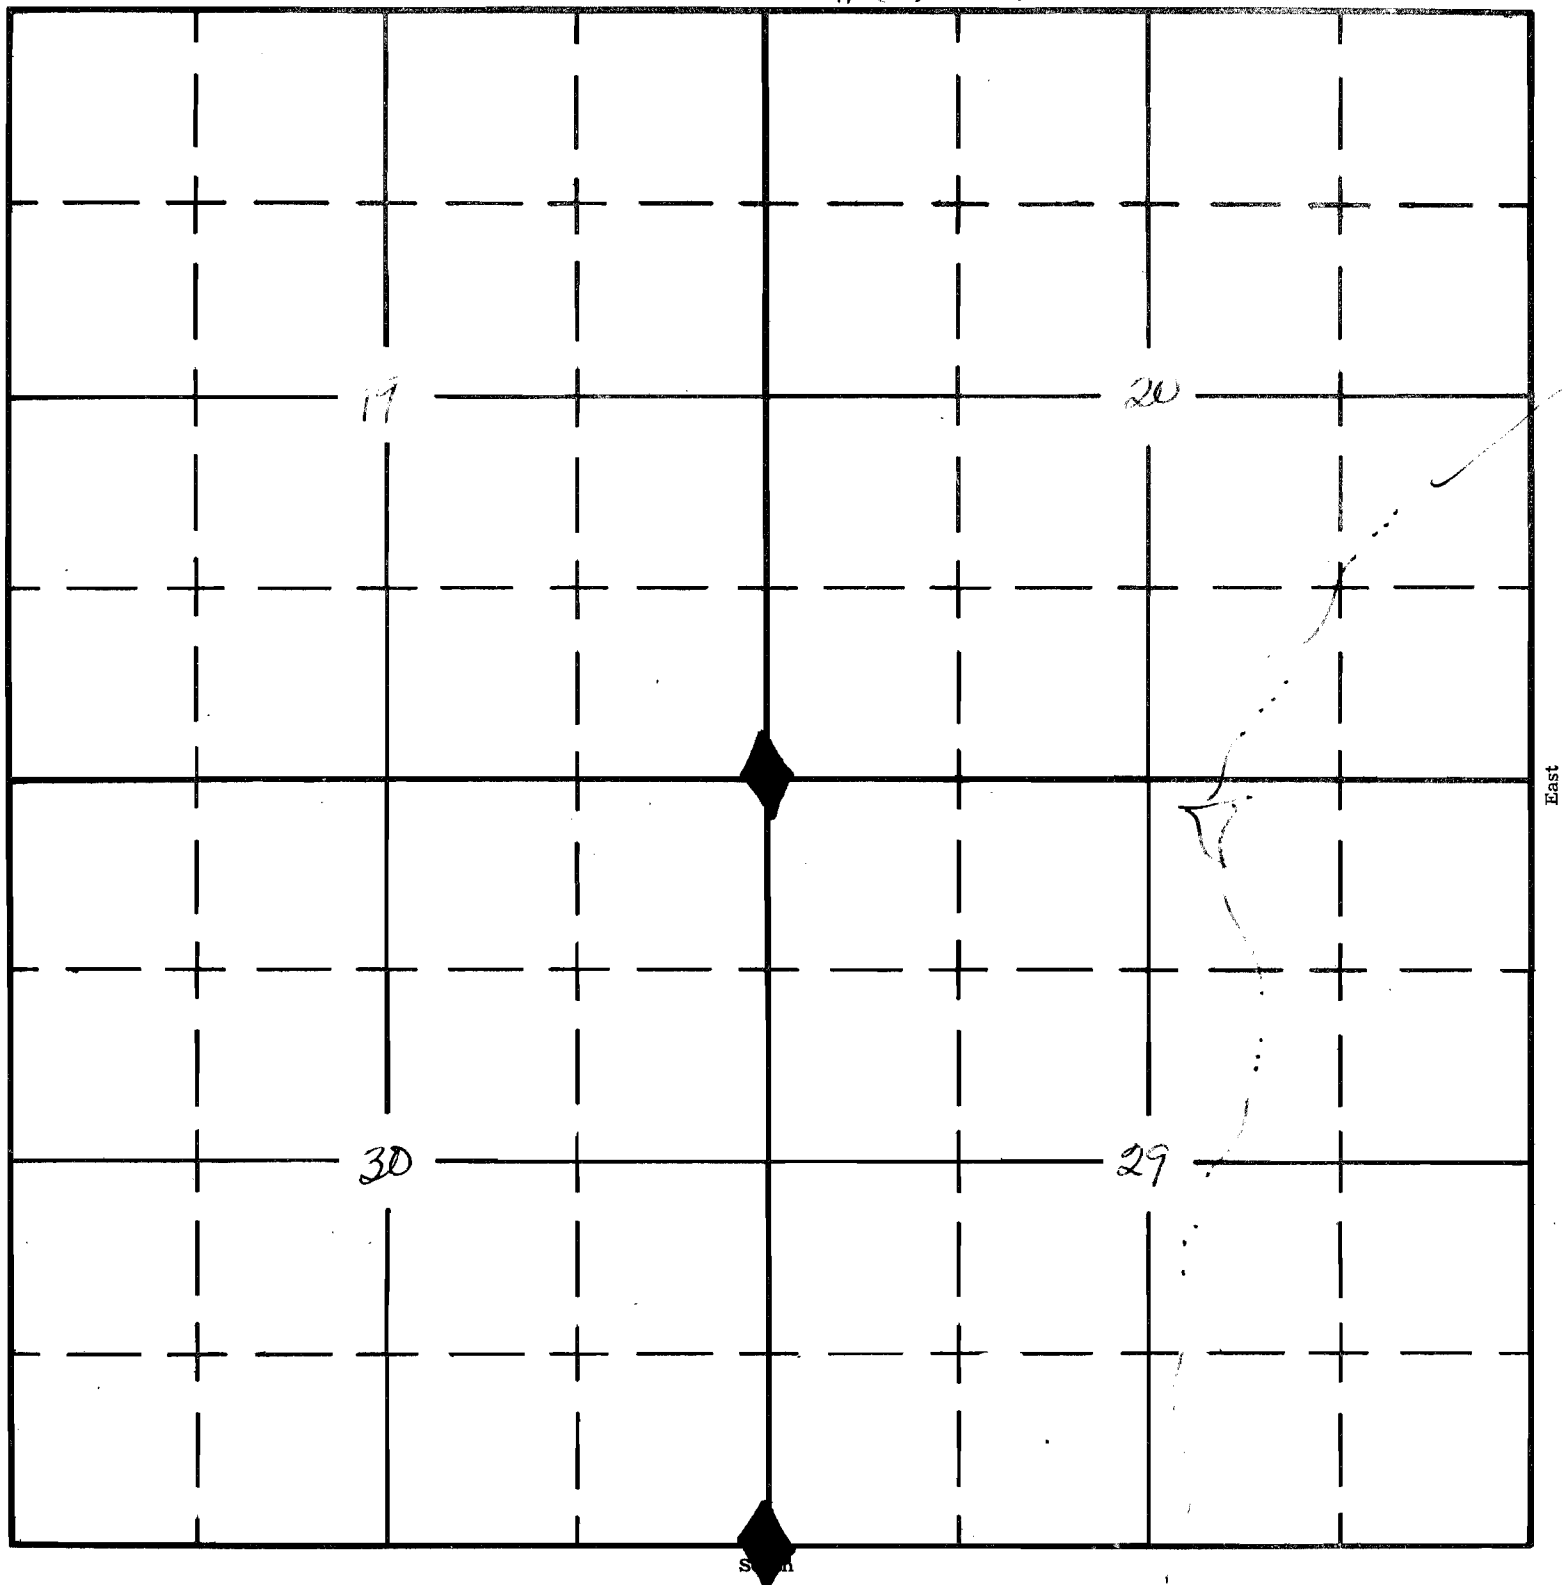

Application No. R66439

Permit No. R10514