


SECTION

10 NW NE

TOWNSHIP 29.3, RANGE 26.2, W. M.

North #4733 - Rawhide Spr. & WH

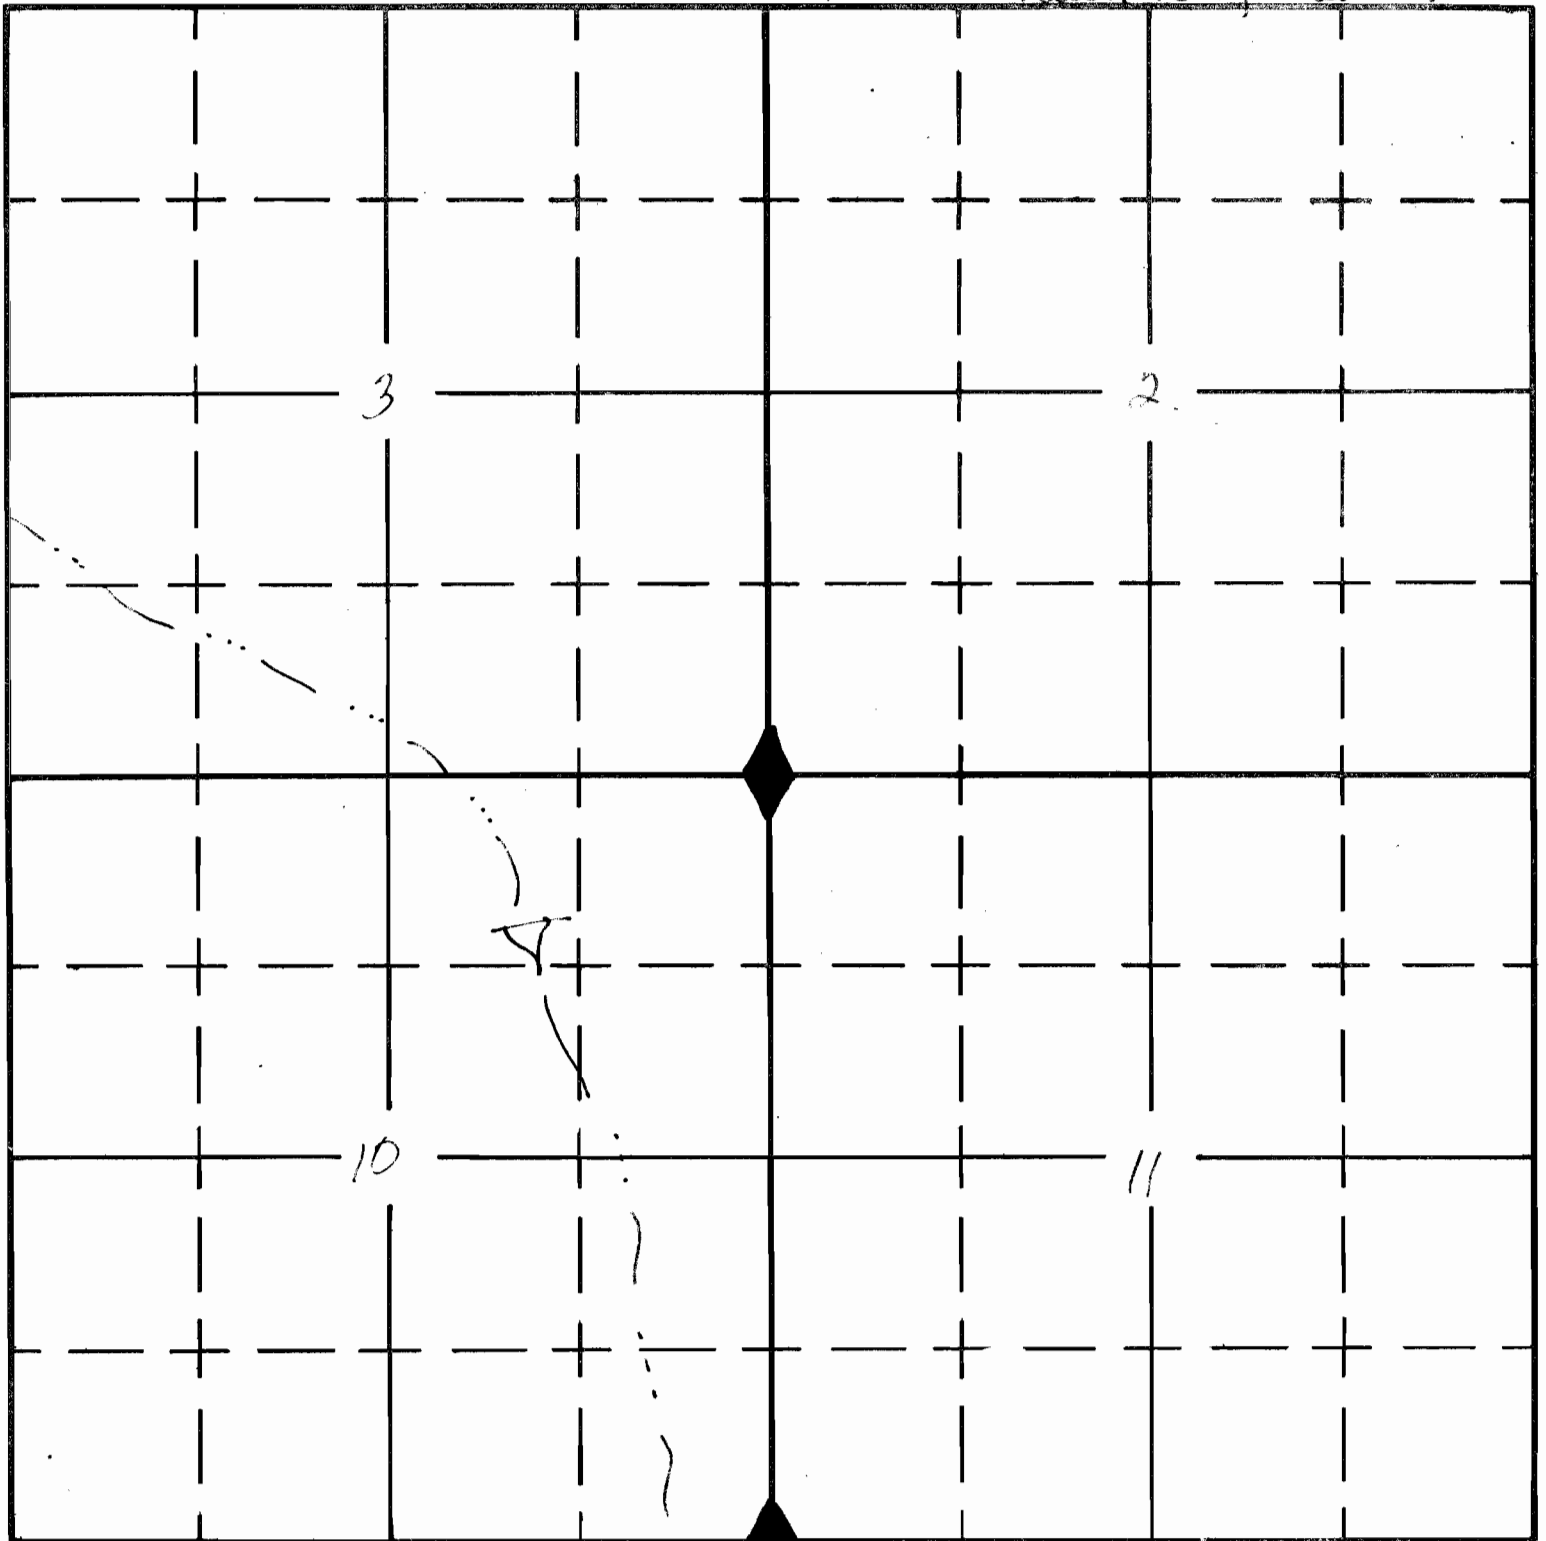

Application No.
Permit No.

RG6440
R10215

RECEIVED
SEP 2 1983
LAND RESOURCES DEPT.
SALEM, OREGON