


SECTION

20 NESW

TOWNSHIP 29 S., RANGE 30 E., W. M.

North # 4494-Black Rim Res.

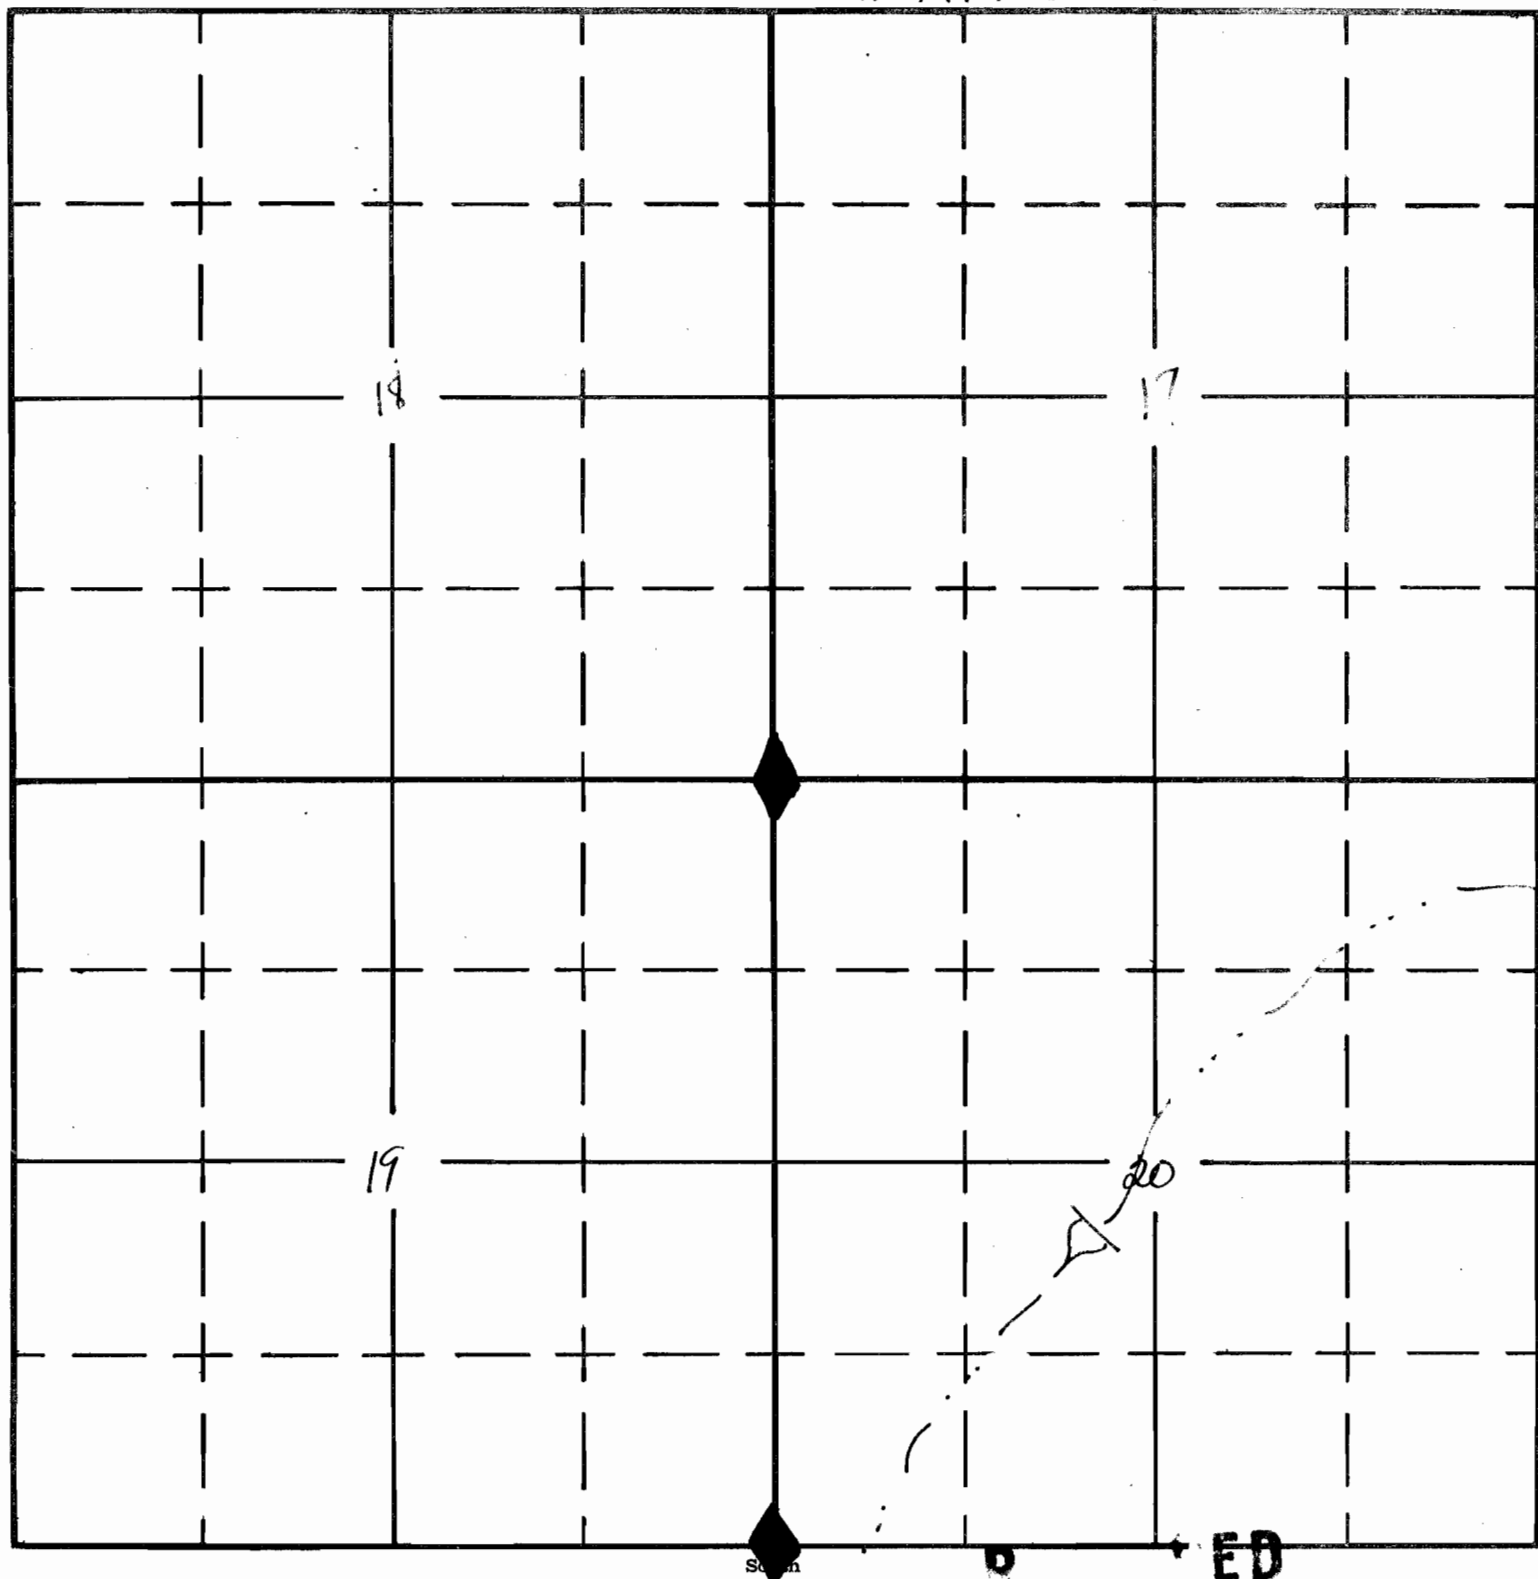

Application No. R66442
Permit No. R10217

SEP 21 1983
UNITED RESOURCES DEPT.
SALEM, OREGON