


SECTION

24 SE SW

TOWNSHIP 29 S, RANGE 29 3/4 E, W. M.

North #4332-Second Lake 104

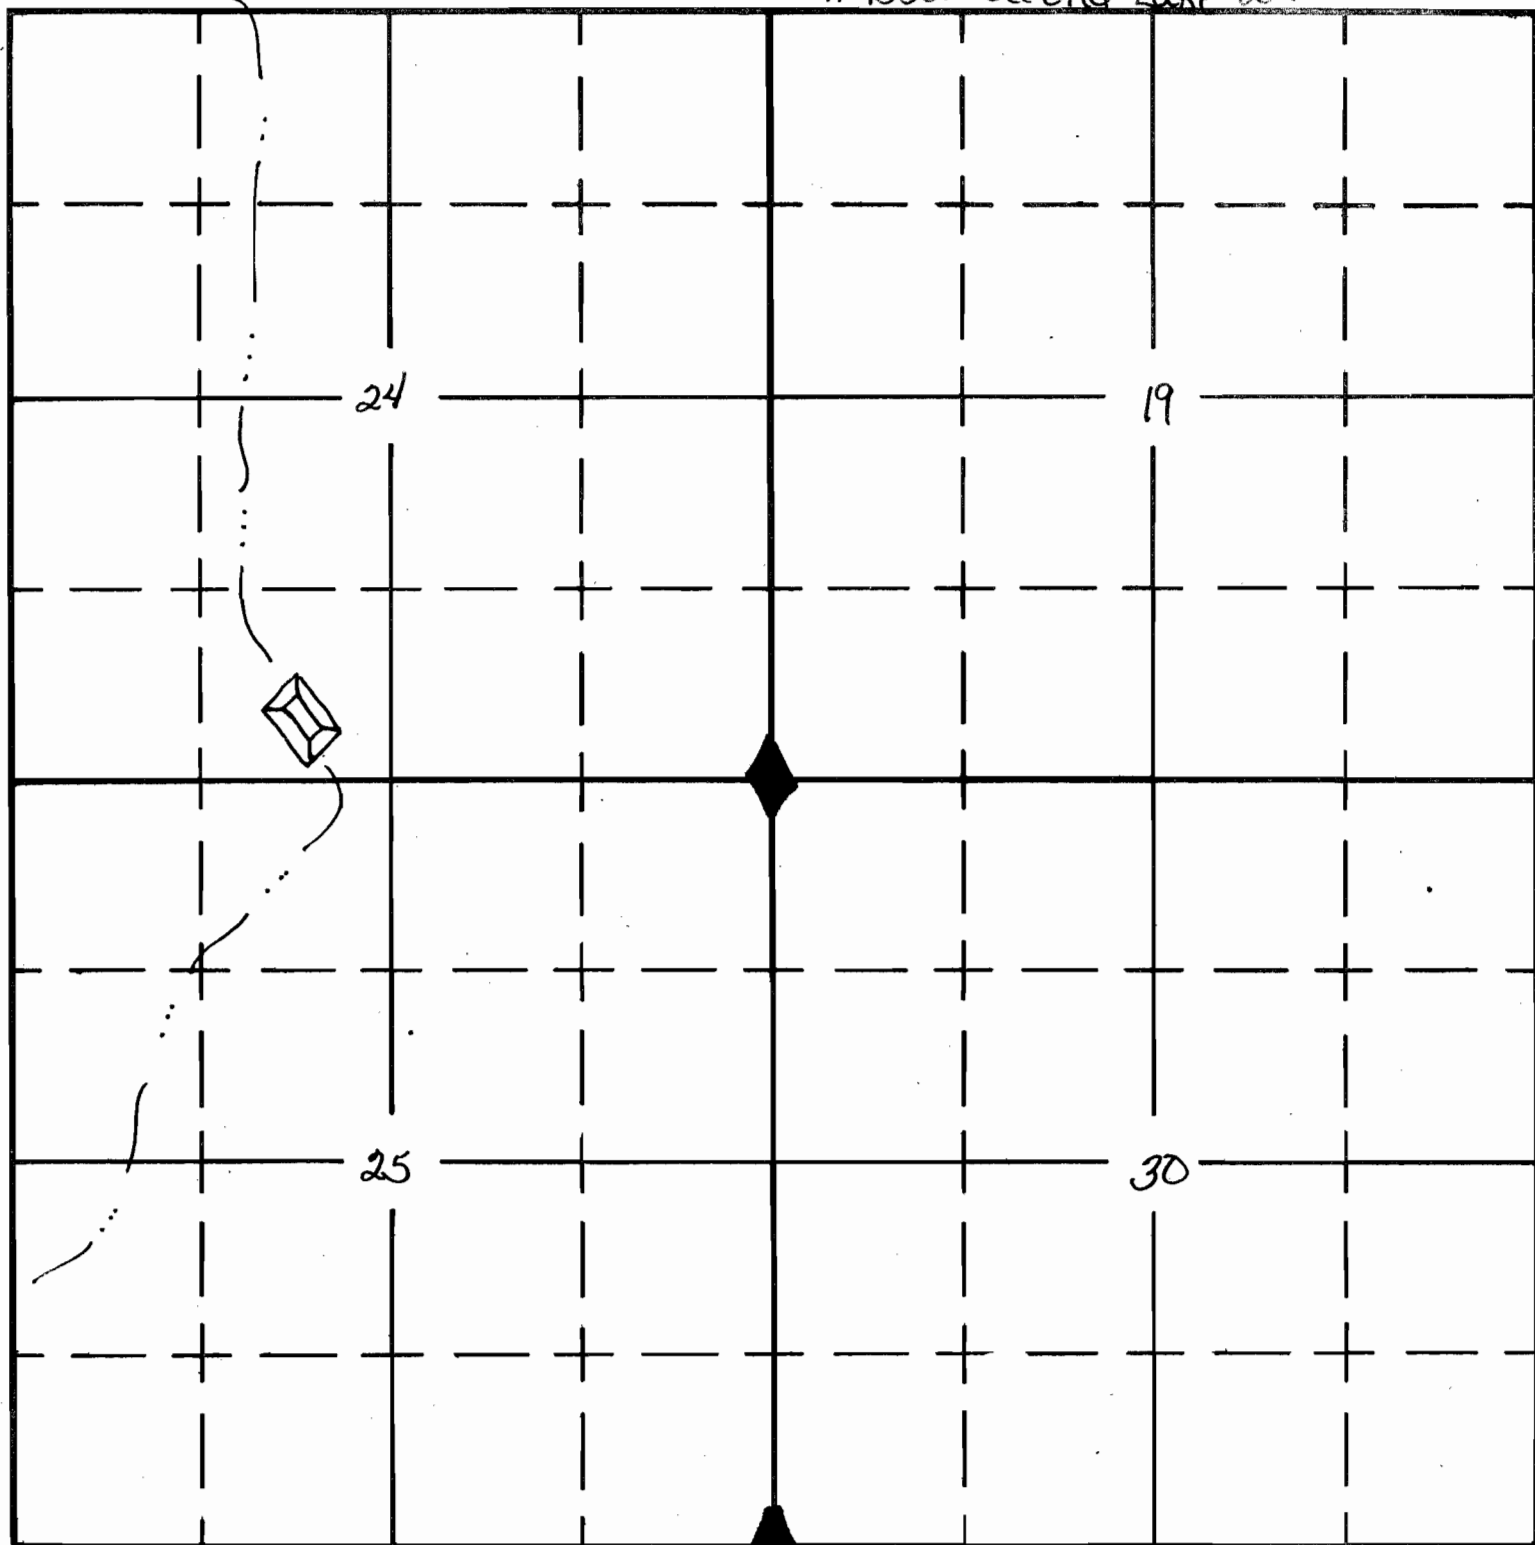

Application No. R66445

Permit No. R10220

SEP 2 1988
RECEIVED CES-CLERK
SALEM, OREGON