


SECTION

25 NE NW

TOWNSHIP 29 S, RANGE 28 E, W. M.

North #4330-Alex Spr. As.

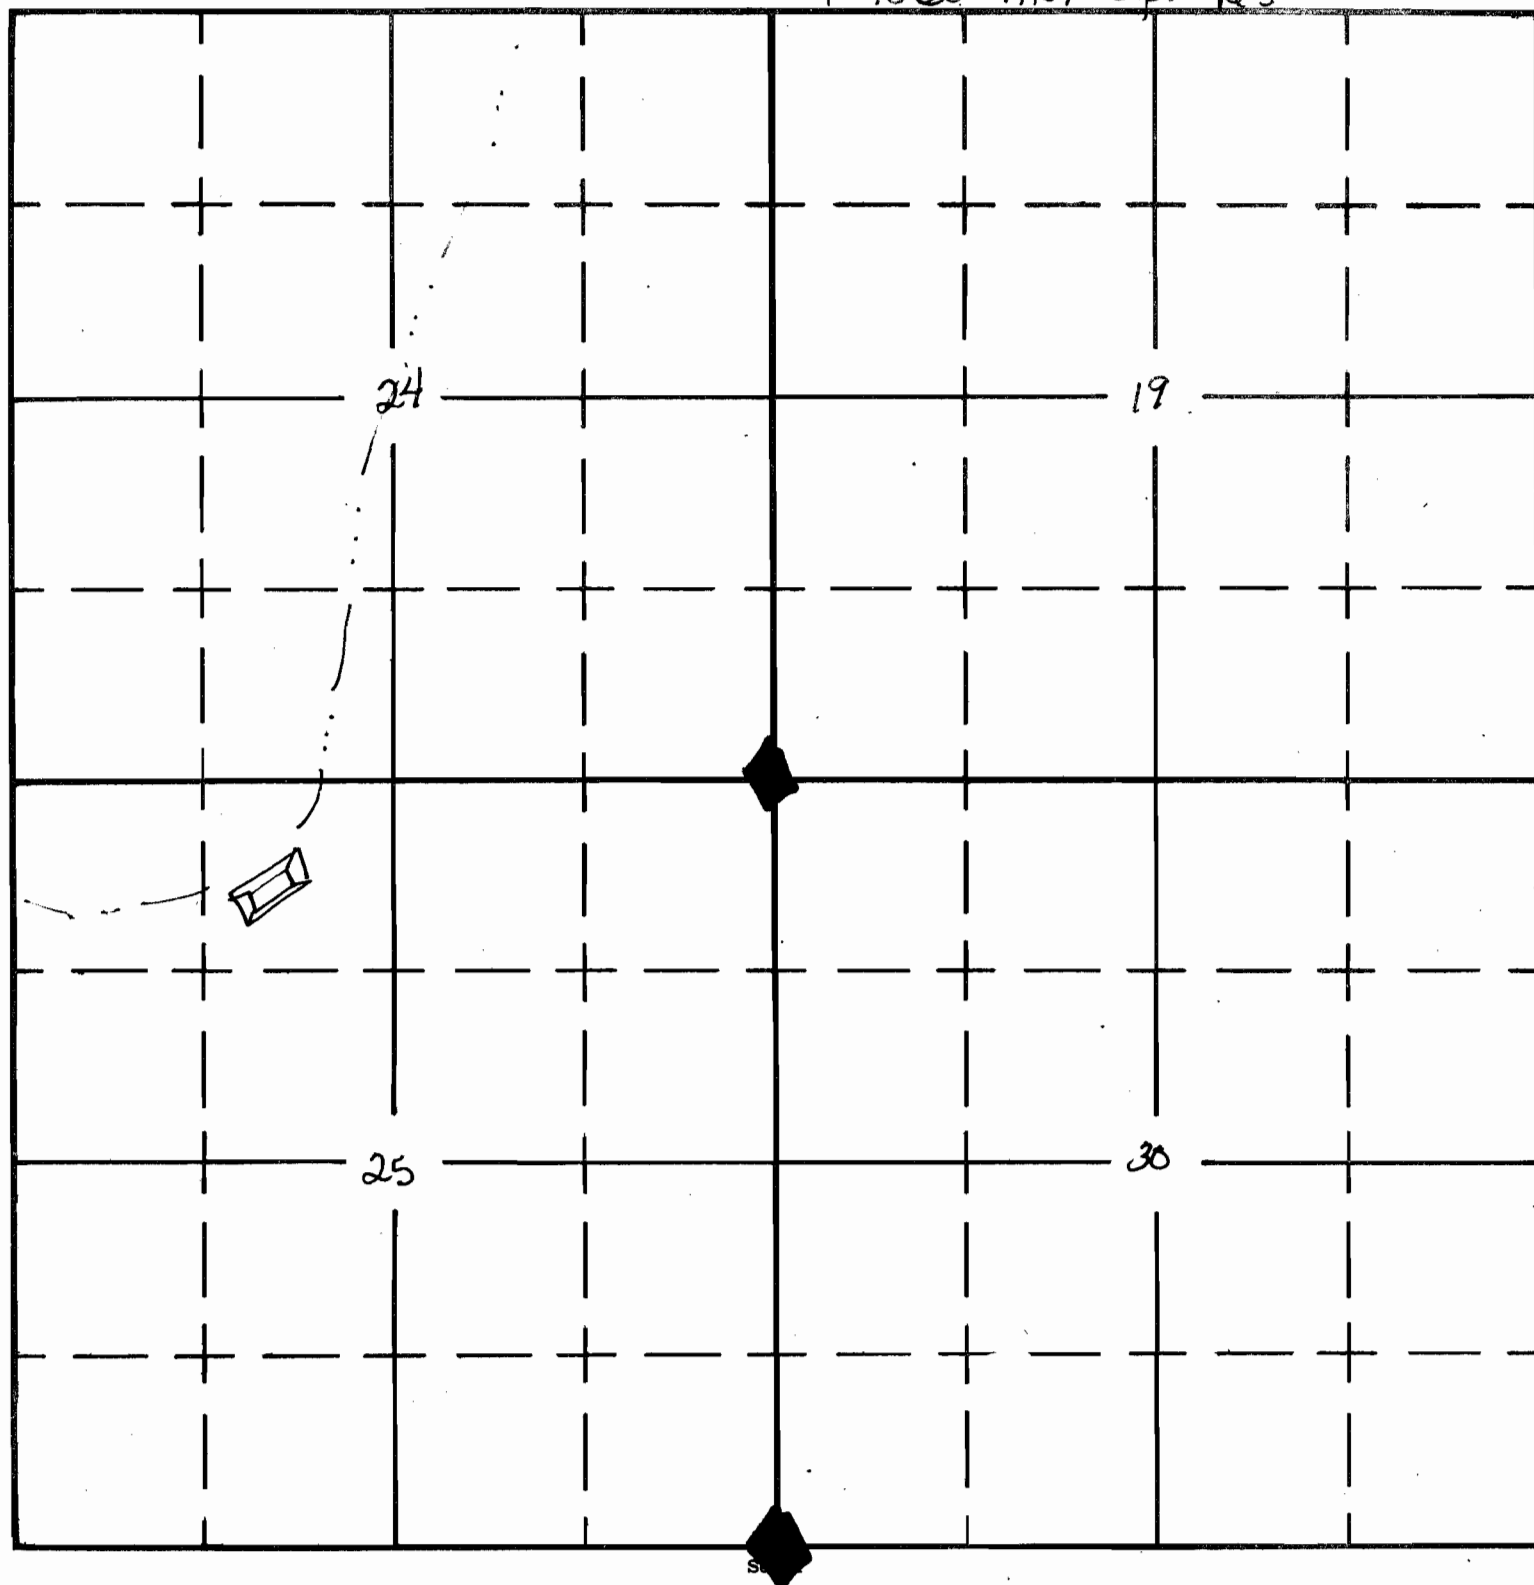

Application No. R66446
Permit No. R10221

RECEIVED
SEP 21 1983
WATER RESOURCES DEPT.
SALEM, OREGON