


SECTION

20 NE SE

TOWNSHIP 27S, RANGE 27E, W. M.

North 4324 - Spray WH

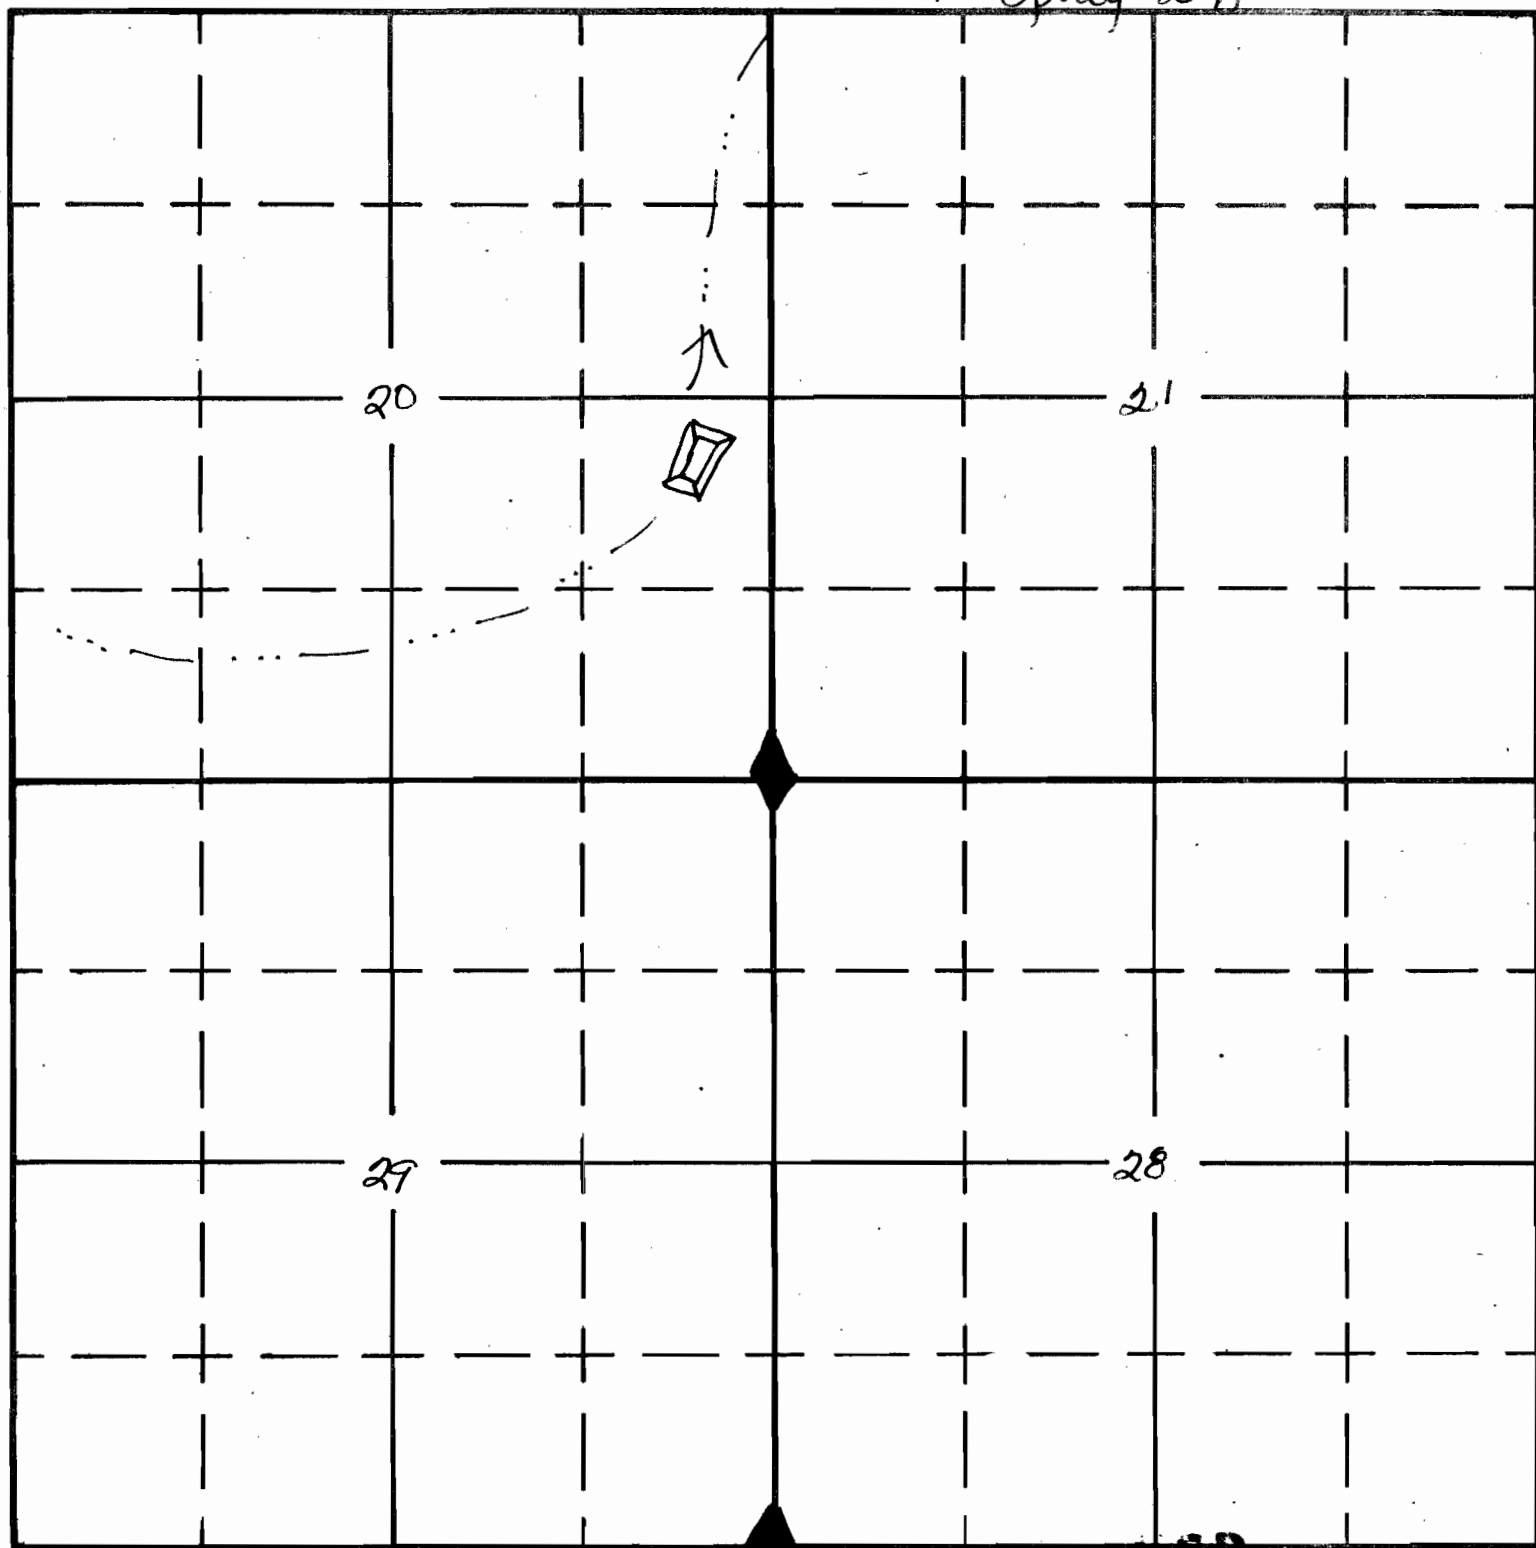

Application No. R66447

File No. R10222

SEP 2 1983
UNITED RESOURCES DEPT.
SALEM, OREGON