


SECTION

14 SW SW

TOWNSHIP 29 S, RANGE 29 E, W. M.

North #4319- Lone Horse Res.

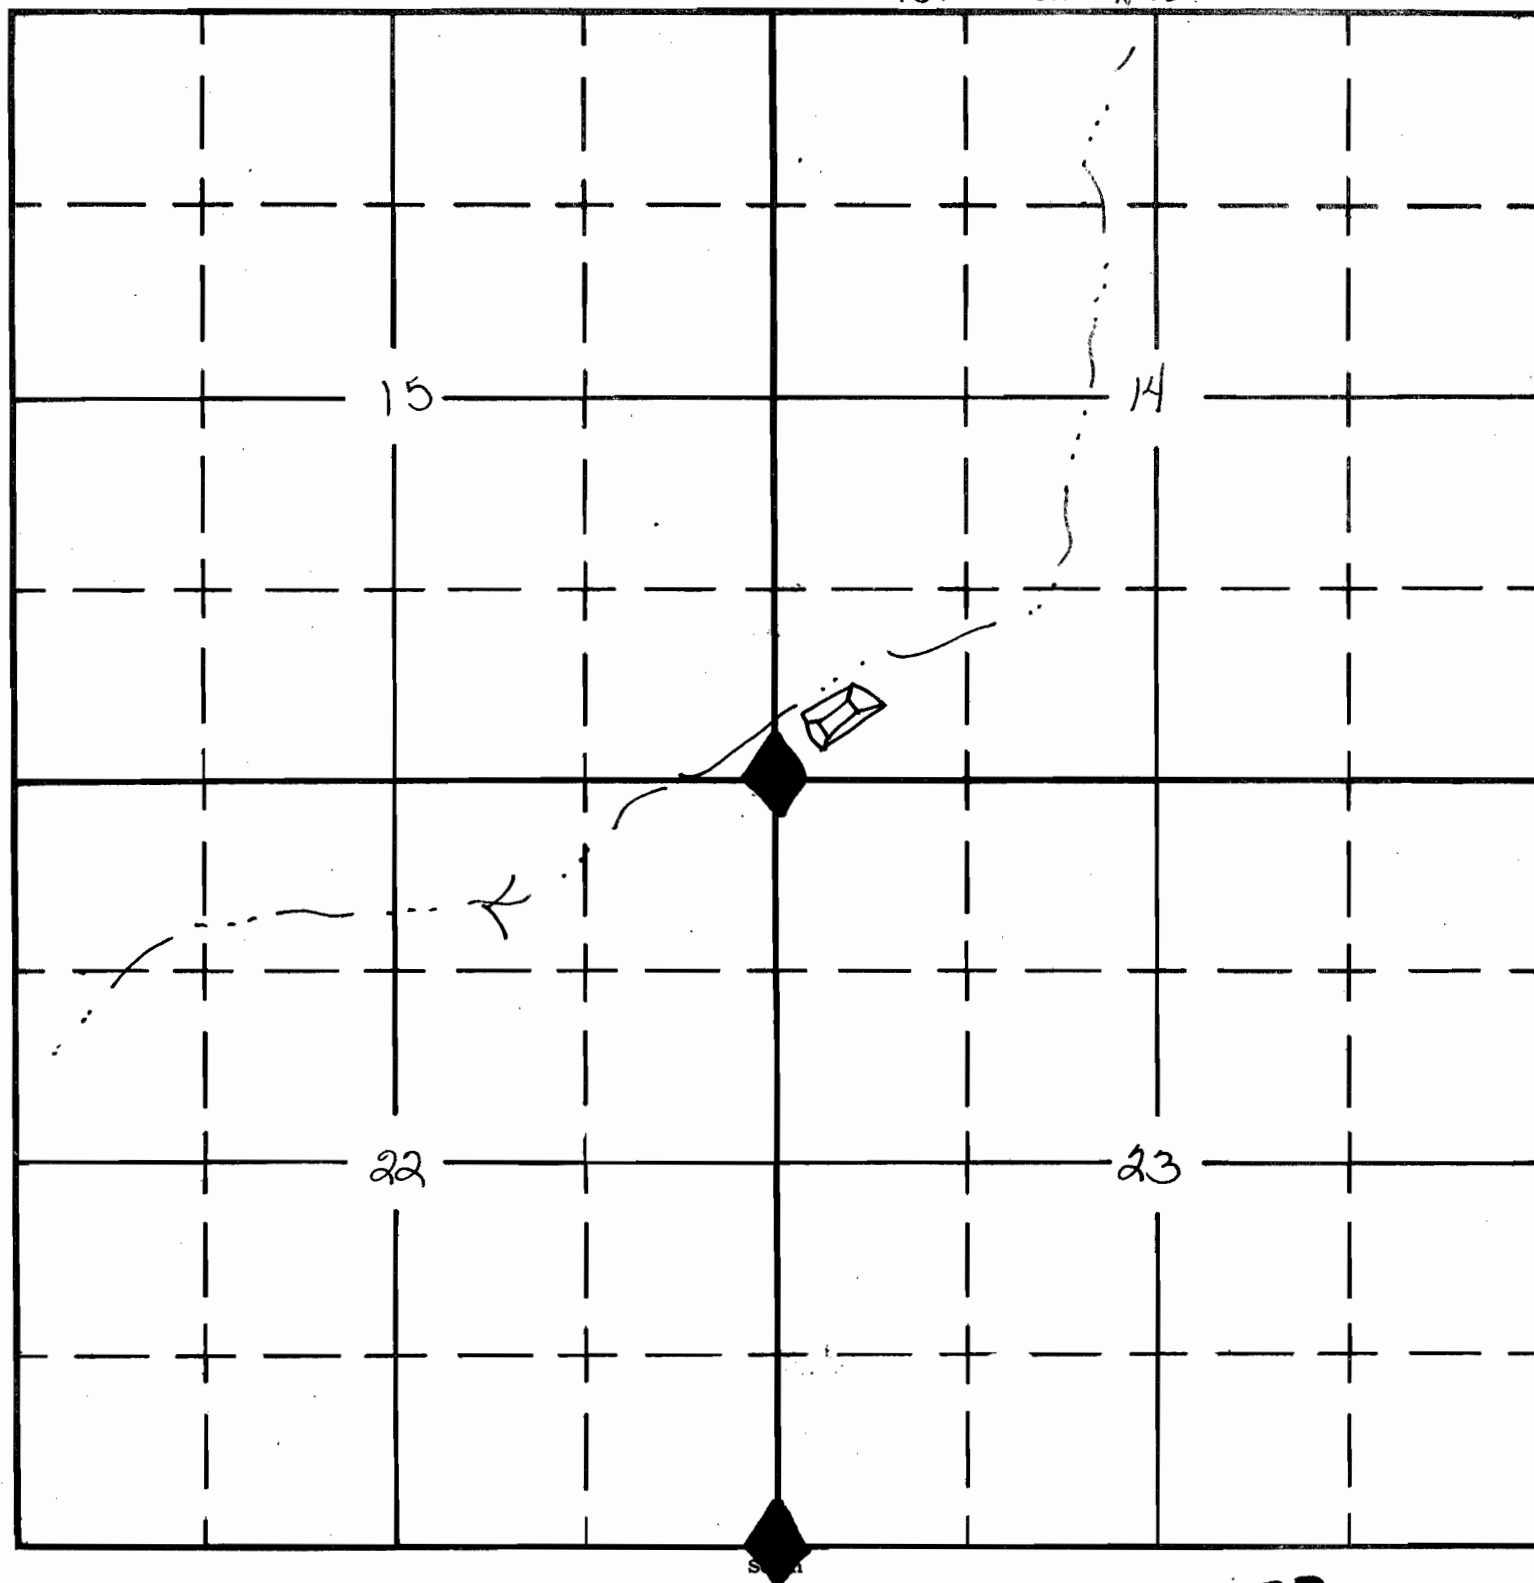

Application No. R66450
Permit No. R10225

RECEIVED
SEP 2 1983
LAND RESOURCES DEPT.
SALEM, OREGON