


SECTION

5 NW NW

TOWNSHIP 26 S., RANGE 28 E., W. M.

North #4317-Dead Bull Res.

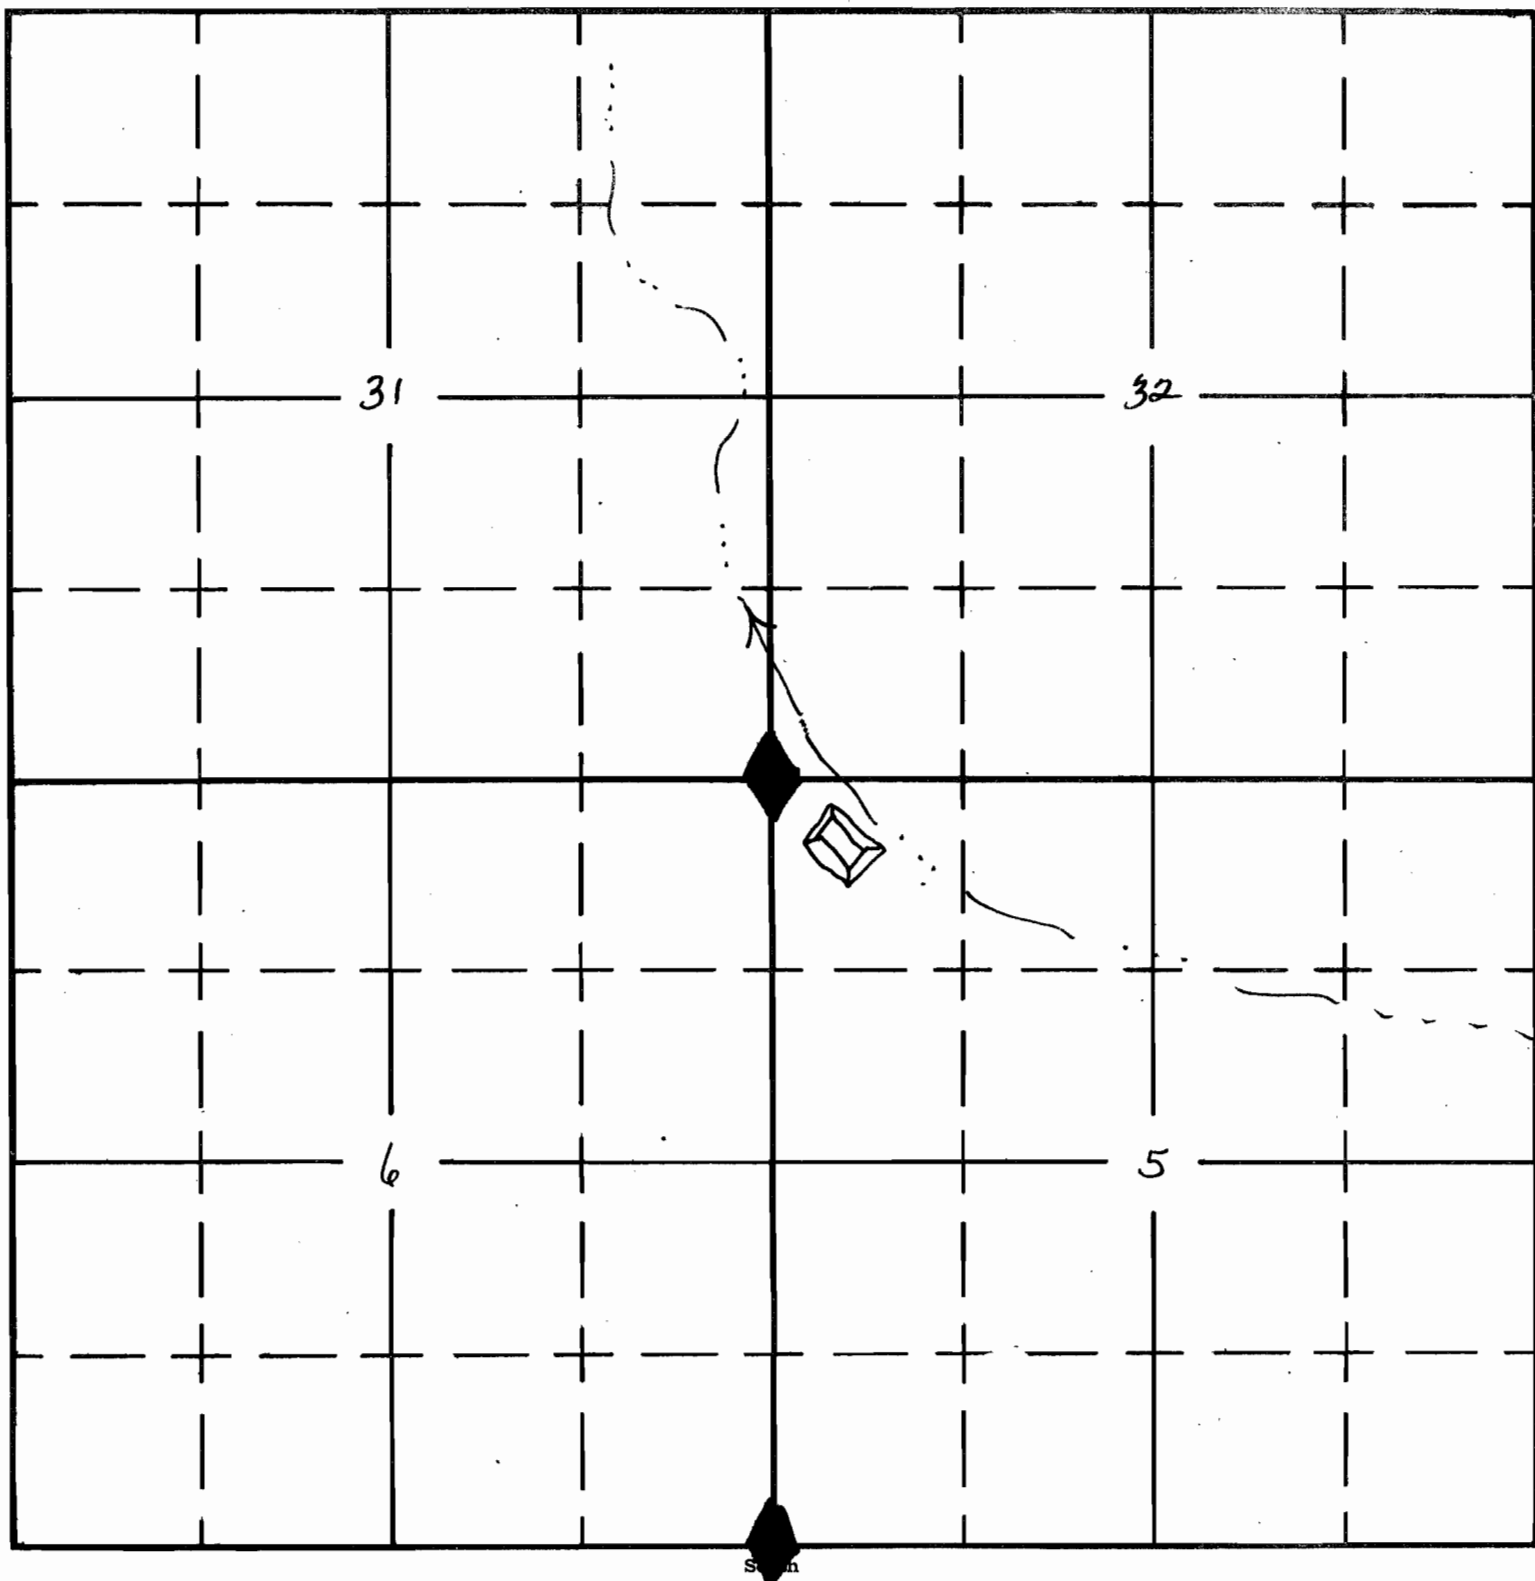

Application No. R66455
Permit No. R10229

SEP 2 1983
LAND RESOURCES DEPT.
SALEM, OREGON