


SECTION

36 NW SW

TOWNSHIP 24 S, RANGE 24 E, W. M.

North

#4981 - Cecil Res.

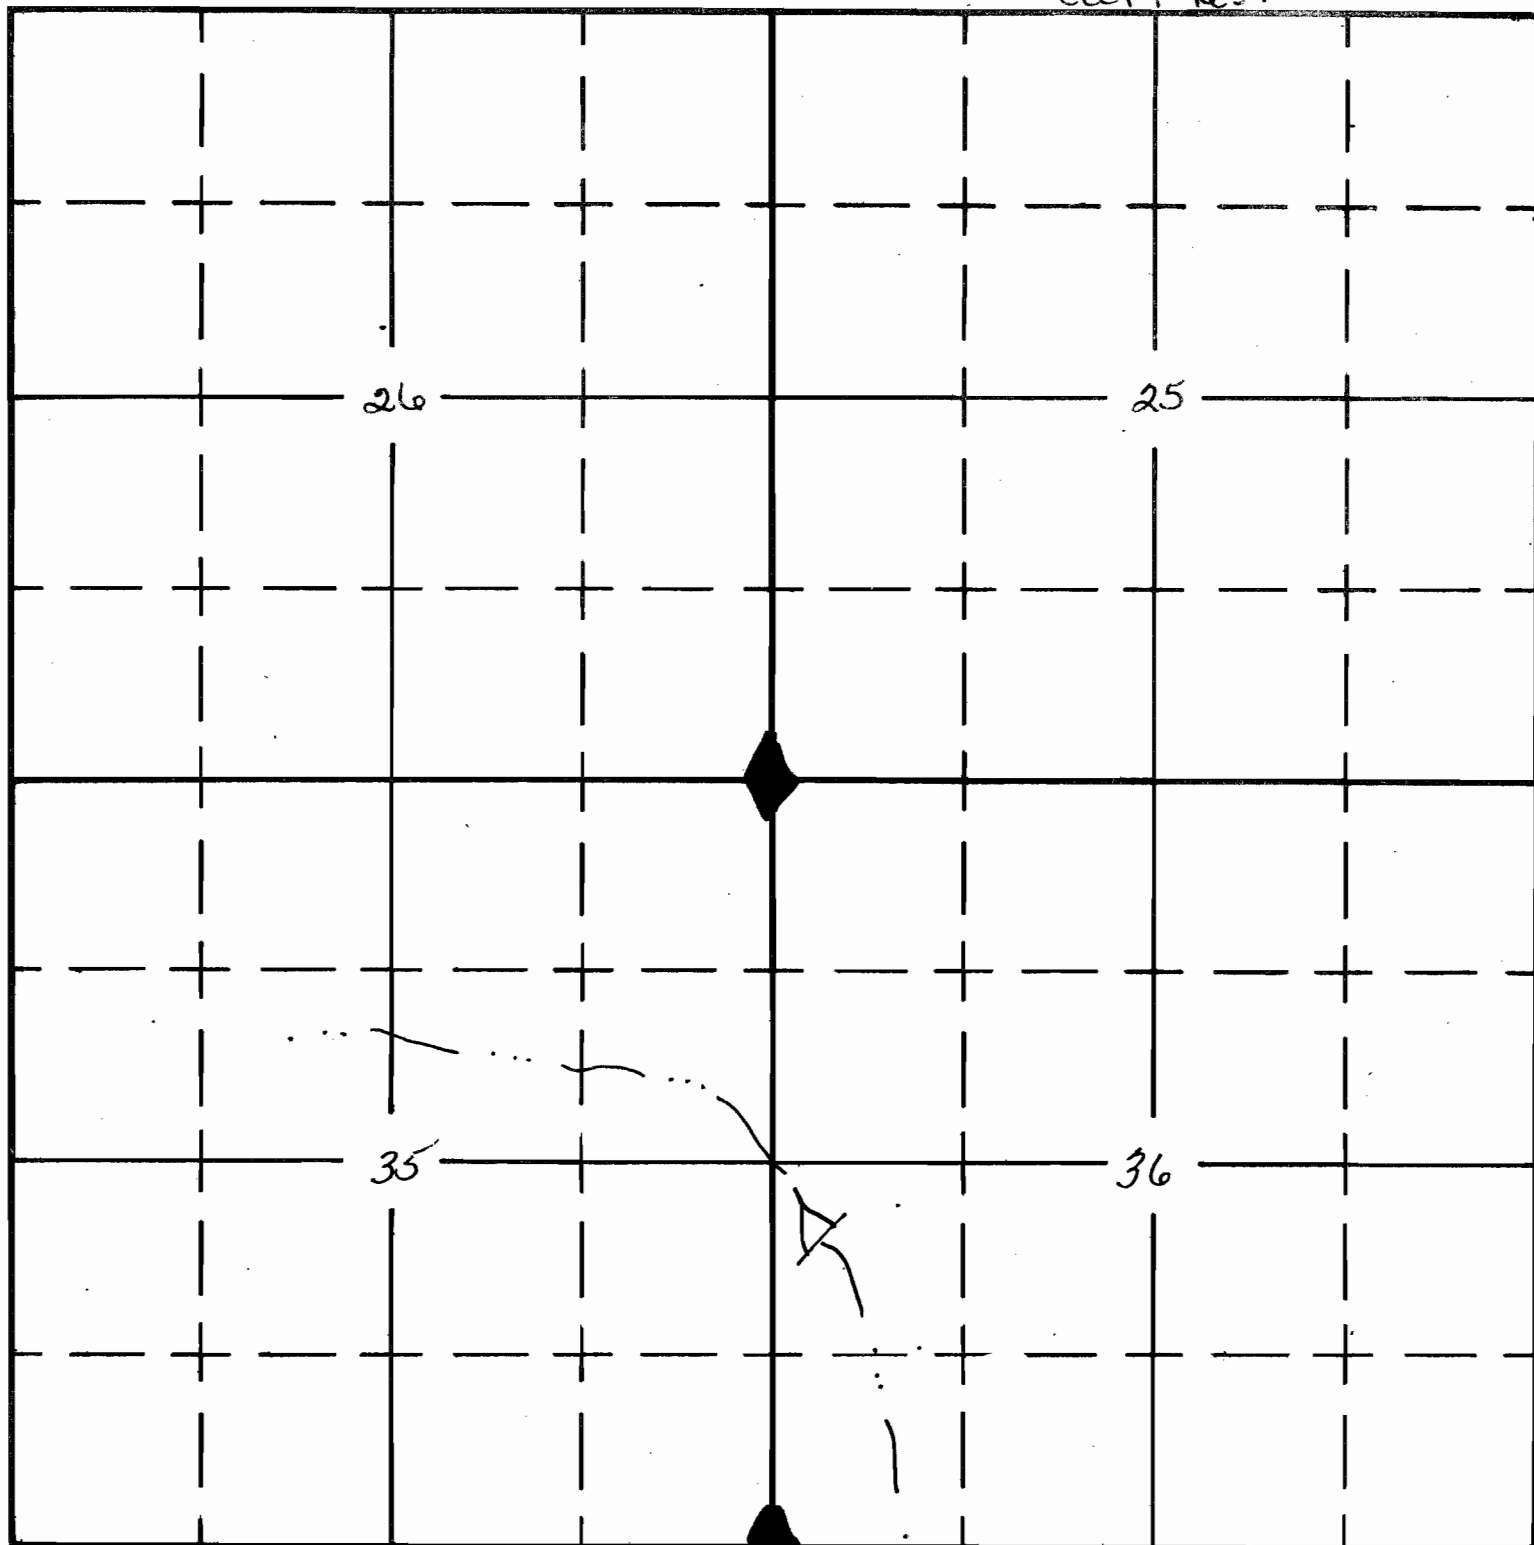

South

Application No. R66458
Permit No. R10232

SEP 2 1983
RESOURCES DEPT.
SALEM, OREGON