


SECTION

13 SE SW

TOWNSHIP 24 S, RANGE 24 E, W. M.

North #4798-Mosquito Res.

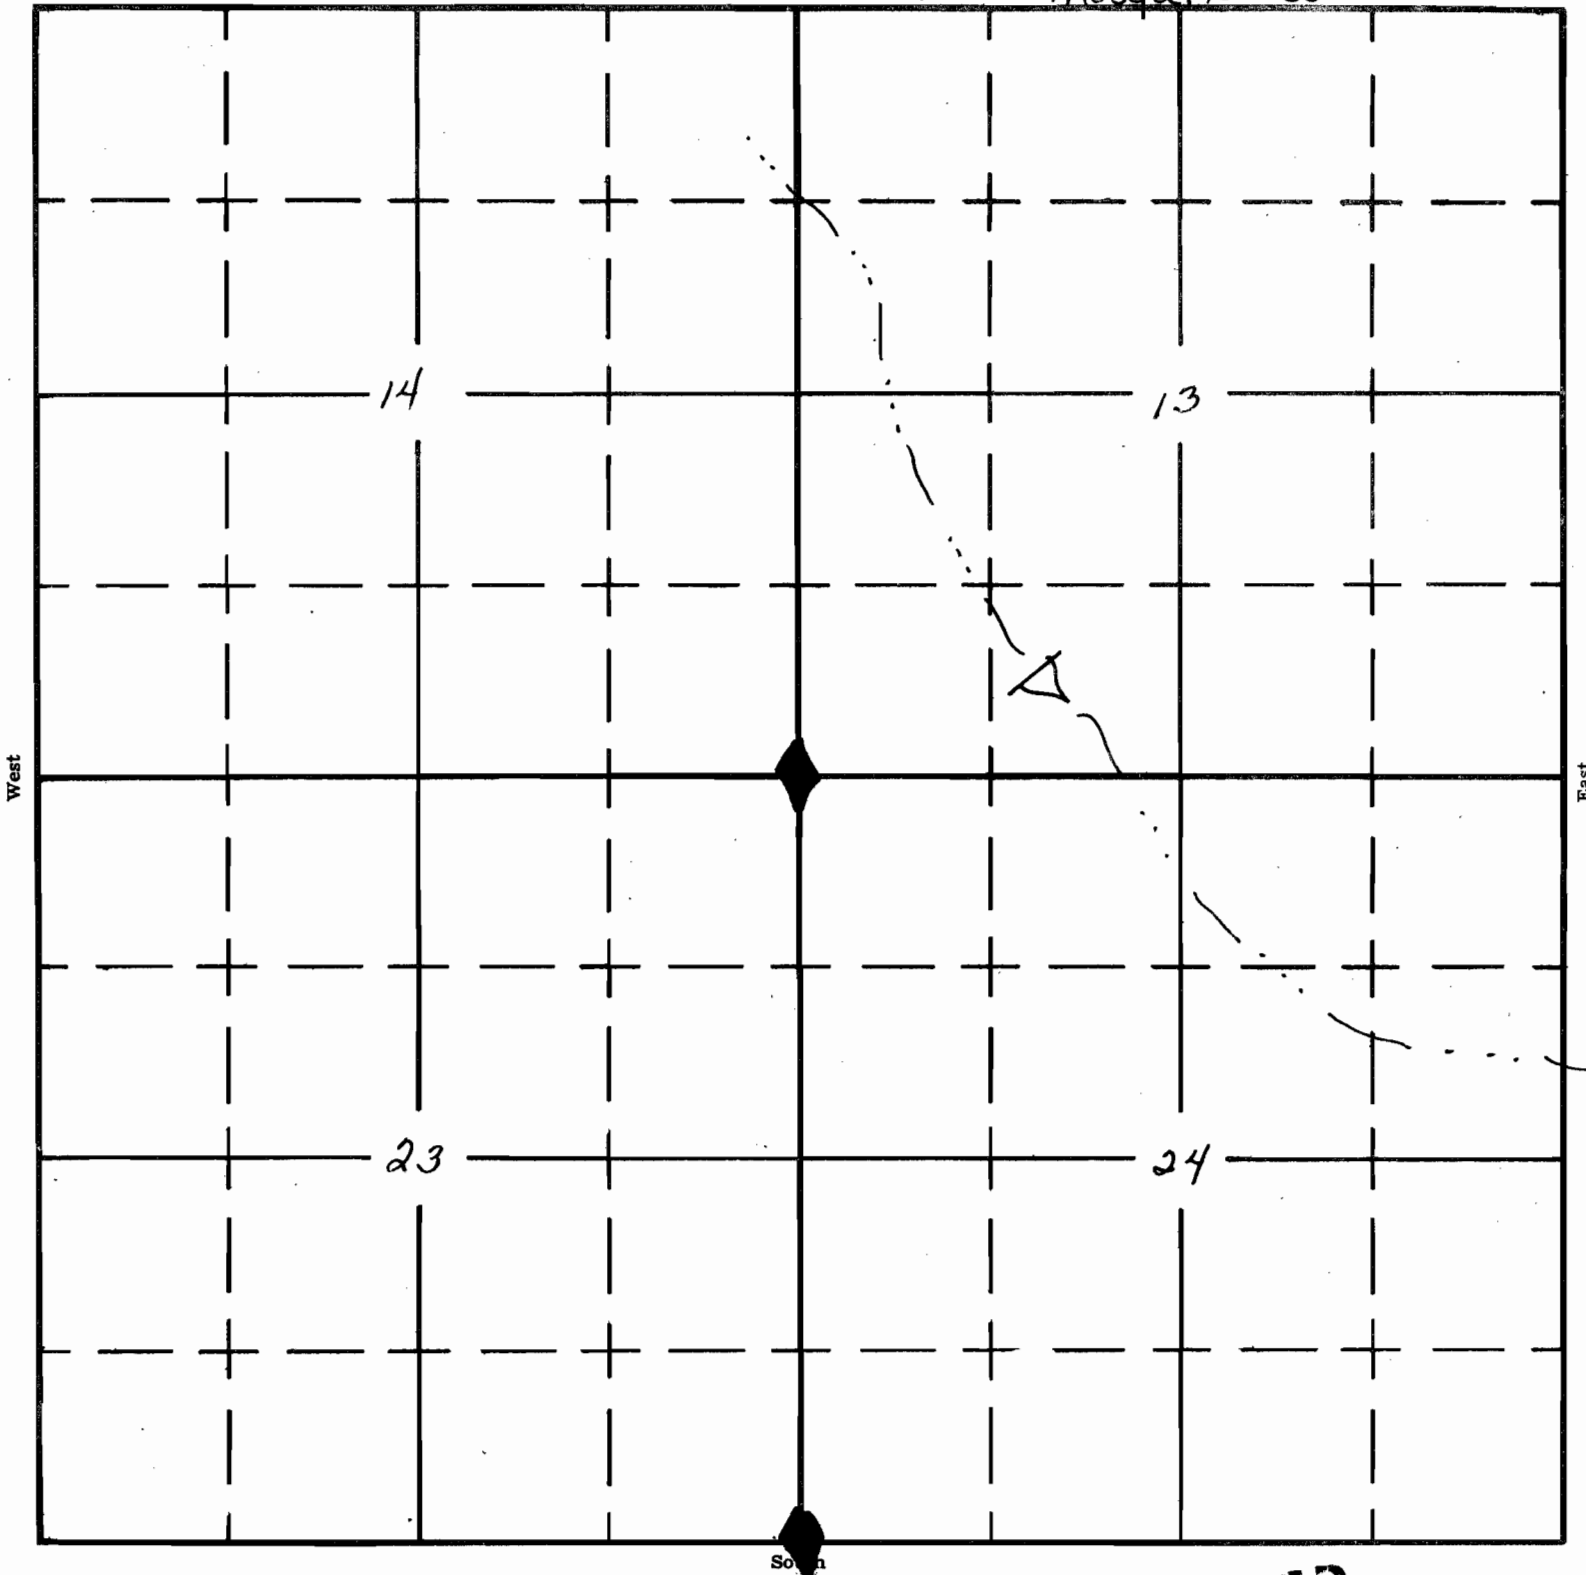

Application No. R66459
Permit No. R10233

SENT 11983
RECEIVED CES DEPT.
SALEM, OREGON