


SECTION

17 SE SE

TOWNSHIP 22 S, RANGE 25 E, W. M.

North

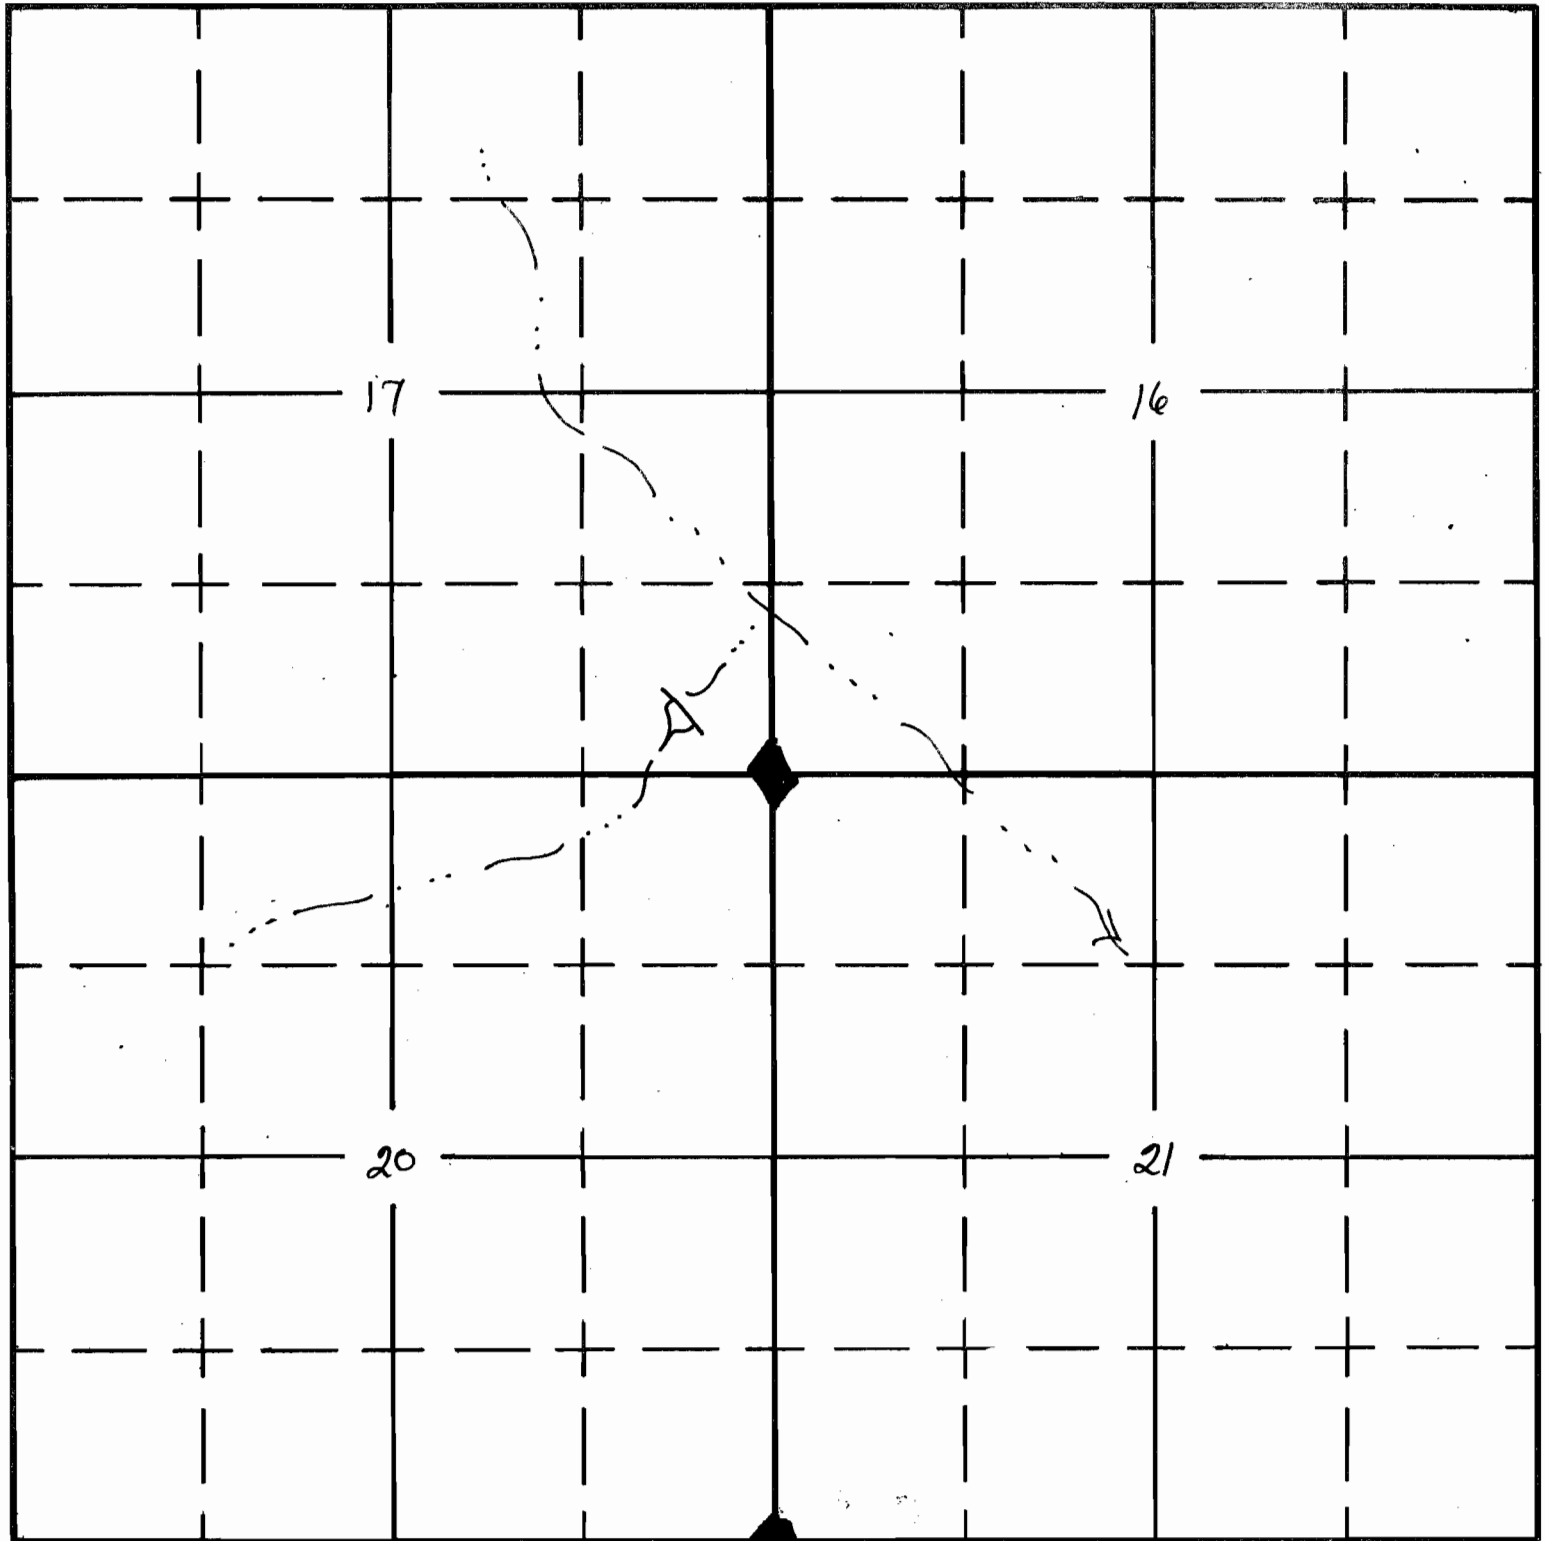

Application No. R66462
Permit No. R10236

SL. 2 1983
CES DEPT.
SALEM, OREGON