


SECTION

7 SW SW

TOWNSHIP 29 S, RANGE 27 E, W. M.

North

0918 - N. Fence Res.

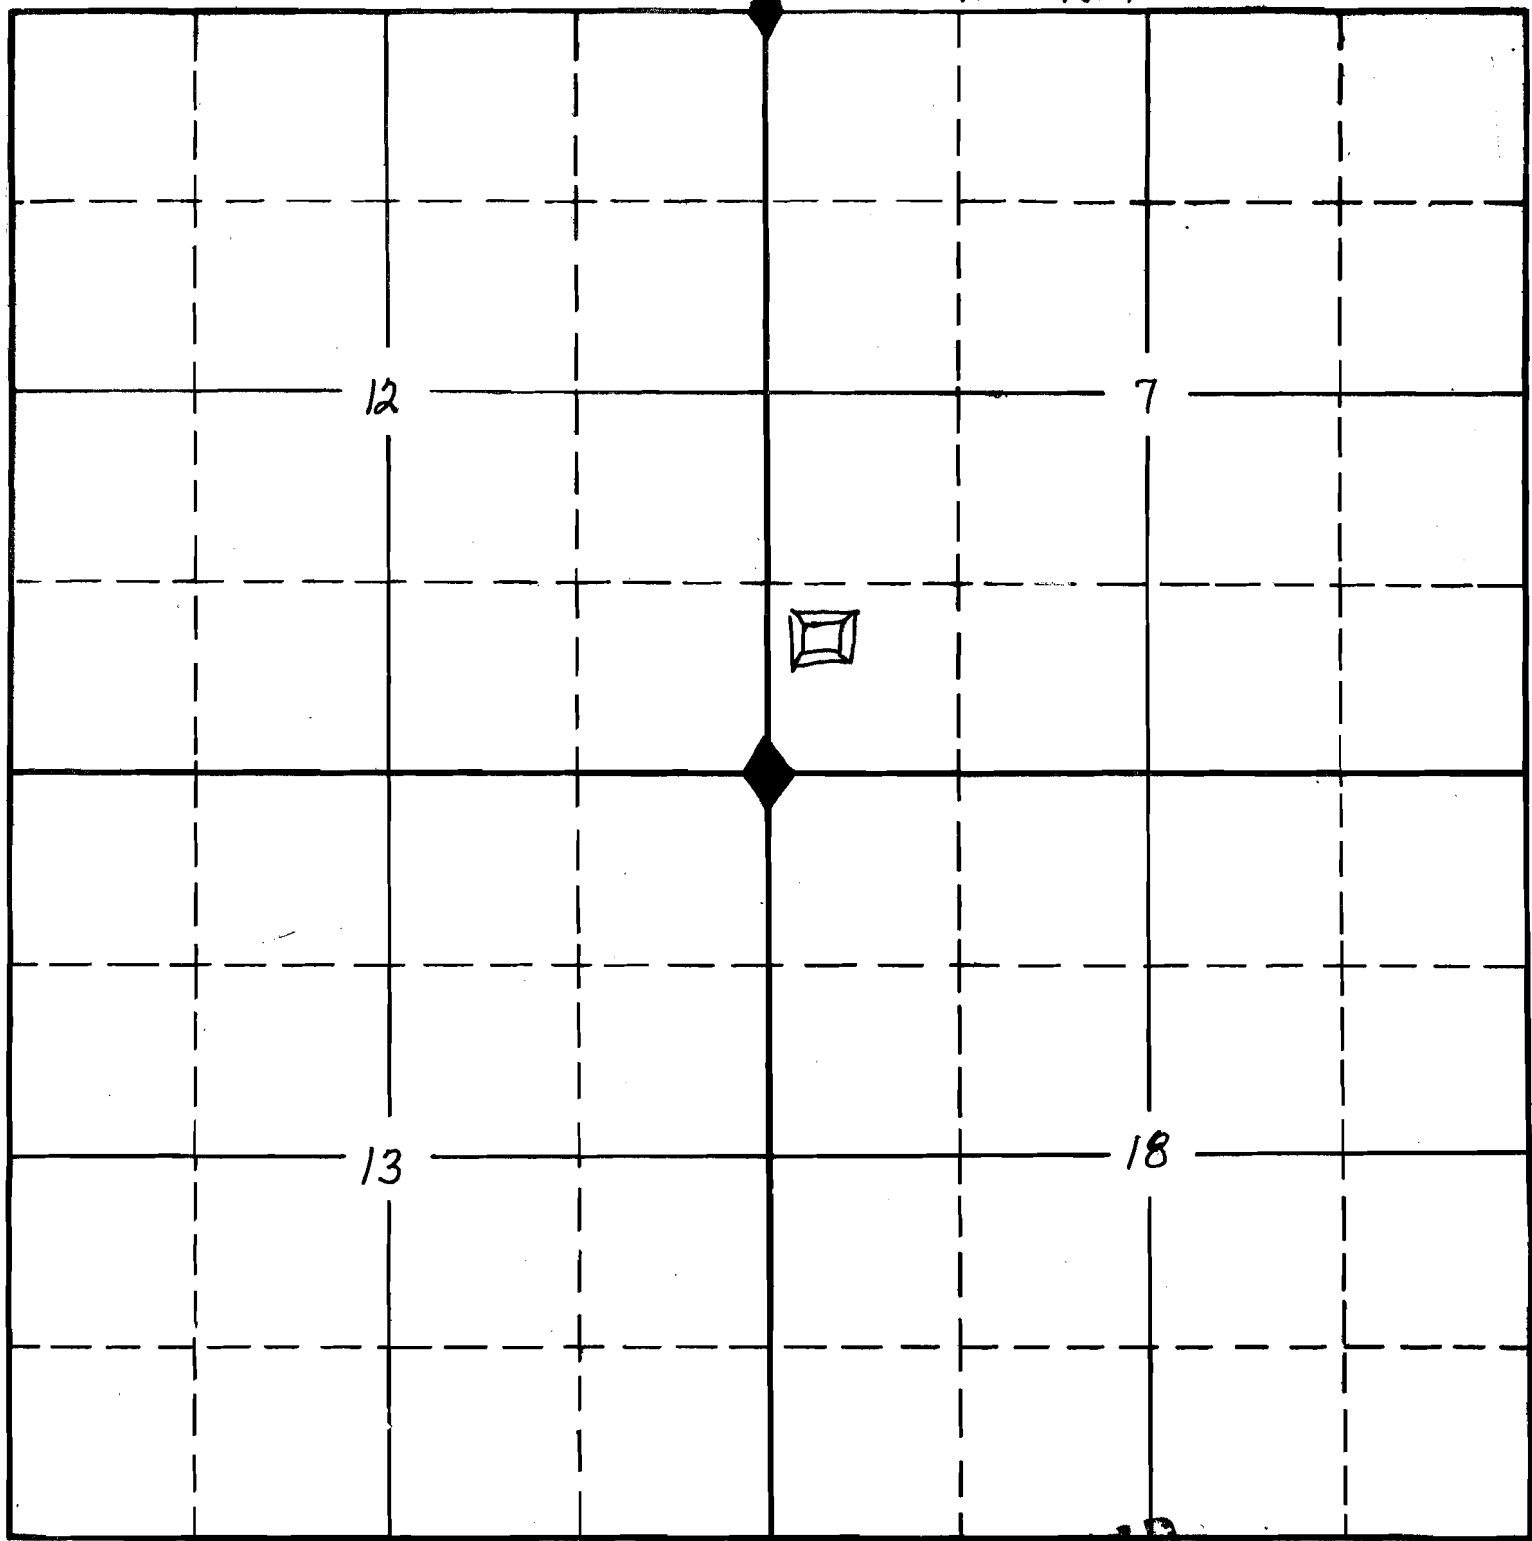

South

**Application No. R66474**  
**Permit No. R10216**

SLIP 11988 APPLICATION No.  
CORRECTION DEPT. PERMIT No.  
SALEM, OREGON