


SECTION 33

NE NE

5353-Down pour Waterhole

TOWNSHIP 28 S, RANGE 37 E, W. M.

North

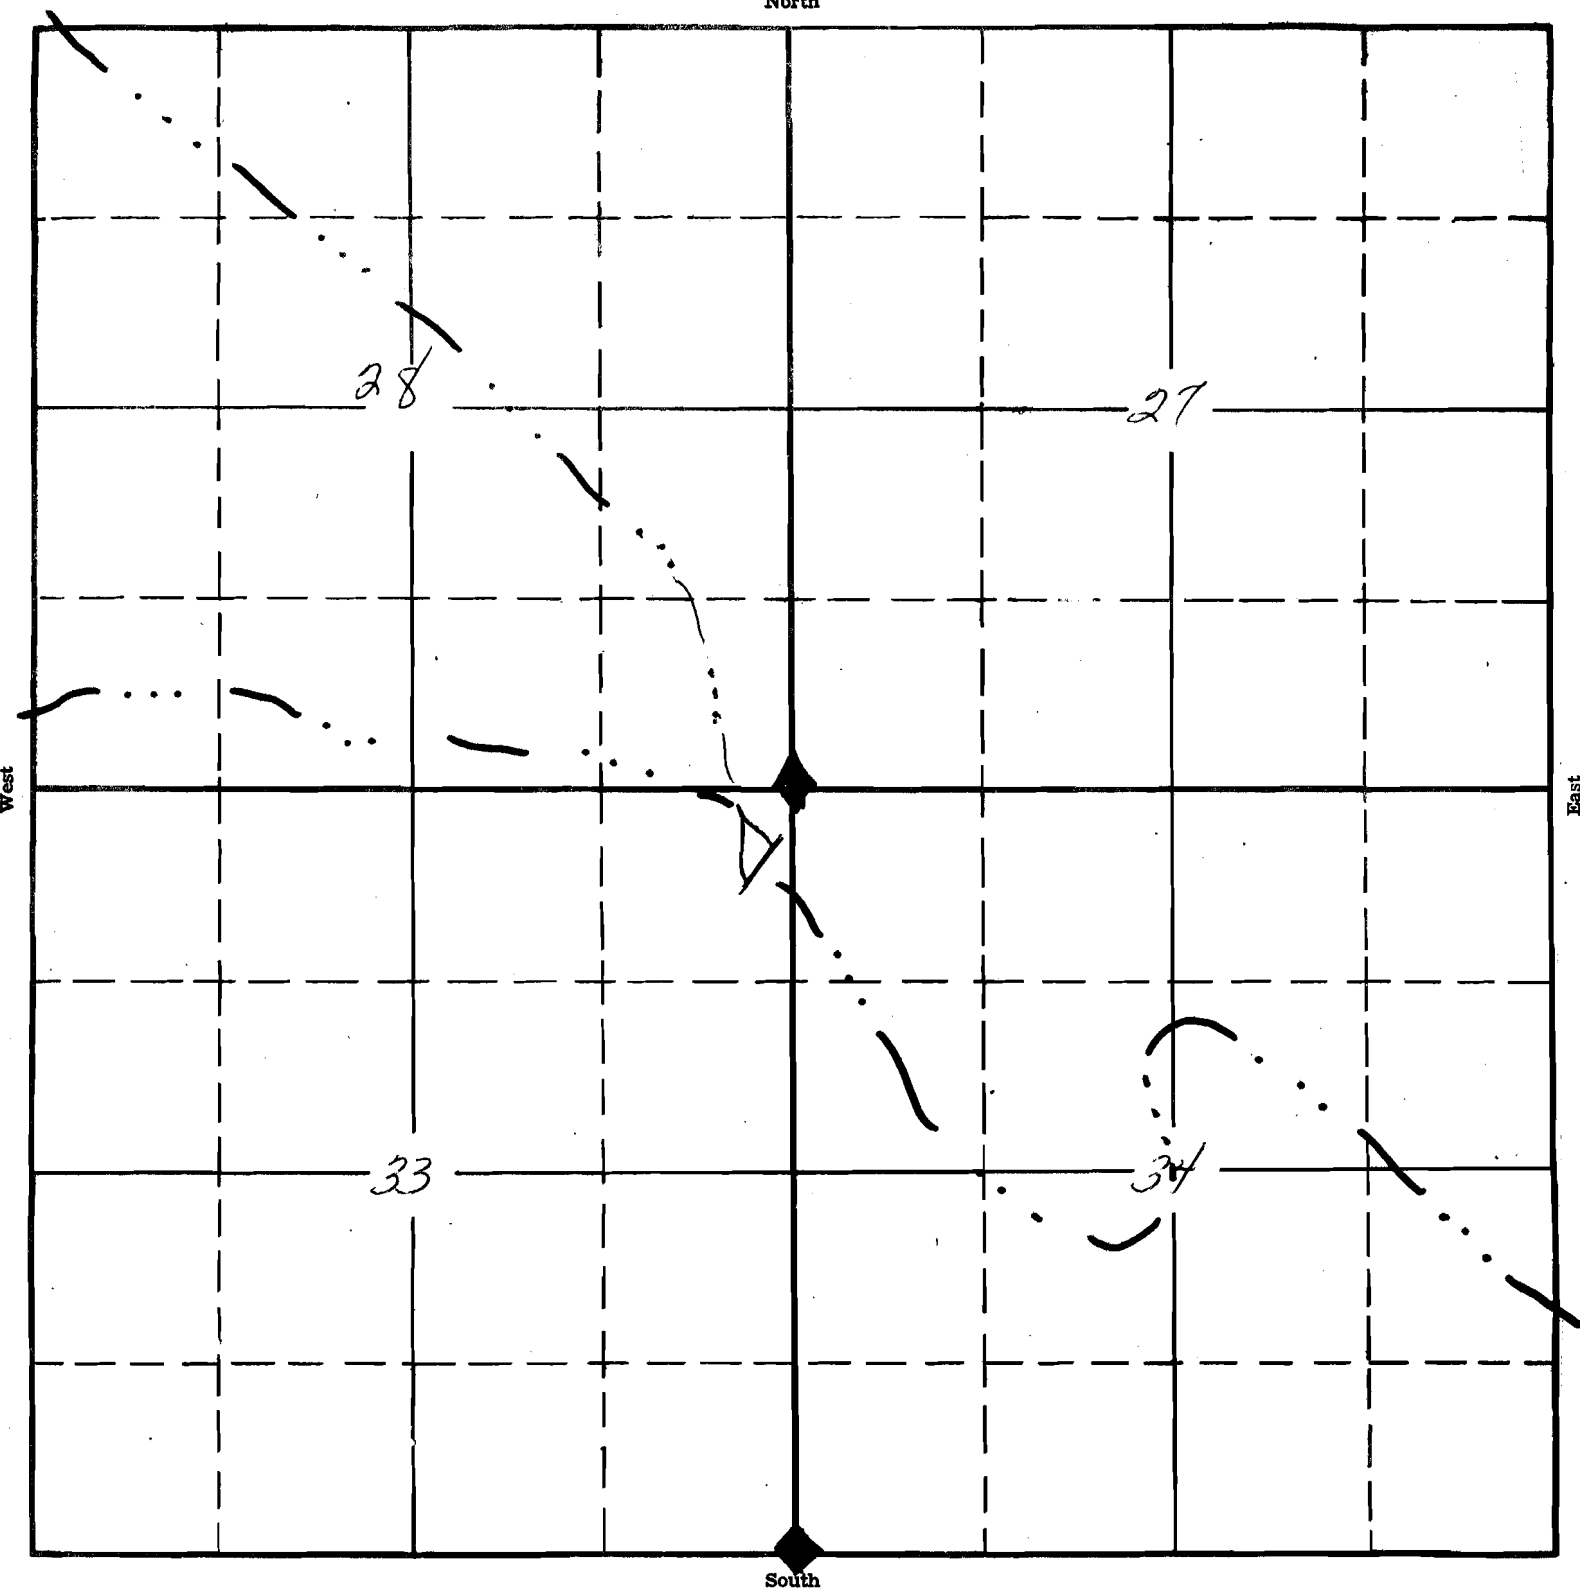

Application No. R66475
Permit No. R10217

APPLICATION No.
PERMIT No.
SEP 21 1983
LAND RESOURCES DEPT.
SALEM, OREGON