


SECTION 01
NW SW

#4612 - Cloud Res.

TOWNSHIP 29 S, RANGE 35 E, W. M.

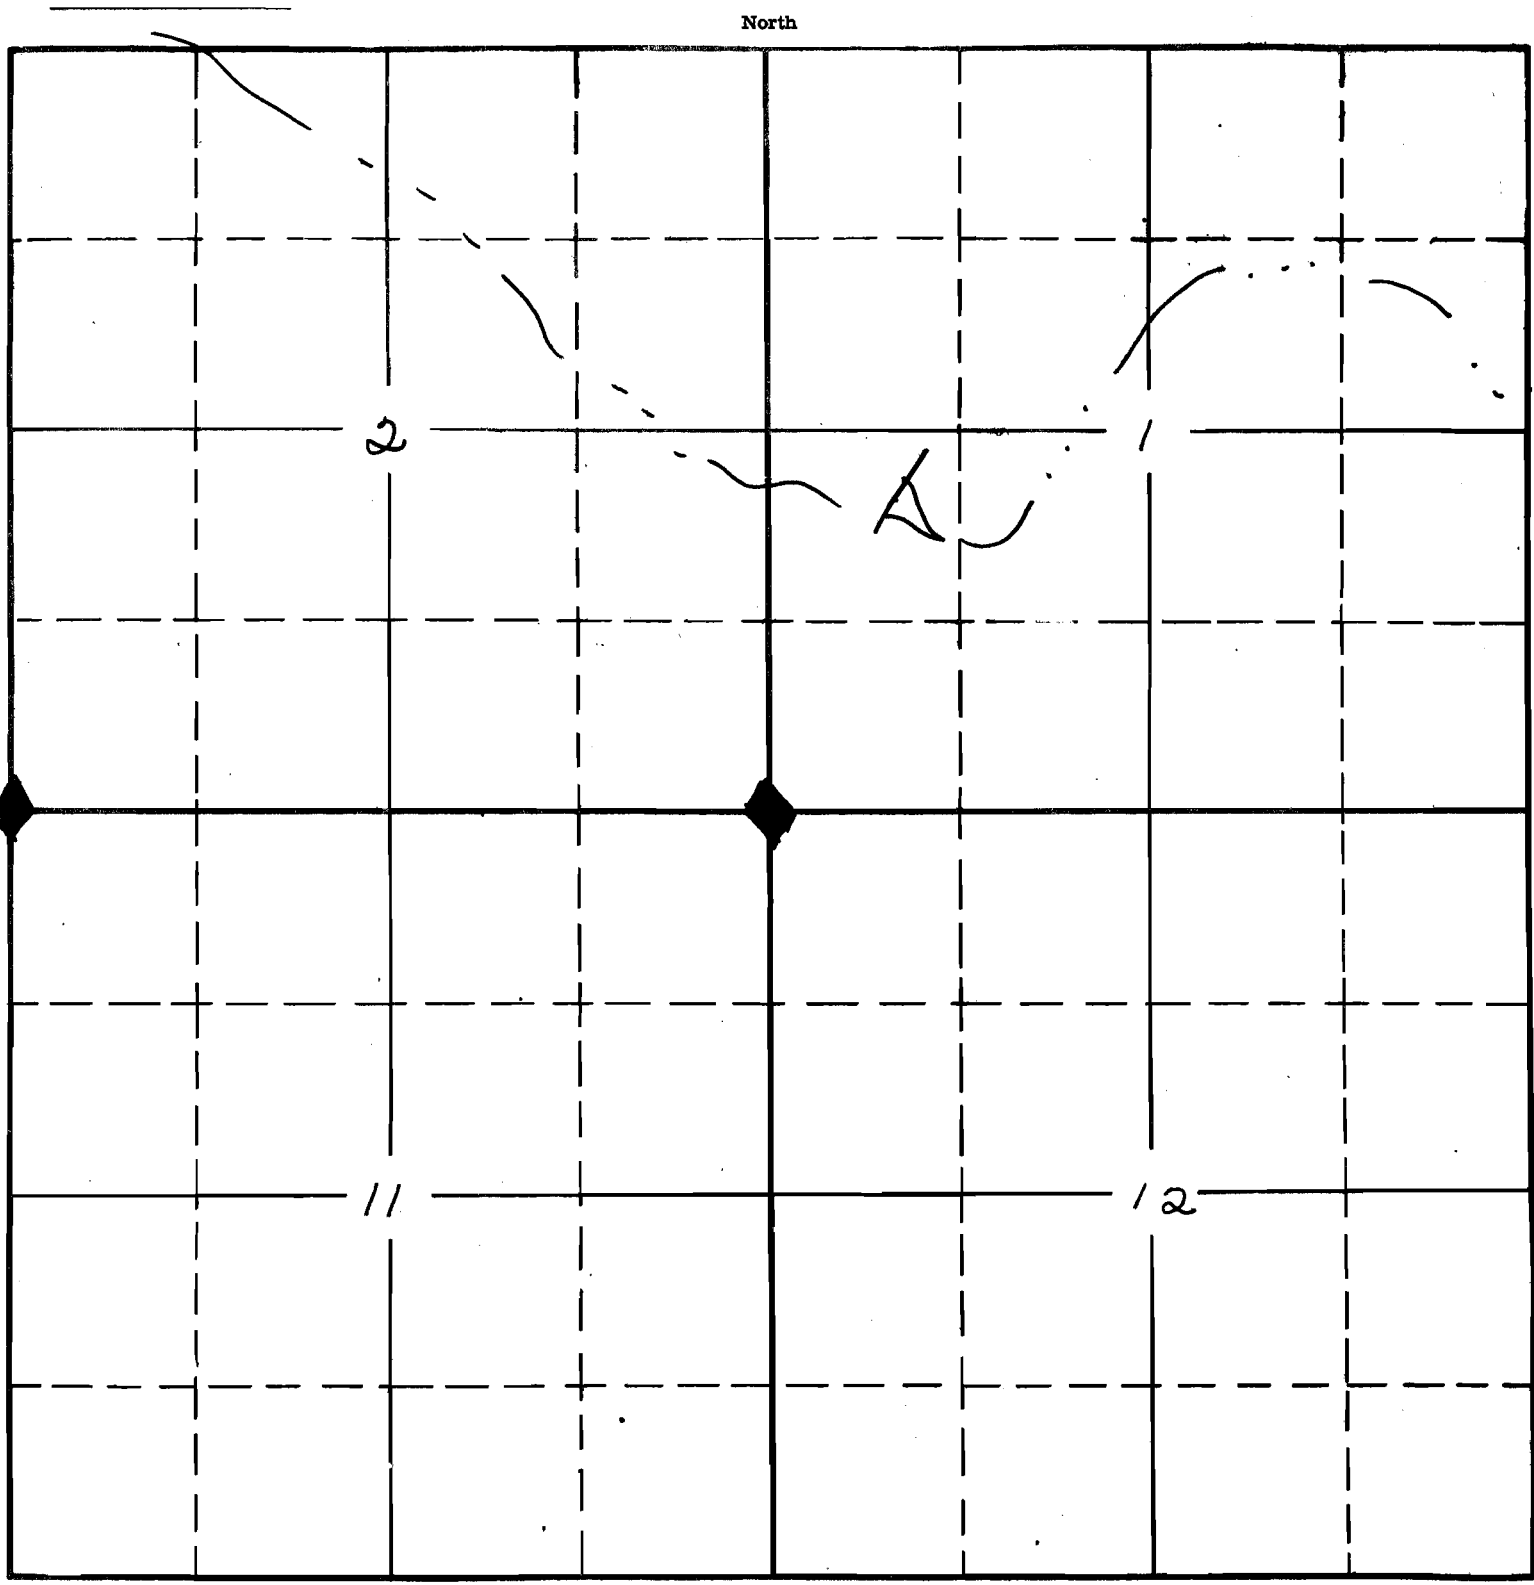

Application No.
Permit No.

R66505
R10268

SLD 11983
SALM. OREGON

APPLICATION No.
PERMIT No.