


SECTION 8
NWSE

5350 - Sidekick Res.

TOWNSHIP 29 S, RANGE 37 E, W. M.

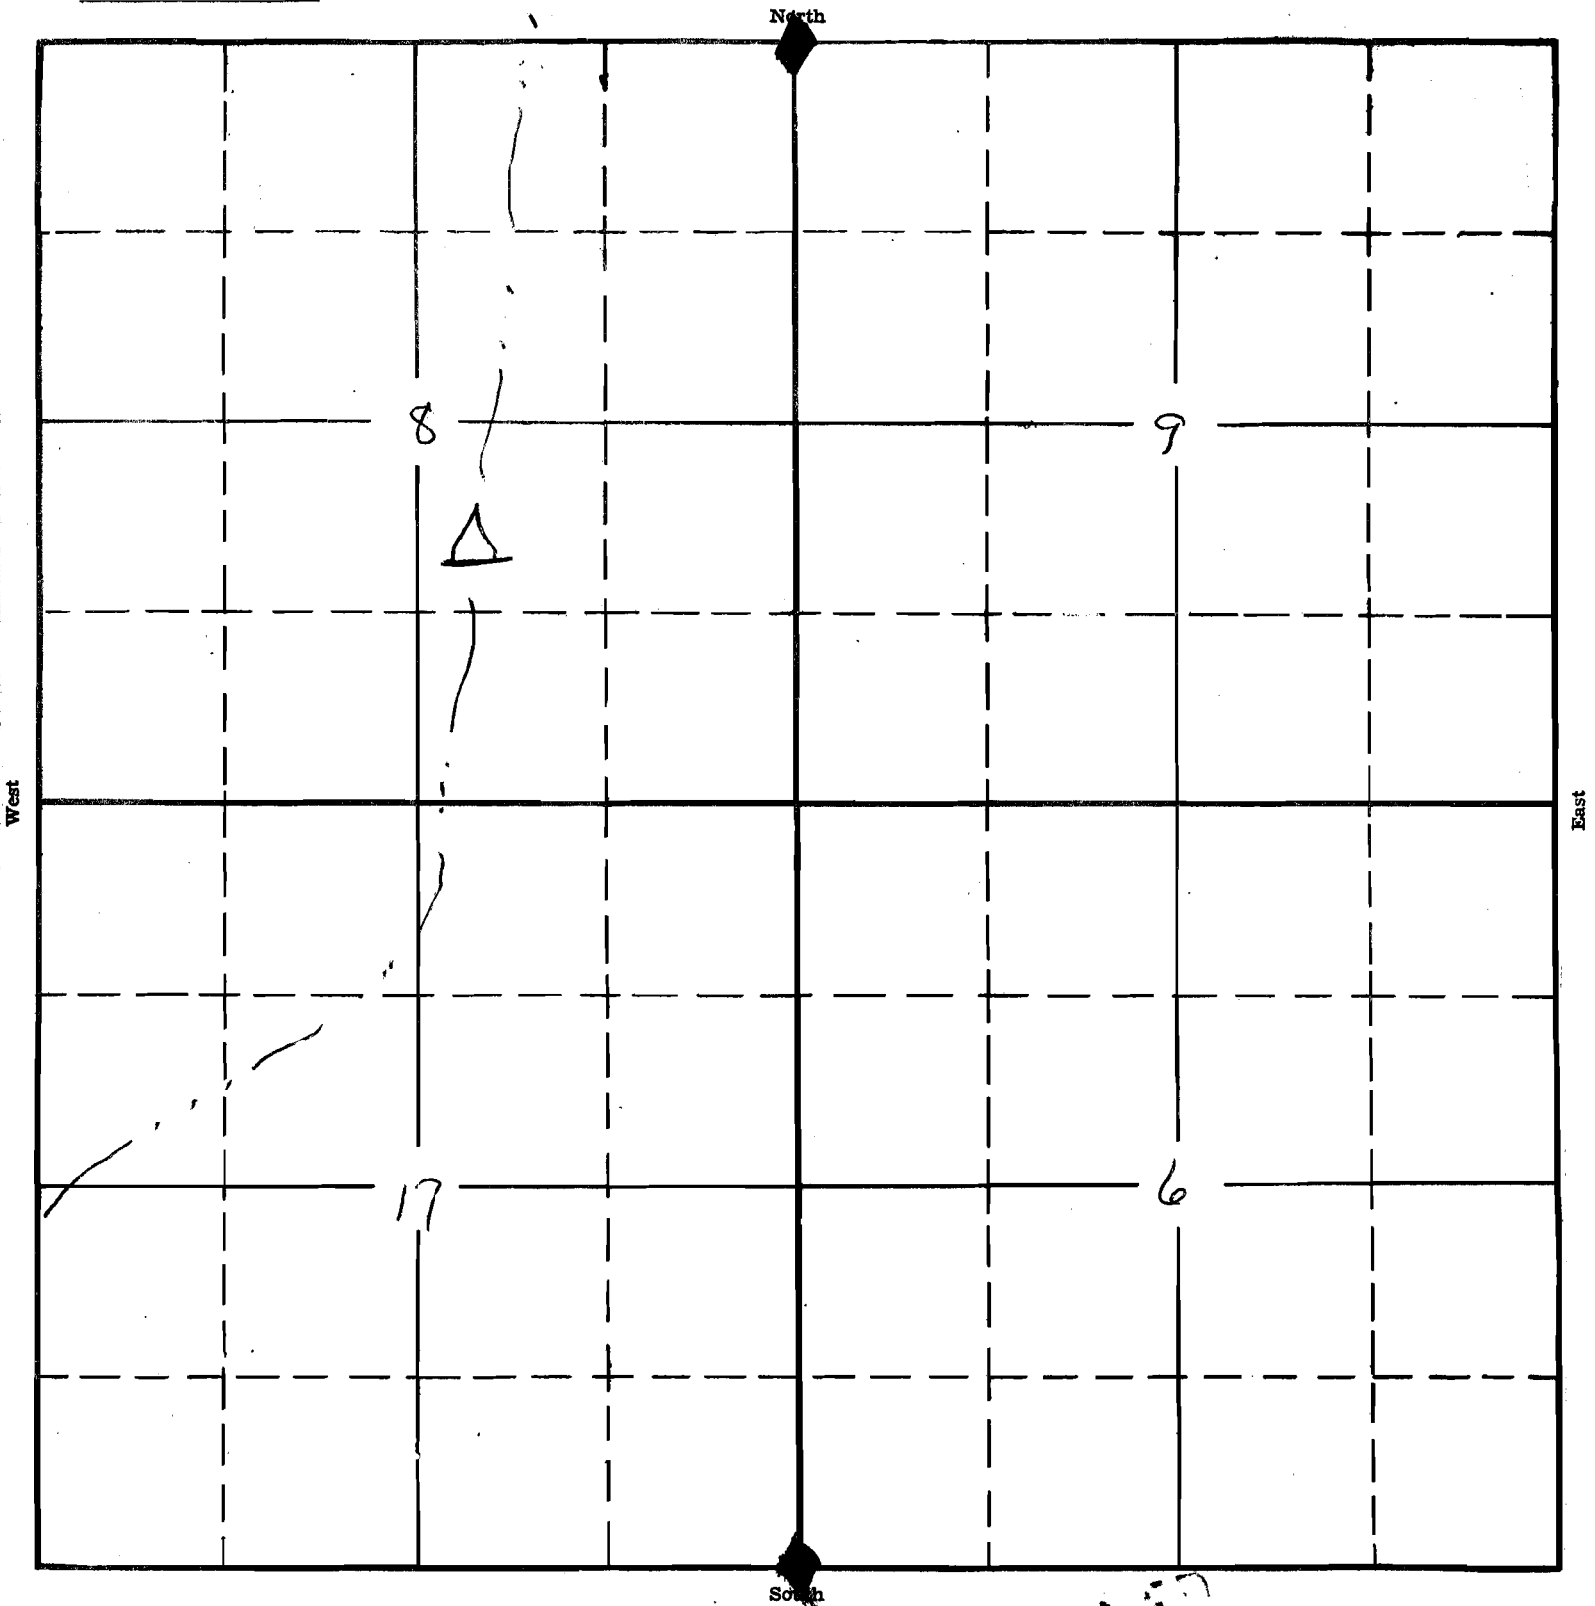

Application No. R66308
Permit No. R10271
DEC 20 1983

APPLICATION No.
DEC 21 1983
PERMIT No.